



2019 © Sapphire Balconies Ltd
Do not scale from this drawing.
All dimensions in millimetres
unless stated otherwise.
We reserve the right to alter
detail to suit production.
All tolerances to be +/- 3mm
unless otherwise specified.
Drawings to be read in conjunction
with specification and detail sheets.

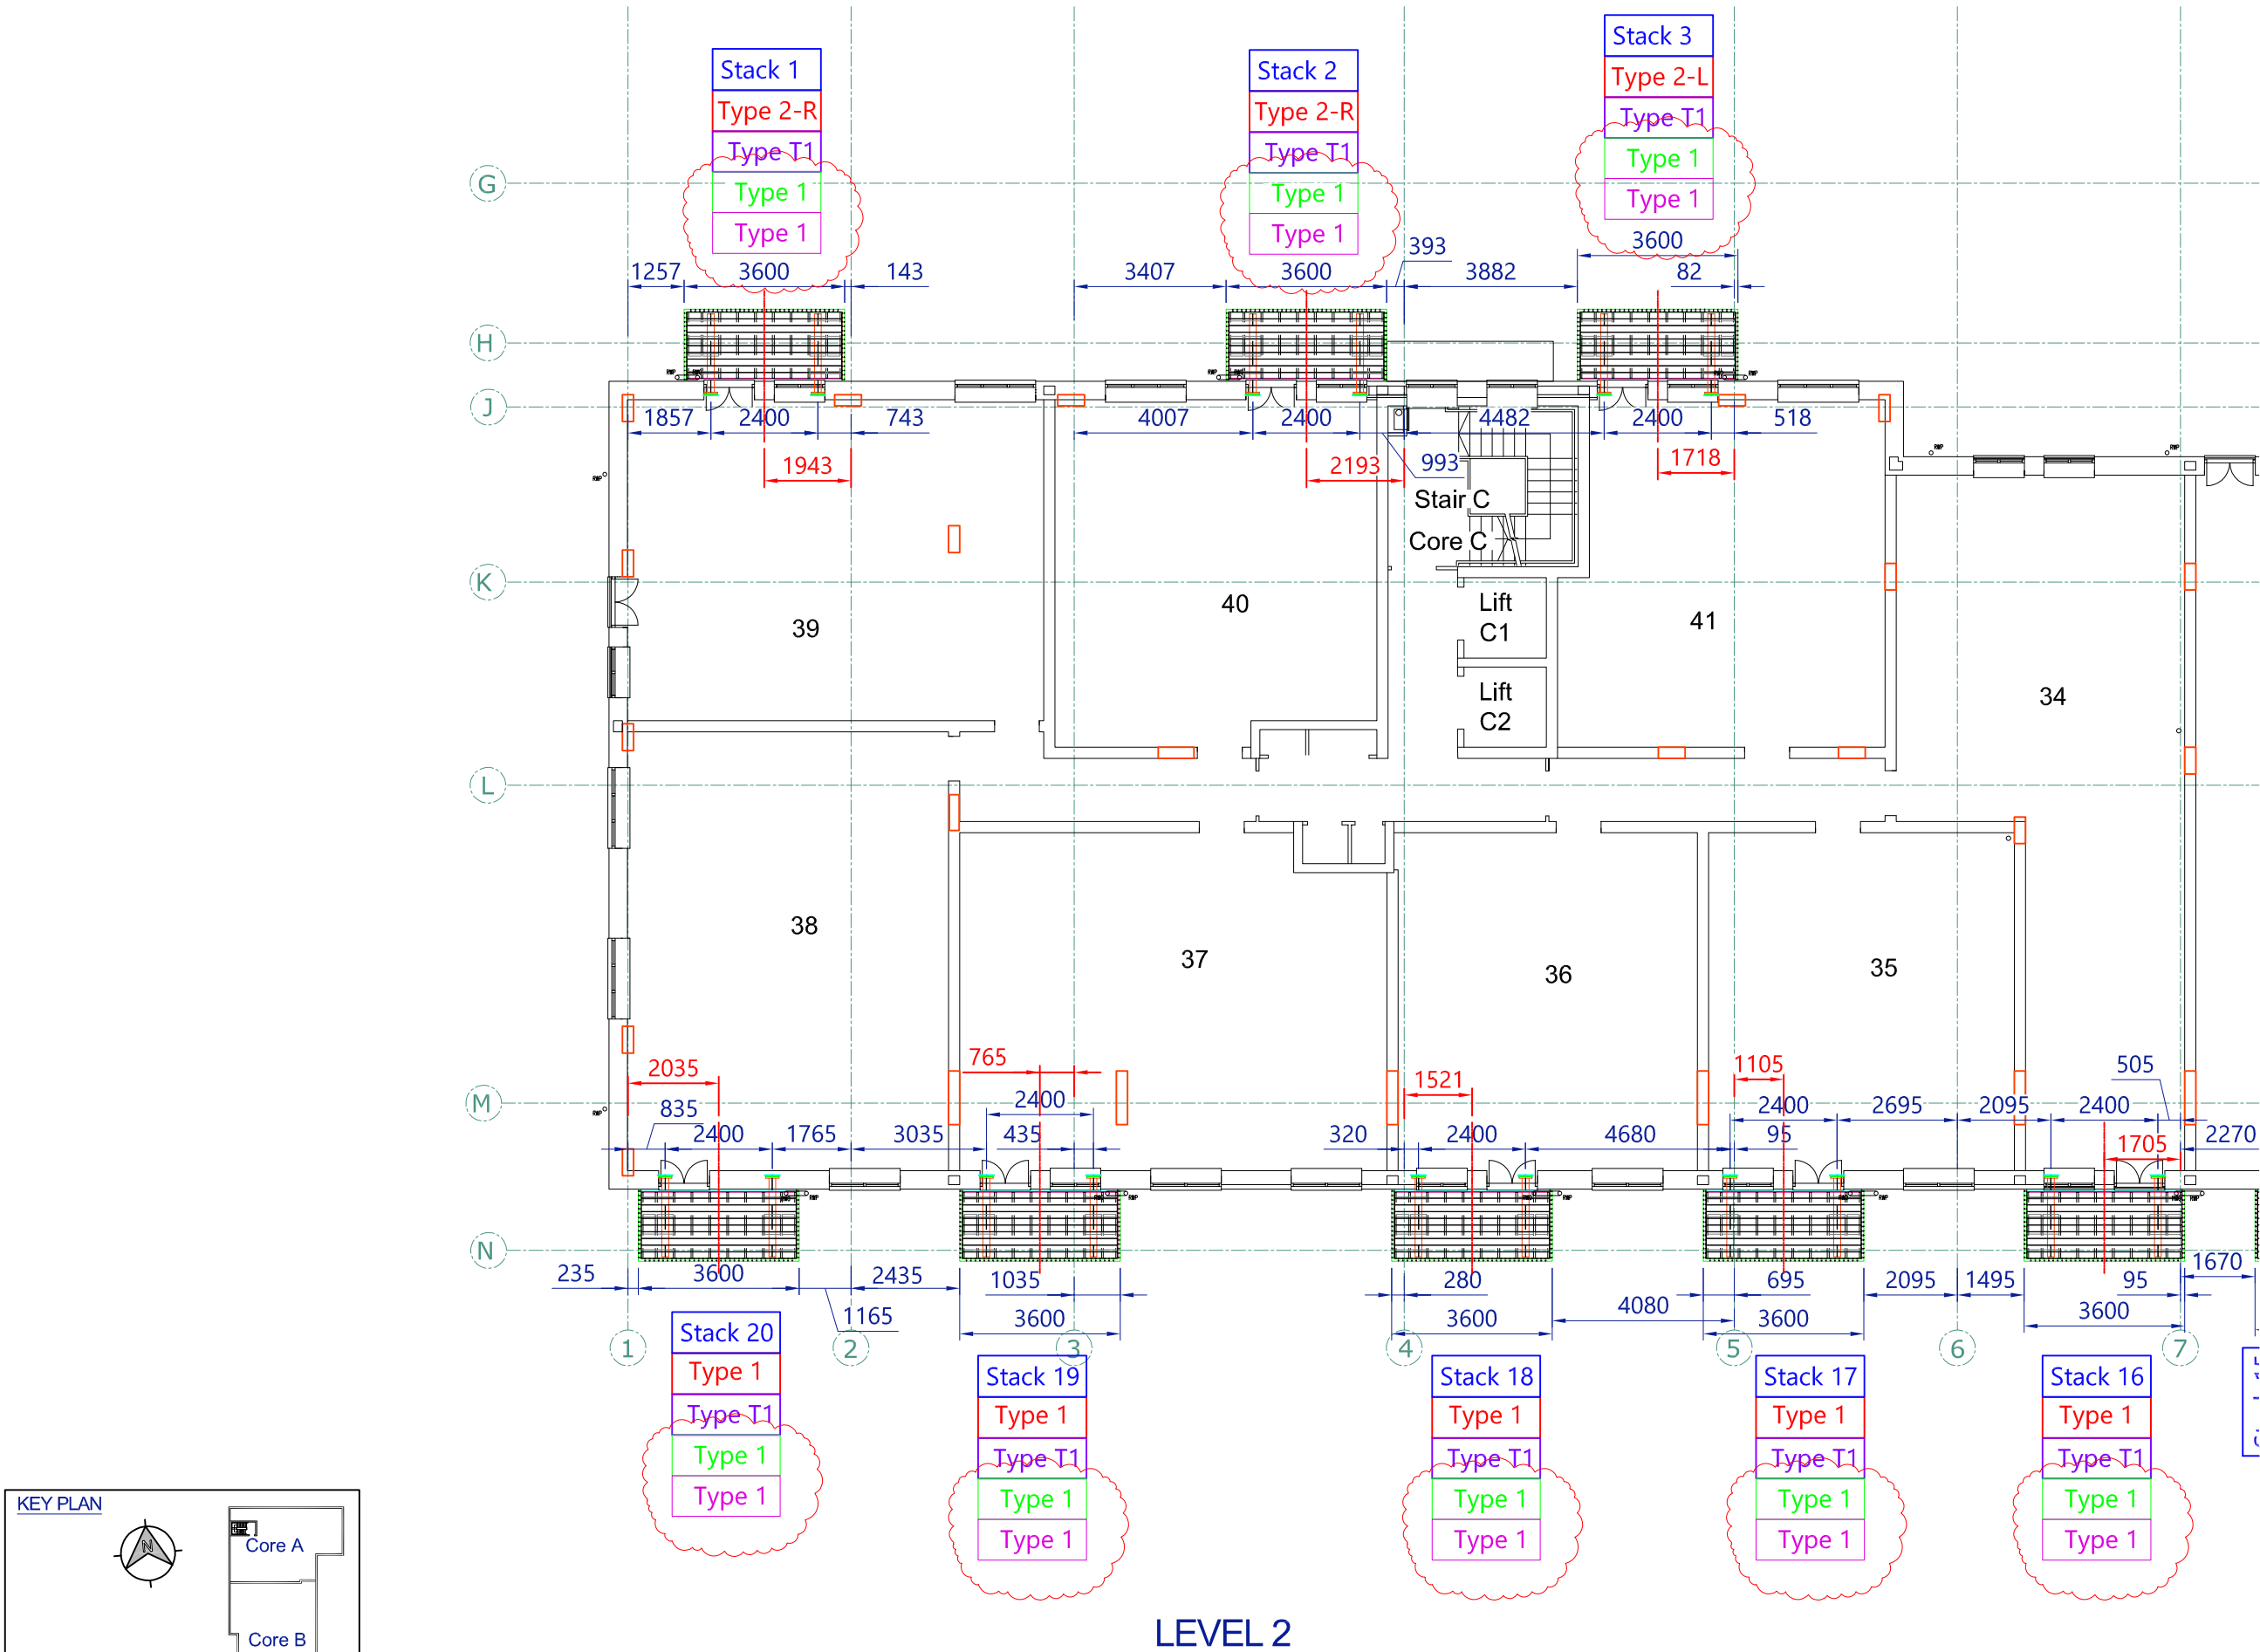

Balcony Type	Quantity
Type 1	5
Type 2-L	1
Type 2-R	2
Total	8

Key

Stack Ref.
Balcony Type
Template Type
Bracket Type
Arm Type

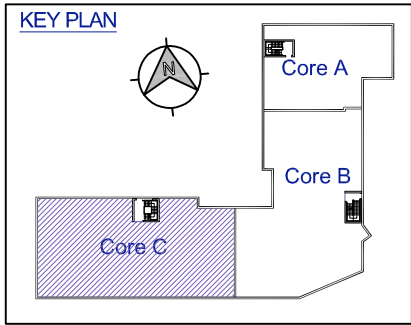

E	08.07.20	For Construction
D	05.11.19	For Construction
C	11.10.19	As per markup
B	21.09.19	Issue for construction
A	19.08.19	Issued for Approval
Rev	Date	Description

Project
Blyth Road

Location
Block-C Level -2

Drawing Title
GA Plan



www.sapphire.eu.com
call 0844 88 00 553

Drawn by ARD Checked by SL Scale @ A3
1:150

Project Ref. 530919 Drawing No. - GA-08 - E Revision