
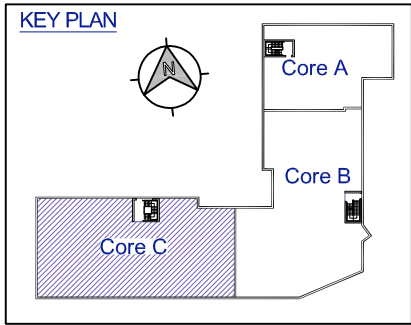


2019 © Sapphire Balconies Ltd  
Do not scale from this drawing.  
All dimensions in millimetres  
unless stated otherwise.  
We reserve the right to alter  
detail to suit production.  
All tolerances to be +/- 3mm  
unless otherwise specified.  
Drawings to be read in conjunction  
with specification and detail sheets.

| Balcony Type | Quantity |
|--------------|----------|
| Type 1       | 2        |
| Type 2-L     | 1        |
| Type 2-R     | 1        |
| Total        | 4        |

Key

|               |
|---------------|
| Stack Ref.    |
| Balcony Type  |
| Template Type |
| Bracket Type  |
| Arm Type      |

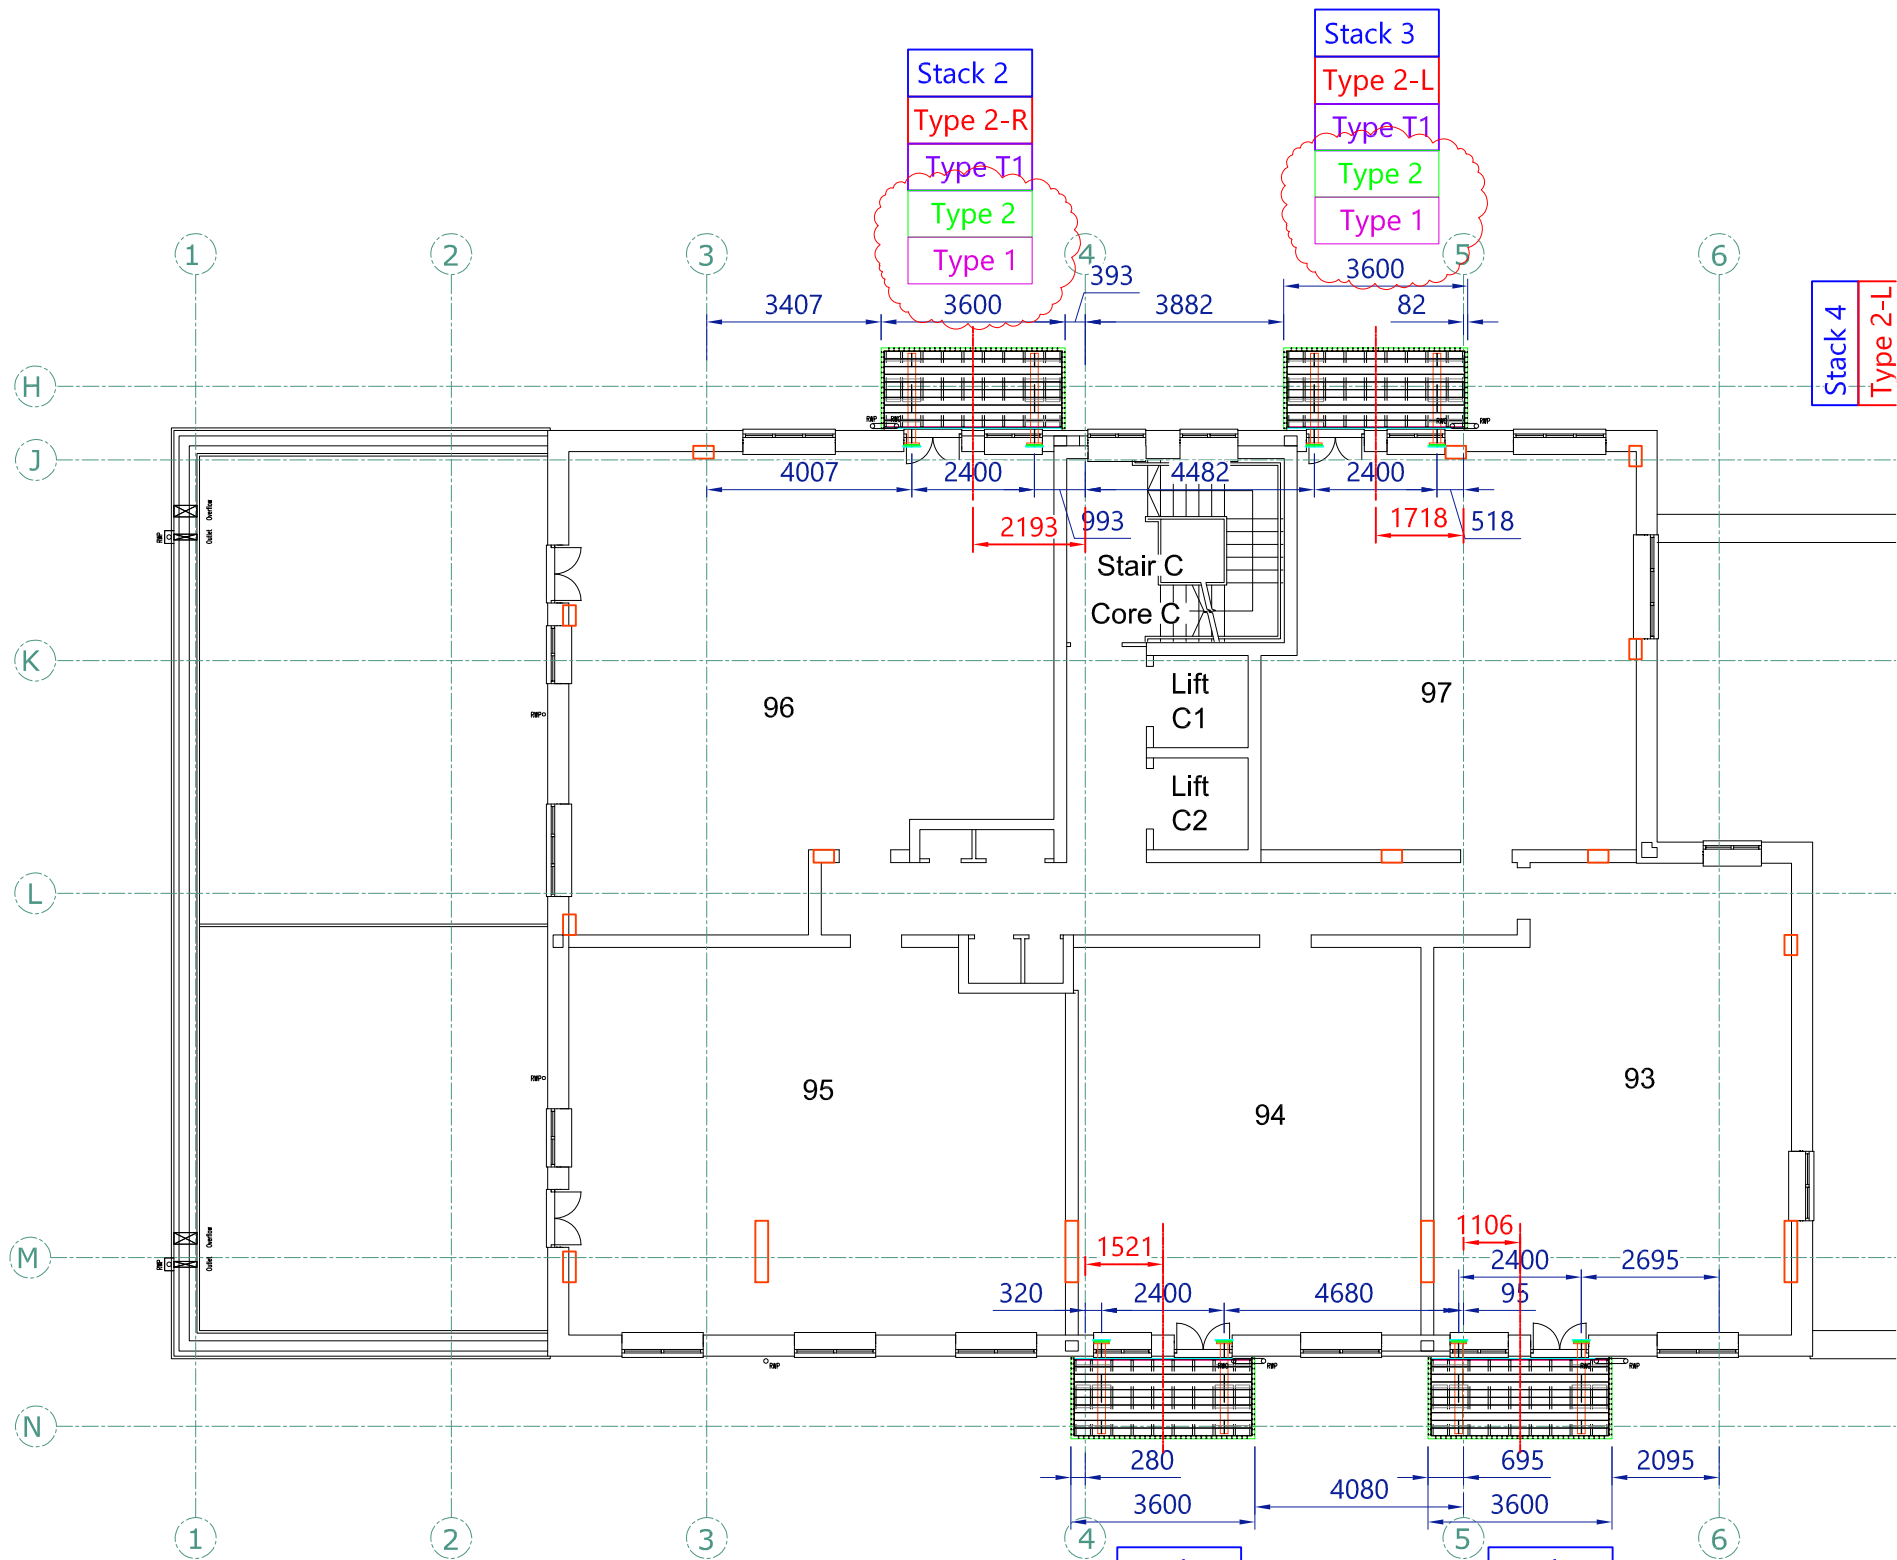

LEVEL 6

|     |          |                        |
|-----|----------|------------------------|
| Rev | Date     | Description            |
| E   | 08.07.20 | For Construction       |
| D   | 05.11.19 | For Construction       |
| C   | 11.10.19 | As per markup          |
| B   | 21.09.19 | Issue for construction |
| A   | 19.08.19 | Issued for Approval    |

Project  
Blyth Road

Location  
Block-C Level -6

Drawing Title  
GA Plan



www.sapphire.eu.com  
call 0844 88 00 553

Drawn by ARD Checked by SL Scale @ A3  
1:150

Project Ref. Drawing No. Revision  
530919 - GA-12- E