


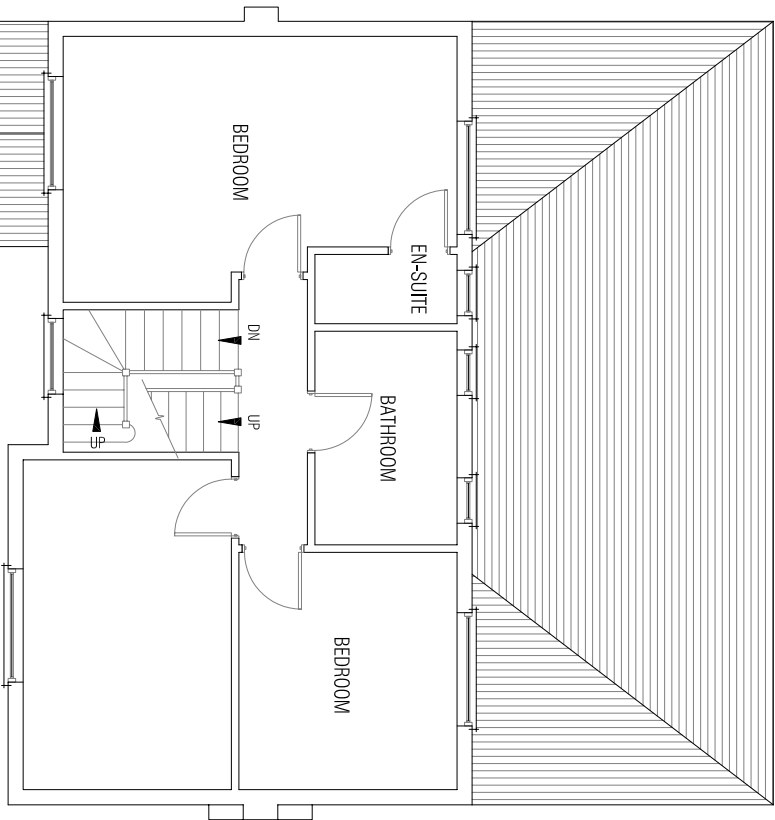


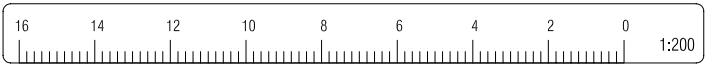


FIRST FLOOR PLAN

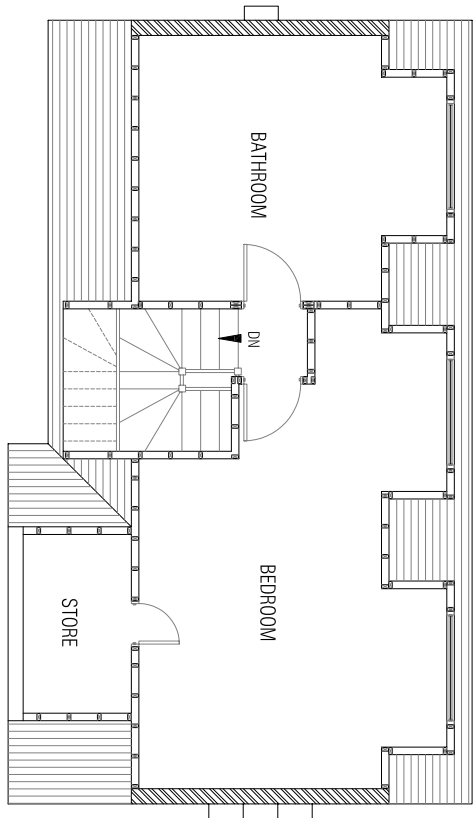


SECOND FLOOR PLAN

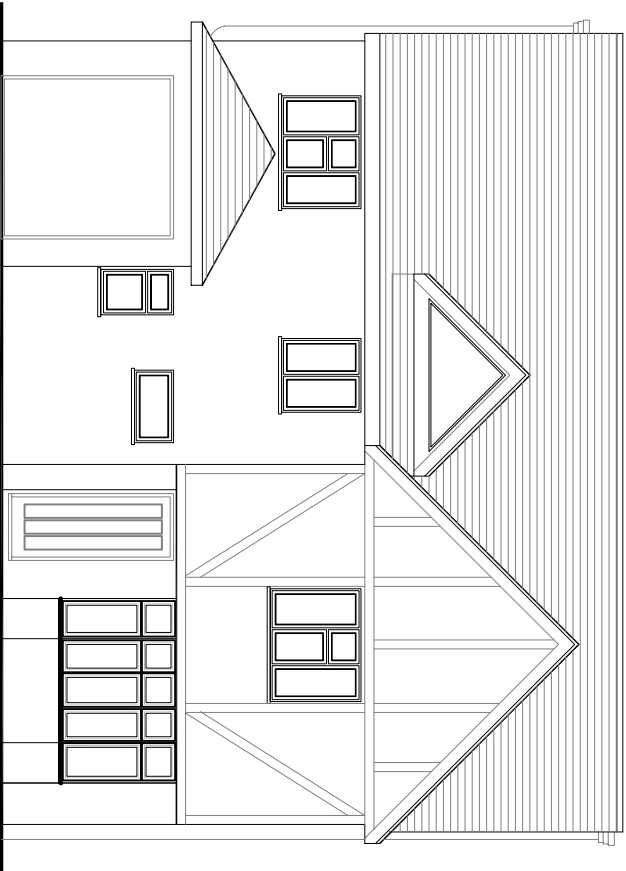

FRONT ELEVATION

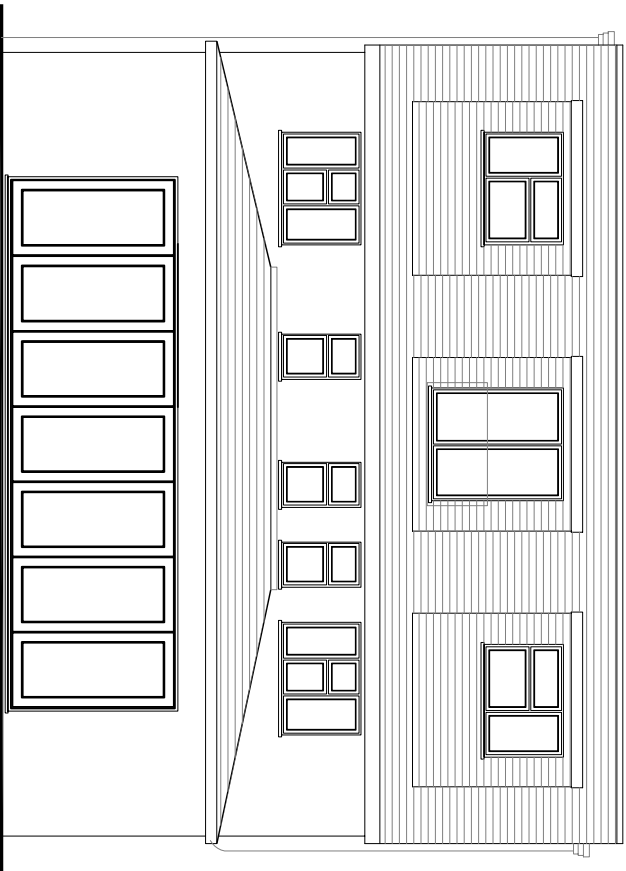

REAR ELEVATION

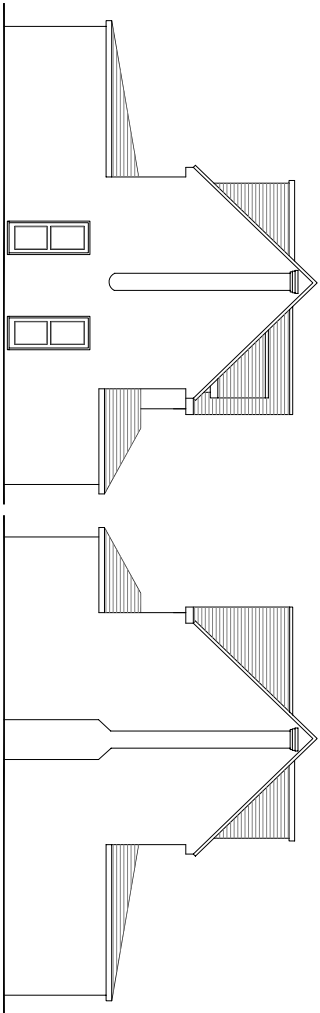

SIDE ELEVATION



MANN ASSOCIATES
Town Planning & Development
"Sandy Kopp", 45 Tulmer Drive, Gerrards Cross,
Buckinghamshire, SL9 7HG Tel: 07956 845 733

Client
MR & MRS S BAINS

Details
AS BUILT PLANS & ELEVATIONS

Job Title
7A MANOR ROAD
RUISLIP
MIDDLESEX
HA4 7LA

Drawing
ALTERATION & ERECTION OF ROOF
EXTENSION TO DWELLINGHOUSE

Date
APRIL 2023

Drawn No
03A

Scale
1:100 & 1:200