




FRONT ELEVATION

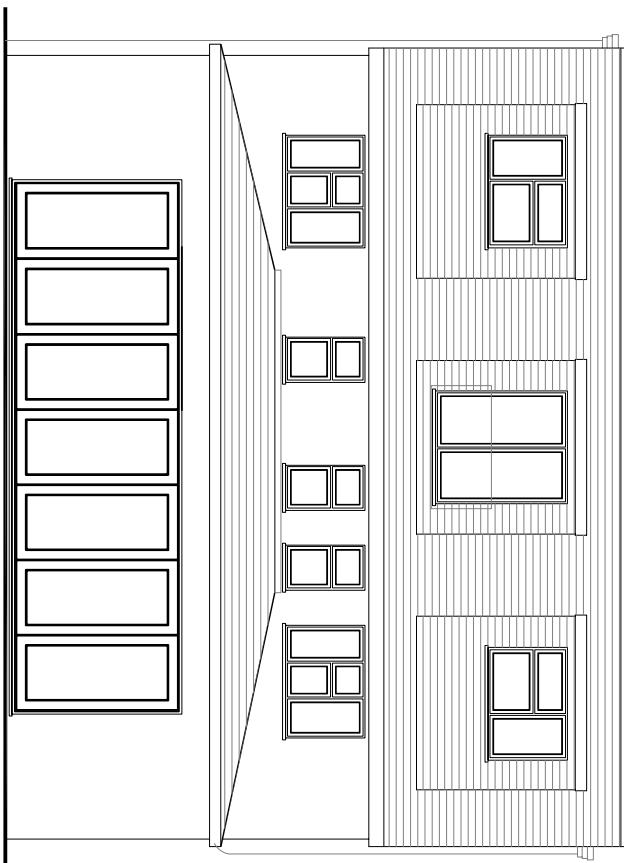


REAR ELEVATION

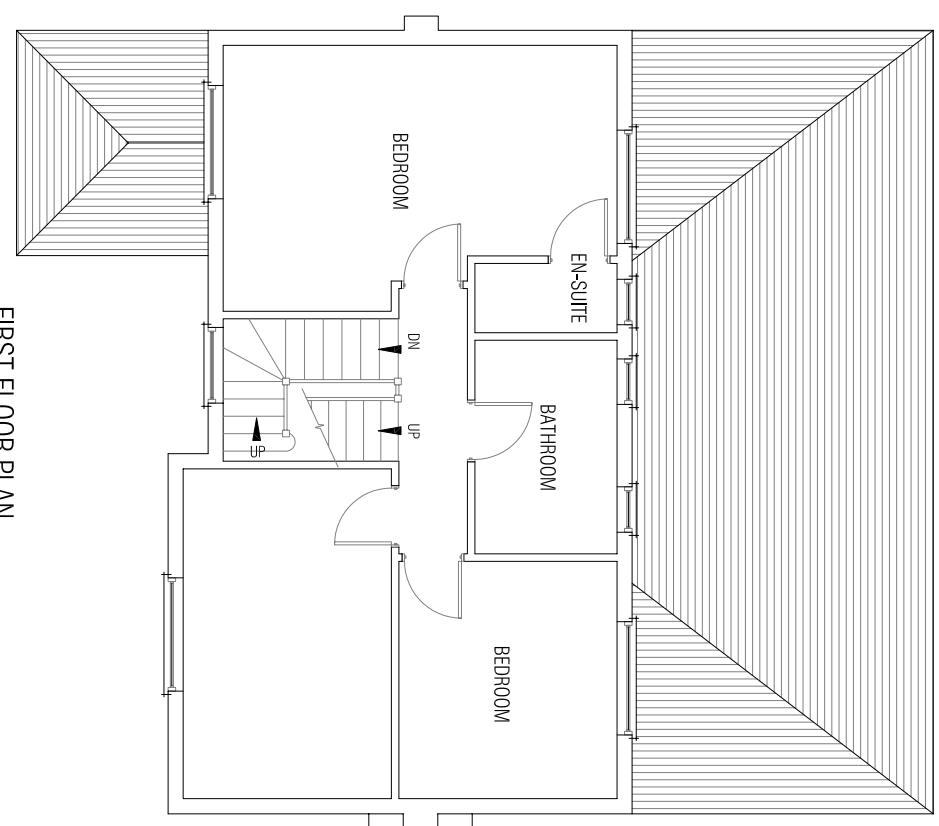

FIRST FLOOR PLAN

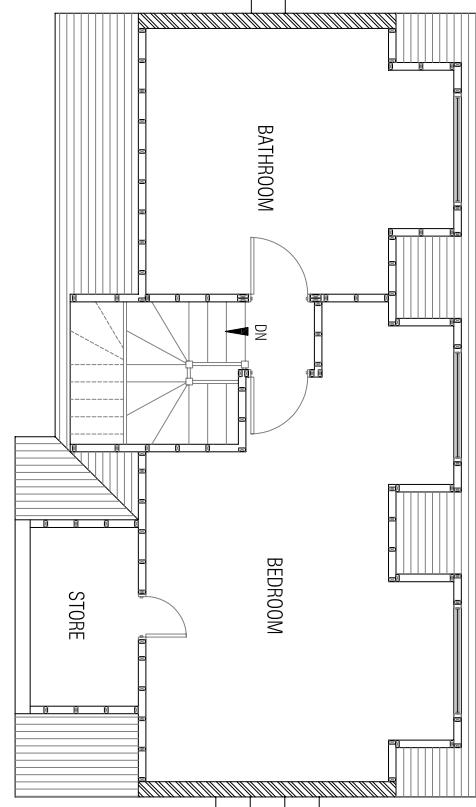

SECOND FLOOR PLAN

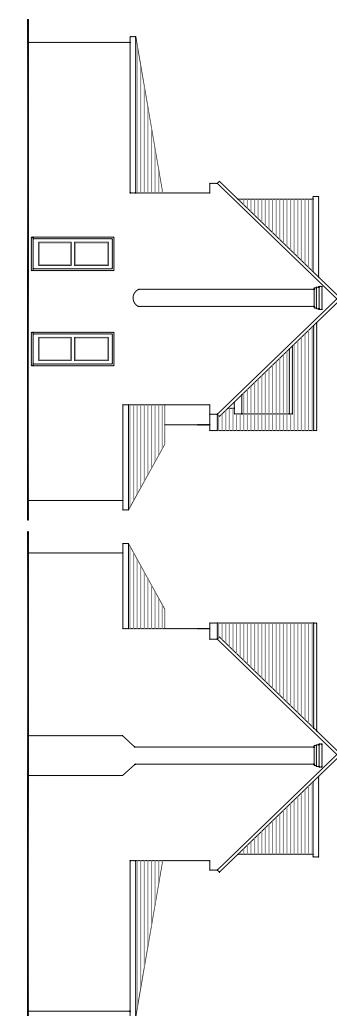

SIDE ELEVATION


DESIGN AND ACCESS

Planning permission for the scheme was previously allowed on appeal.

During construction, some practical issues arose resulting in the dormers being slightly larger. Accordingly, the application is made to regularise the works.


The changes are minimal and would not impact on the character and appearance of the conservation area.

The principal change is on the rear elevation and not visible from the street.

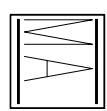

MANN ASSOCIATES
Town Planning & Development
"Sandy Knapp", 45 Fisher Drive, Gerrards Cross,
Buckinghamshire, SL9 7HG Tel: 01926 8345 733

LOCATION PLAN
Scale 1:1250

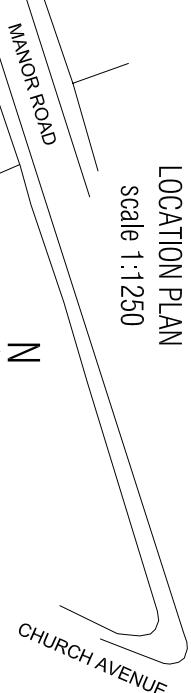

Client	Details
MFR & MRS S BAINS	
Job Ref: 7A MANOR ROAD	
RUSSLIP MIDDLESEX HA4 7LA	

AS BUILT PLANS & ELEVATIONS
Drawing
ALTERATION & ERECTION OF ROOF
EXTENSION TO DWELLINGHOUSE

APRIL 2023

Date Drawing No. Scale
03A 1:100 & 1:200