




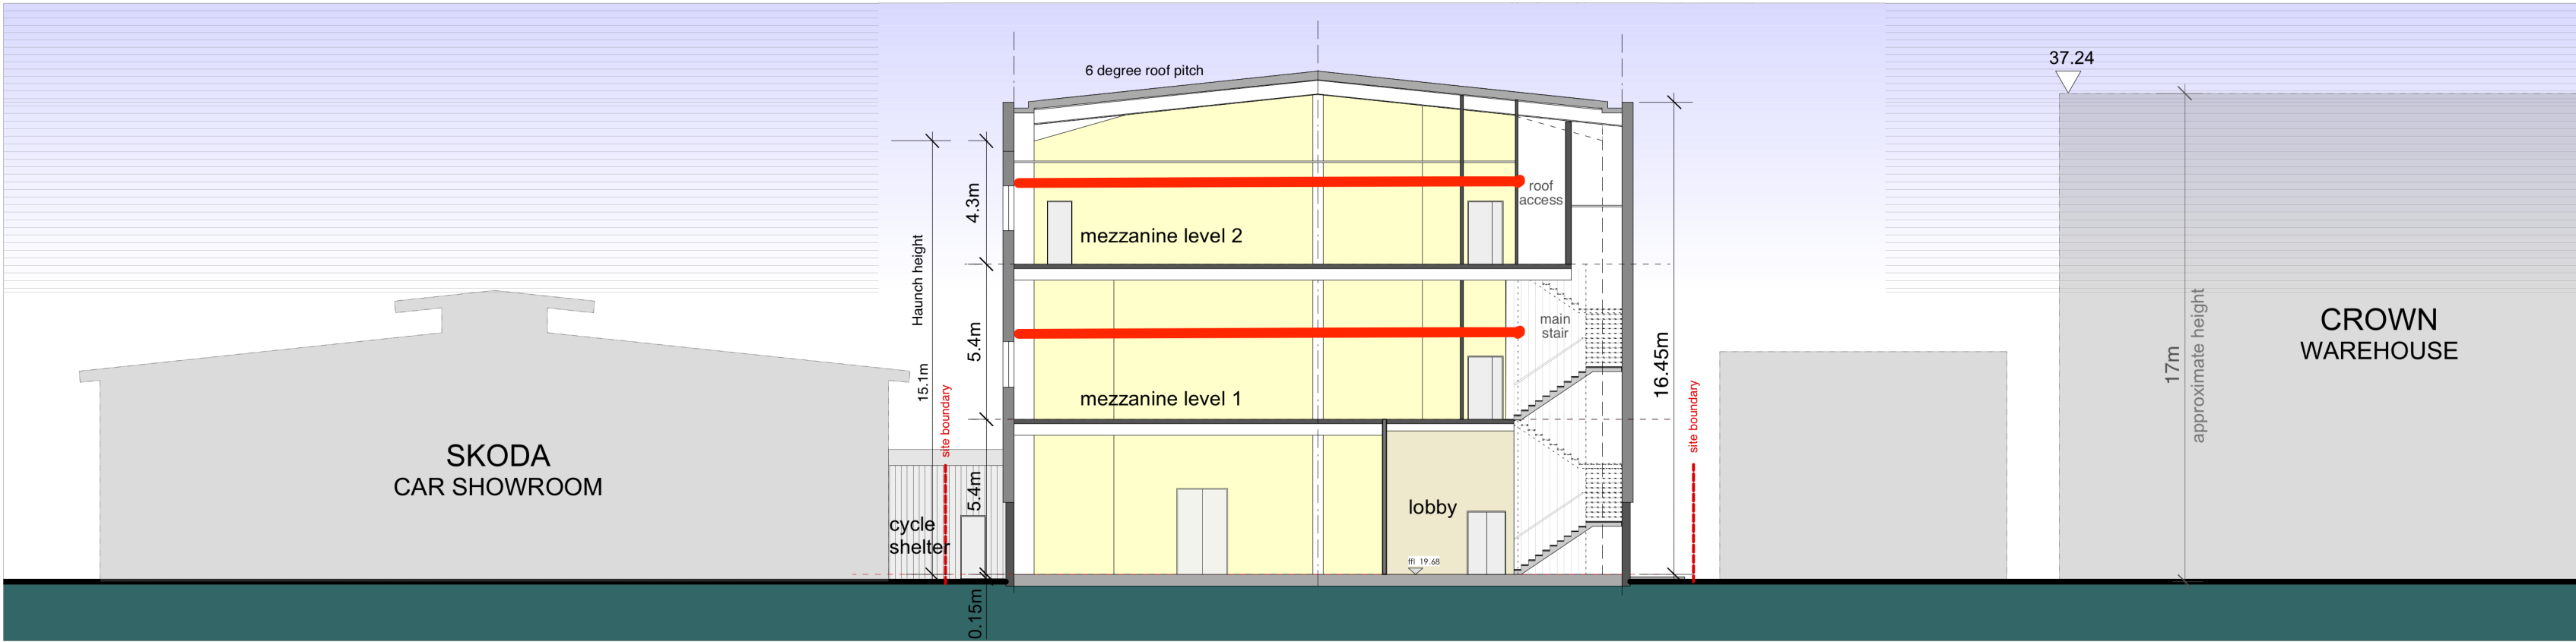

EXISTING/ PROPOSED SECTION A - A

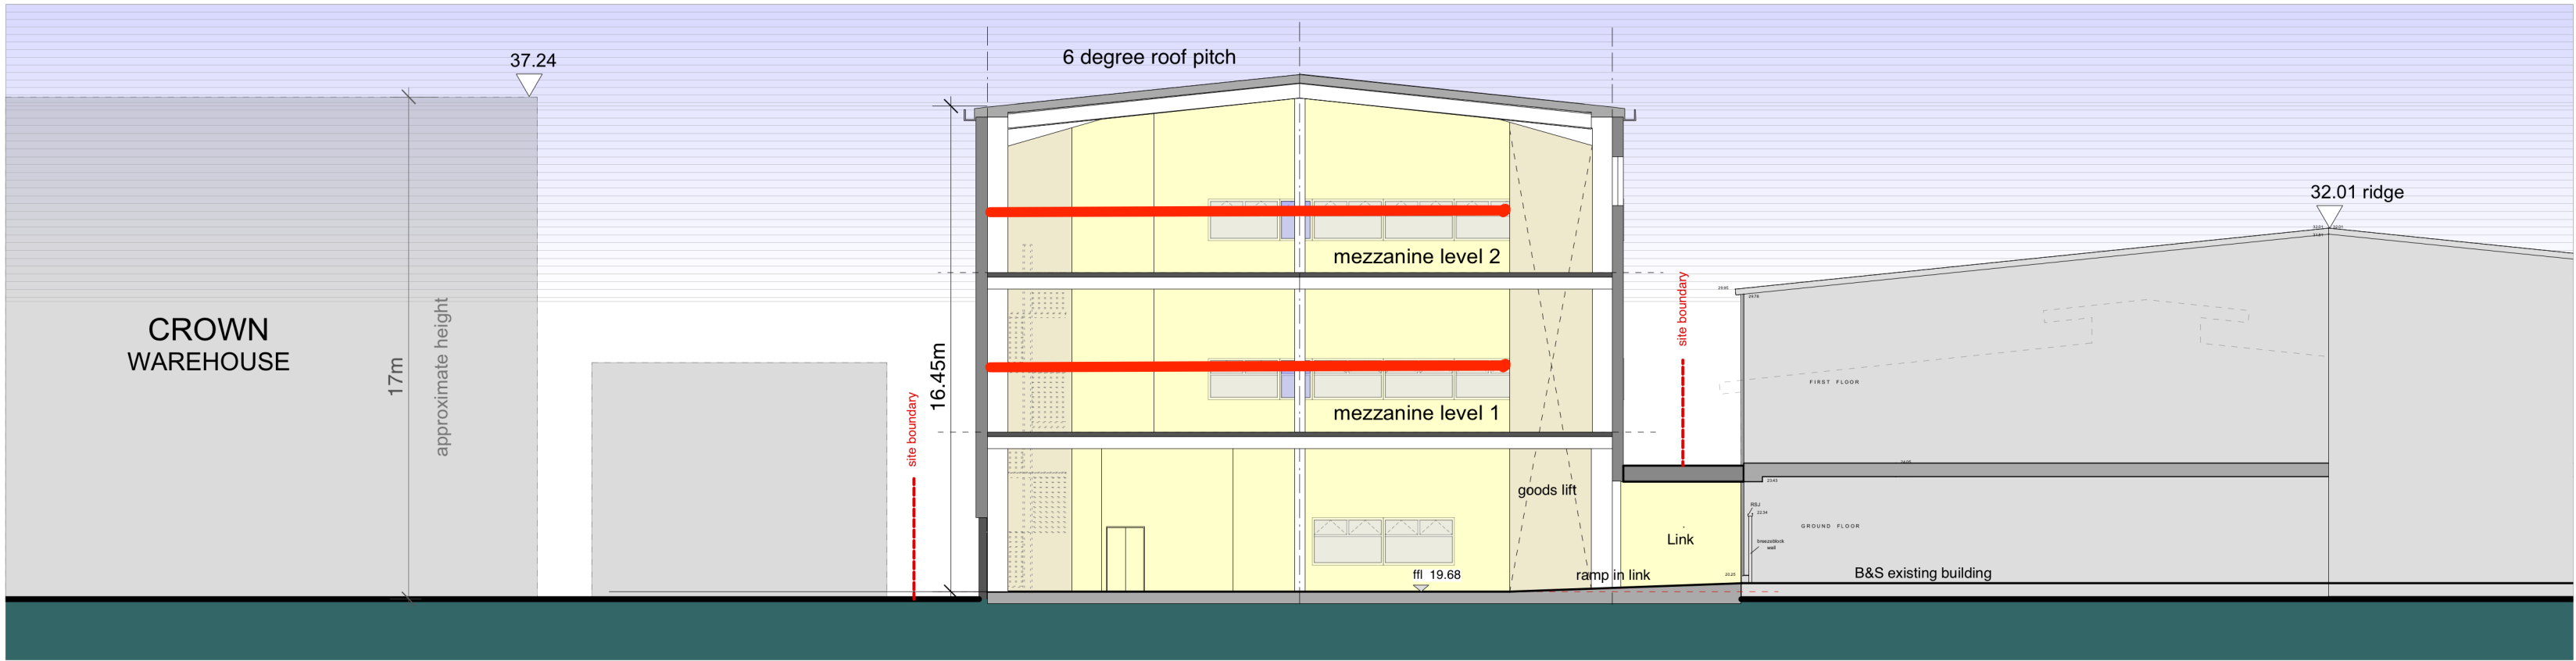

EXISTING/ PROPOSED SECTION C - C

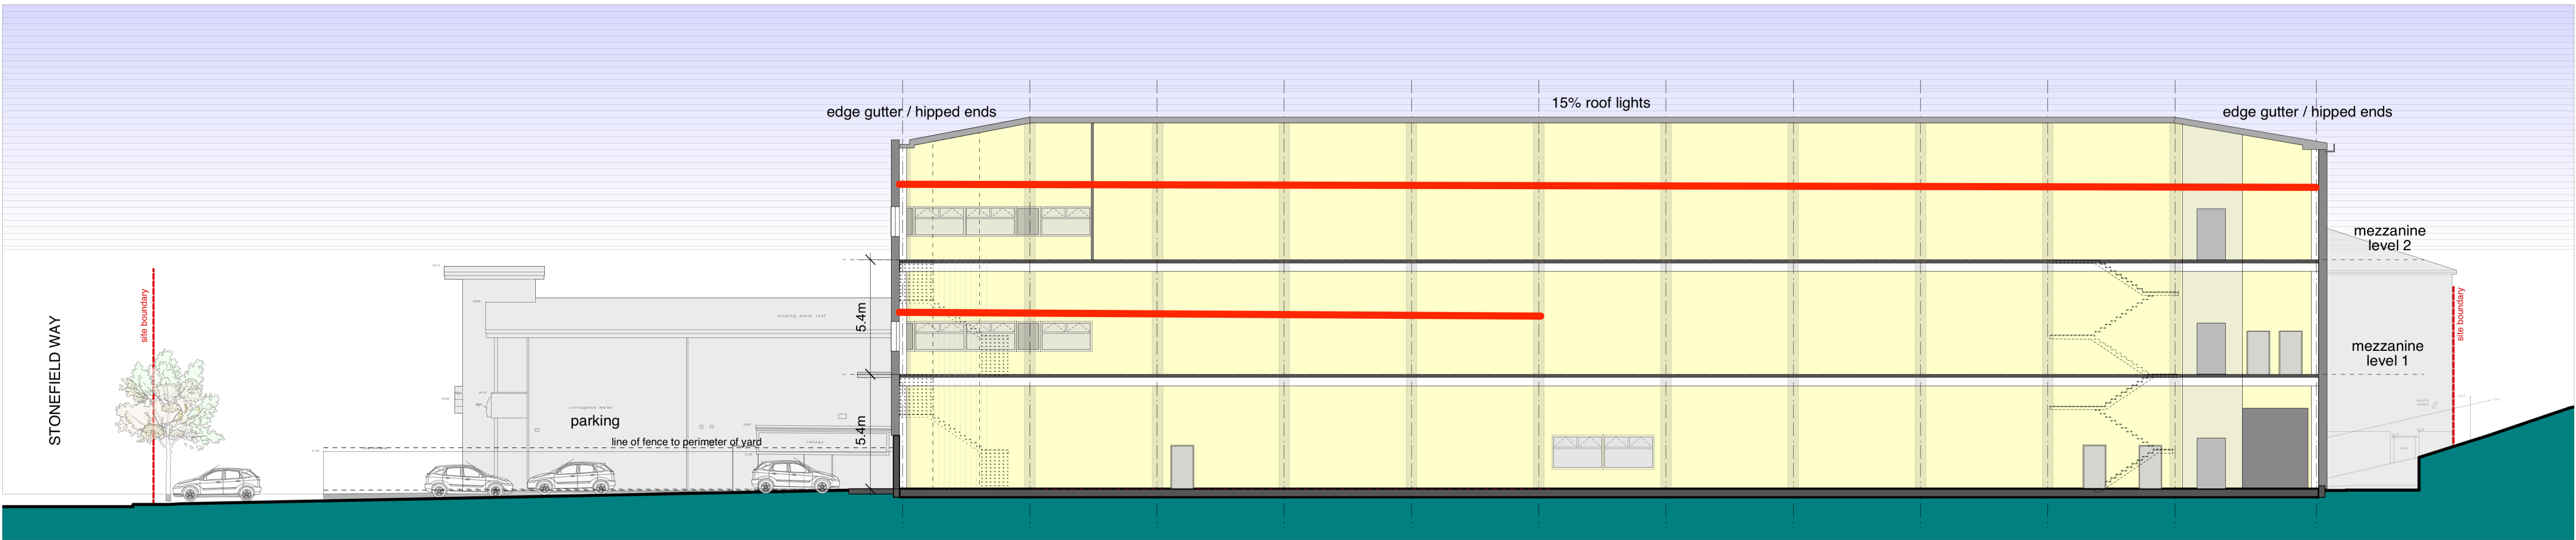

EXISTING/ PROPOSED SECTION B - B

Red line - mezzanine section

PLANNING

REV.	DATE	DESCRIPTION
A:	14.11.14	General update
B:	18.11.14	Text amended on Section B-B
C:	10.12.14	Revised following meeting 27.11.14
D:	19.1.15	General update.

PROJECT
555 STONEFIELD WAY RUISLIP

DRAWING
EXISTING & PROPOSED SECTIONS

CLIENT
B&S HEALTHCARE

SCALE
1:200 @ A1 1:400 @ A3

DATE
NOV 2014

DRAWING No.
1428-P07

REVISION
D

© copyright retained

LDA
Chartered Architects

LDA (Architects) Limited
Devonshire House
60 Station Road
Aldershot
Surrey, KT15 2AF
T. 01932 828933
F. 01932 828934
E. lda@ldaarchitects.co.uk