

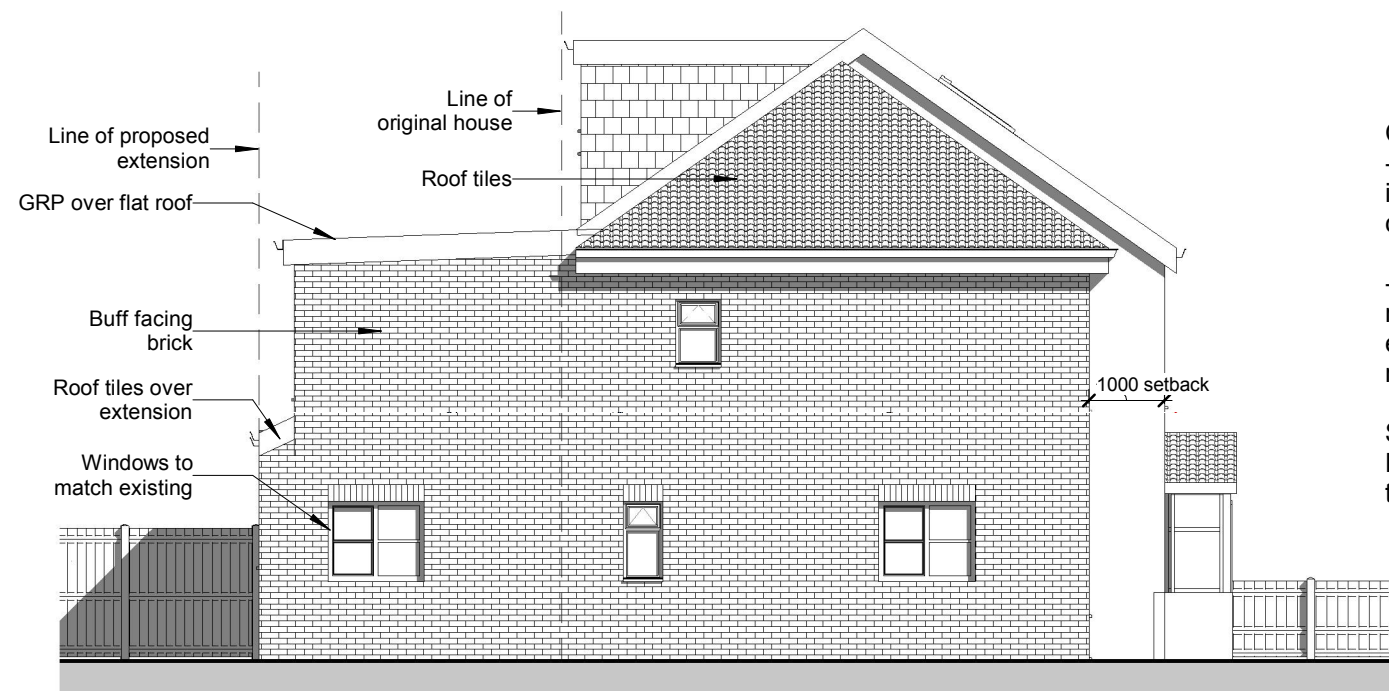
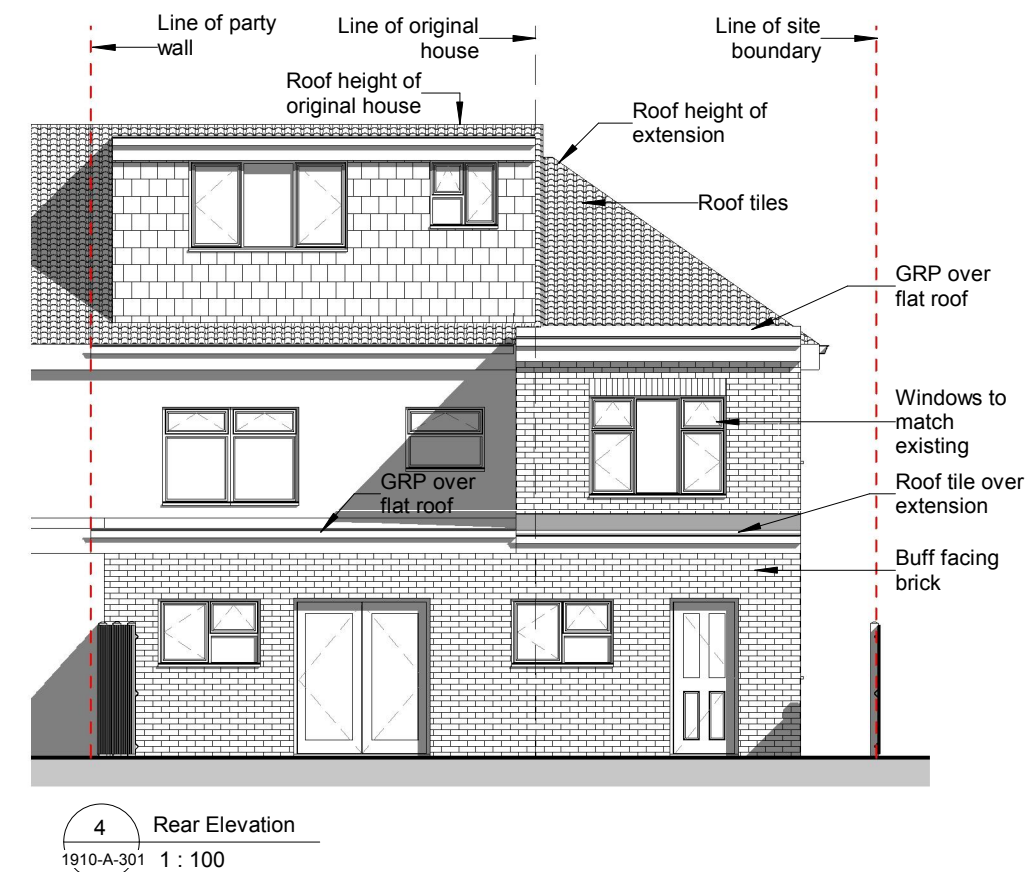
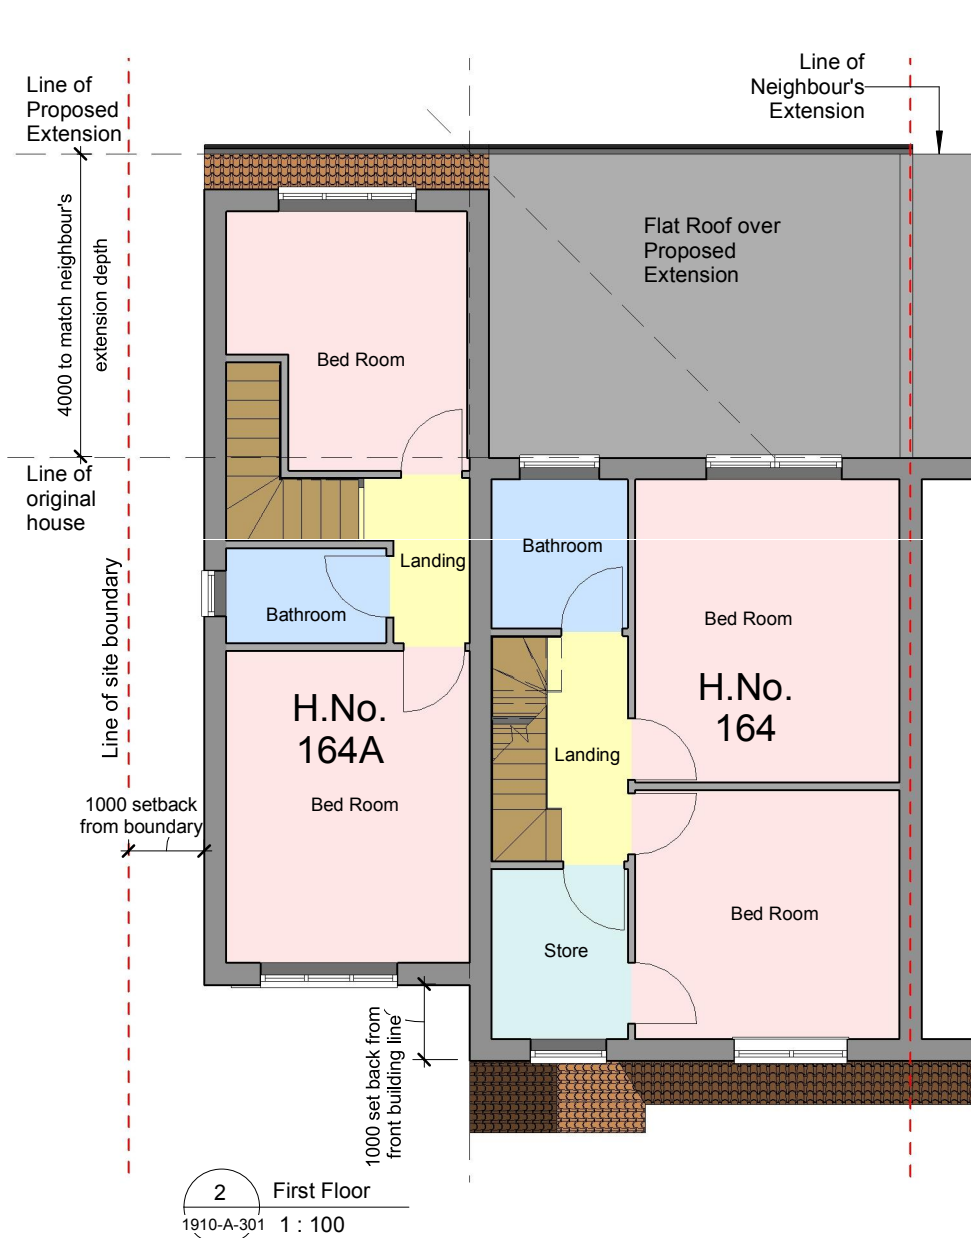


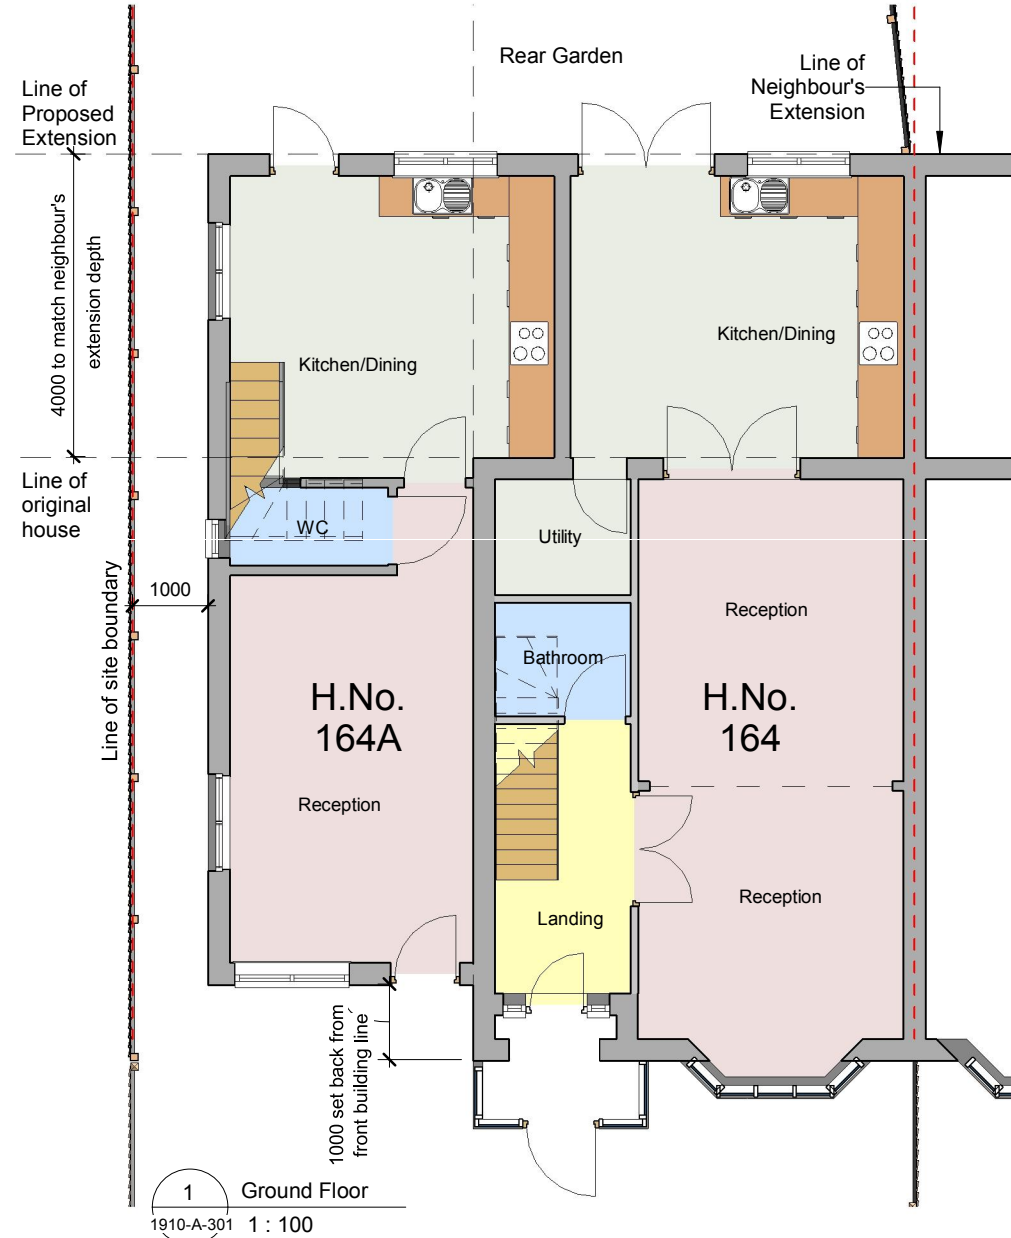

Changes to roof and external material:
- Rear first floor flat roof is raised to have internal ceiling height in compliance with current building control.

- External brick is installed considering its robustness and also to break the elevation/mass and over dominance of render material.

See Drawing 1910-A-311 - Proposed Elevations Option 2 for proposed change to roof.

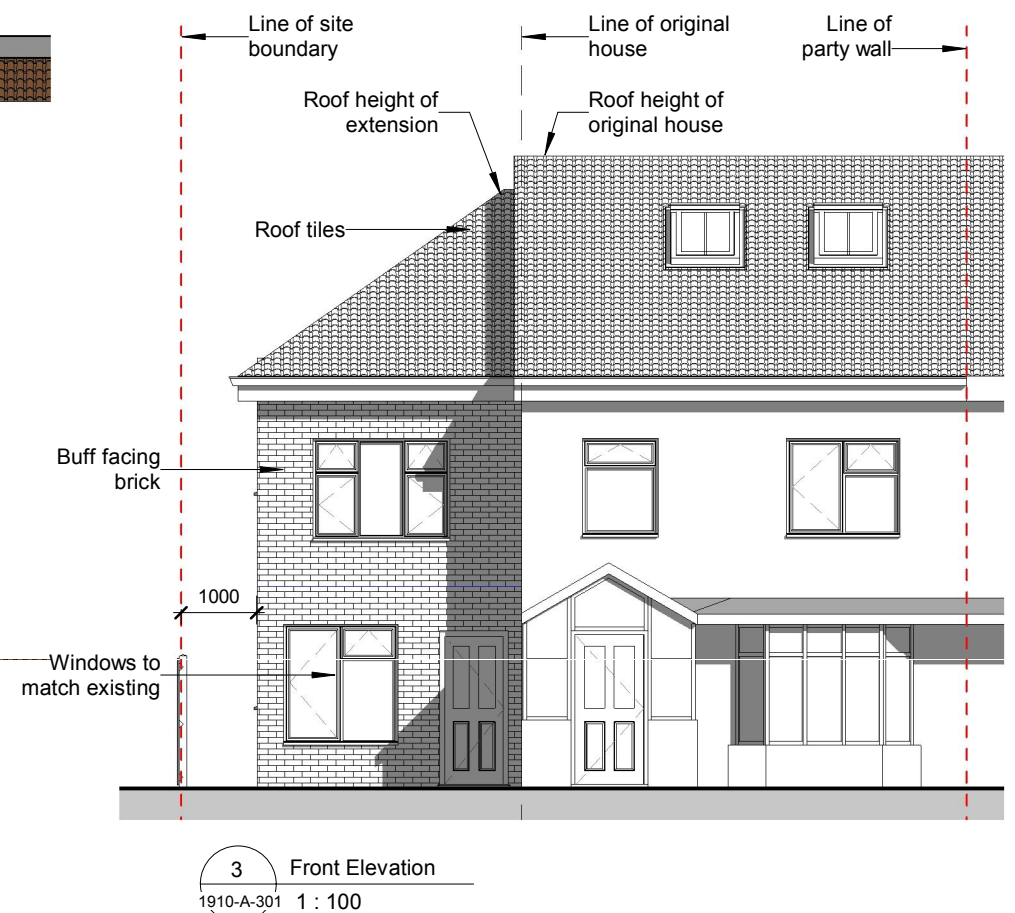

Rev. No.	Description	Date	Project:
A	External wall amended to brick, rear first floor flat roof raised (as built)	10.07.19	Single storey rear extension, double storey side extension & conversion of dwelling into 2 dwellings 164, North Hyde Road, Hayes, UB3 4NH
			Client: Mr. Nachhattar Singh
			Title: Plans and Elevations (As Built)
			Project No: 19P0511-010
			Scale: 1 : 100@A3
			Rev: A
			Date: July 2019
			Drg No: 1910-A-301