



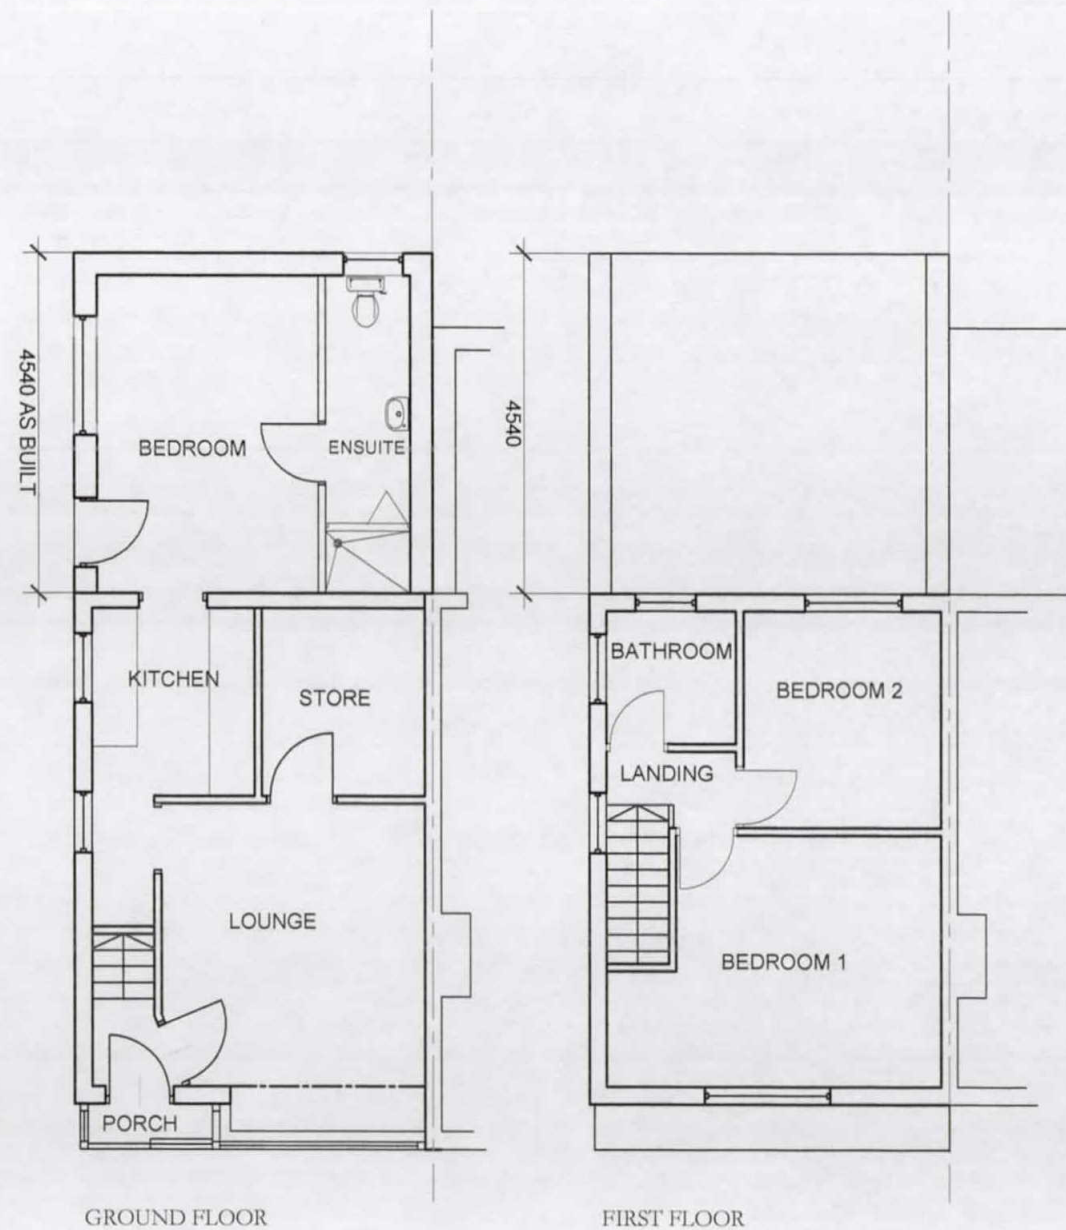


EXISTING PLANS AS BUILT

SITE ADDRESS:	REVISIONS:
4 WARWICK CRESCENT	
HAYES	
UB4 8RE	

TITLE:
EXISTING PLANS
PROPOSED PLANS

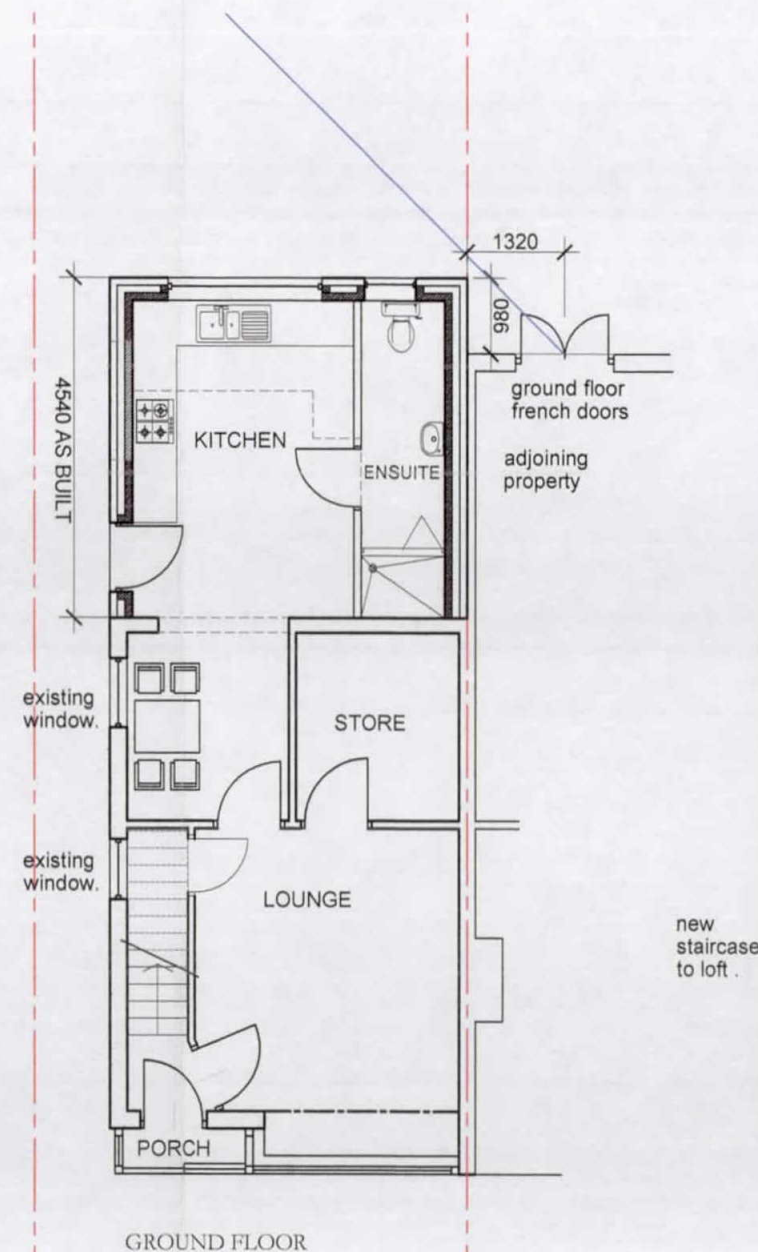

PROPOSED PLANS

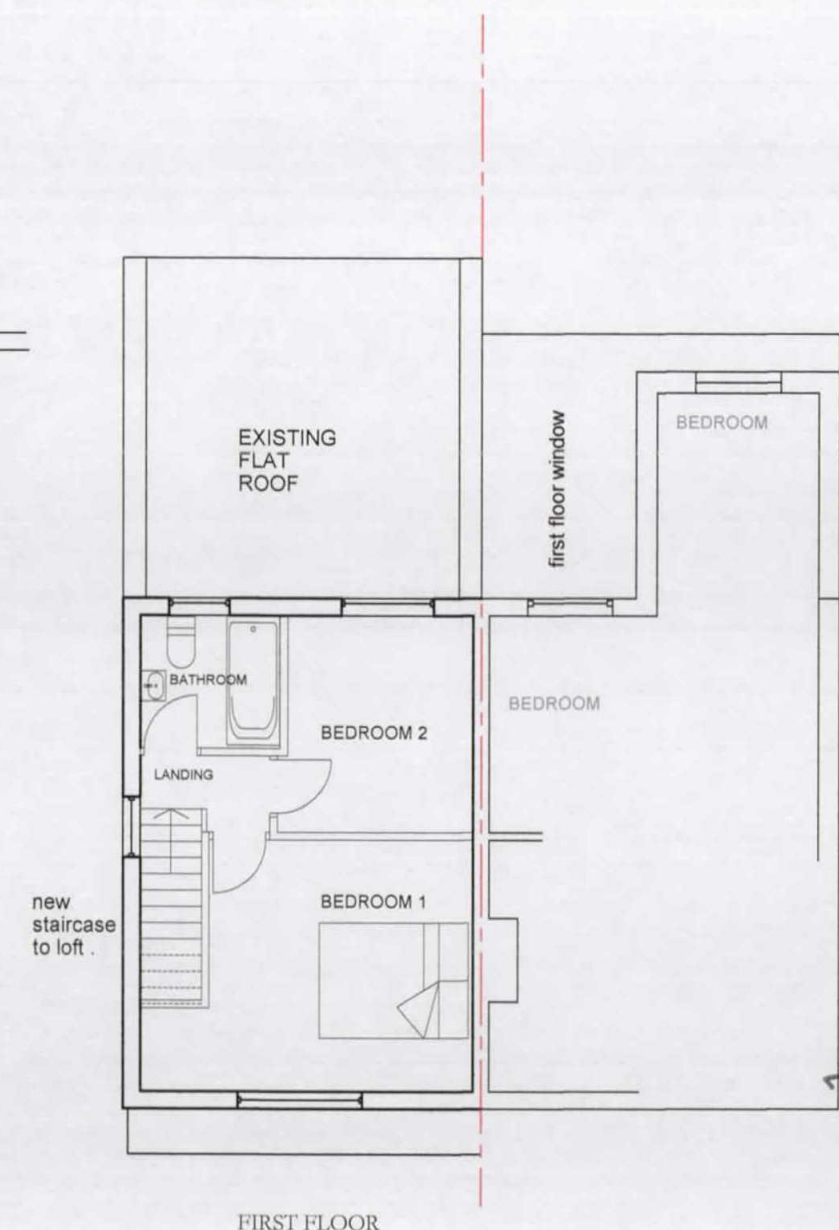

Dwg No.	10-17-03	Sheet
Date	OCT 2017	P11
Scale	1/100 @ A3	

29 NOV 2017