





Pre Existing Side Elevation

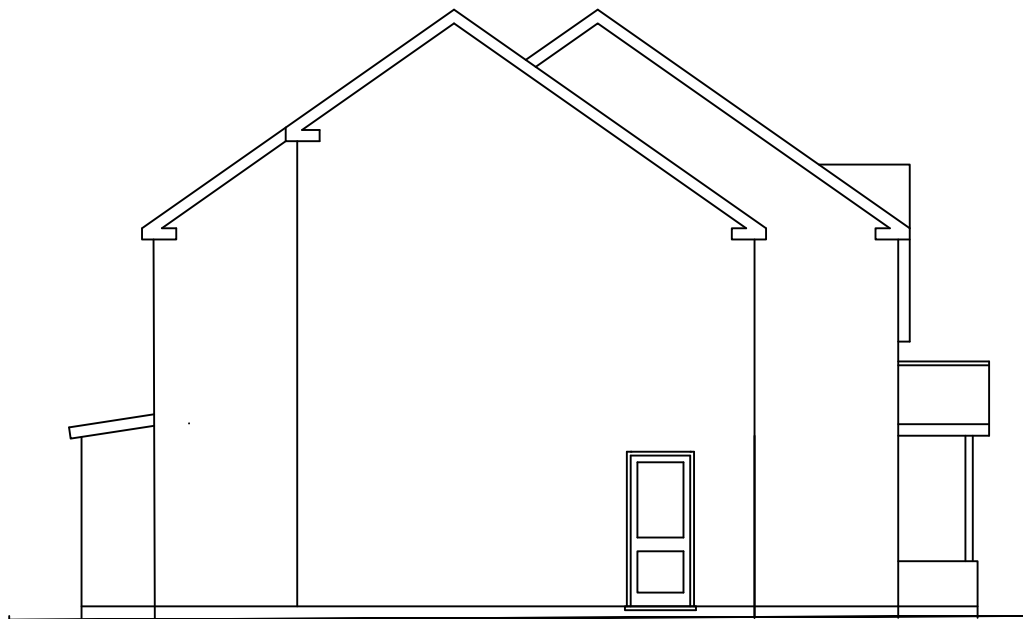

Pre Existing Front Elevation

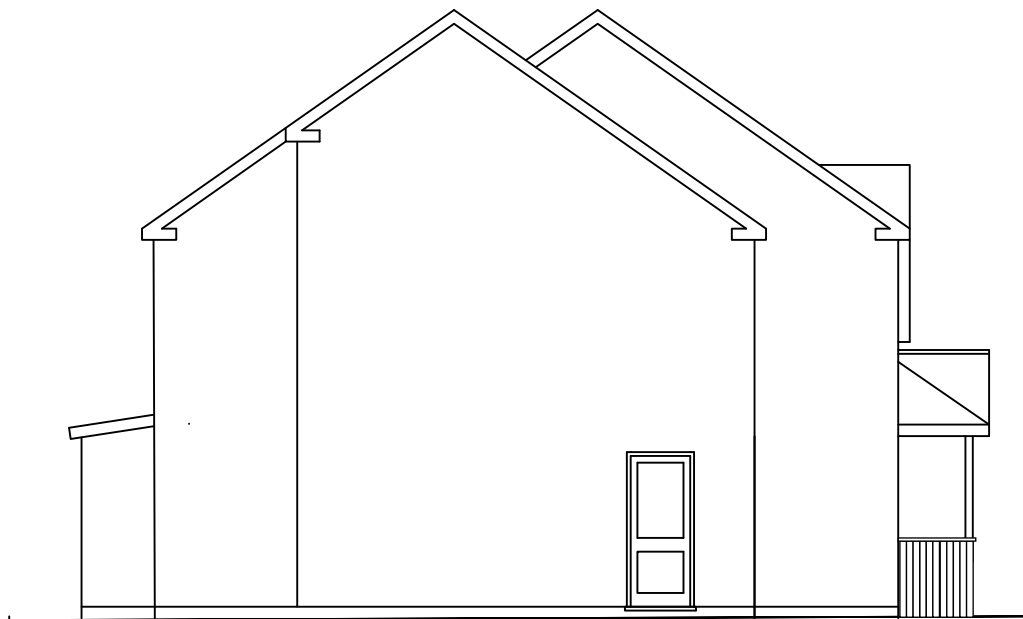

As Built Side Elevation



As Build Front Elevation