


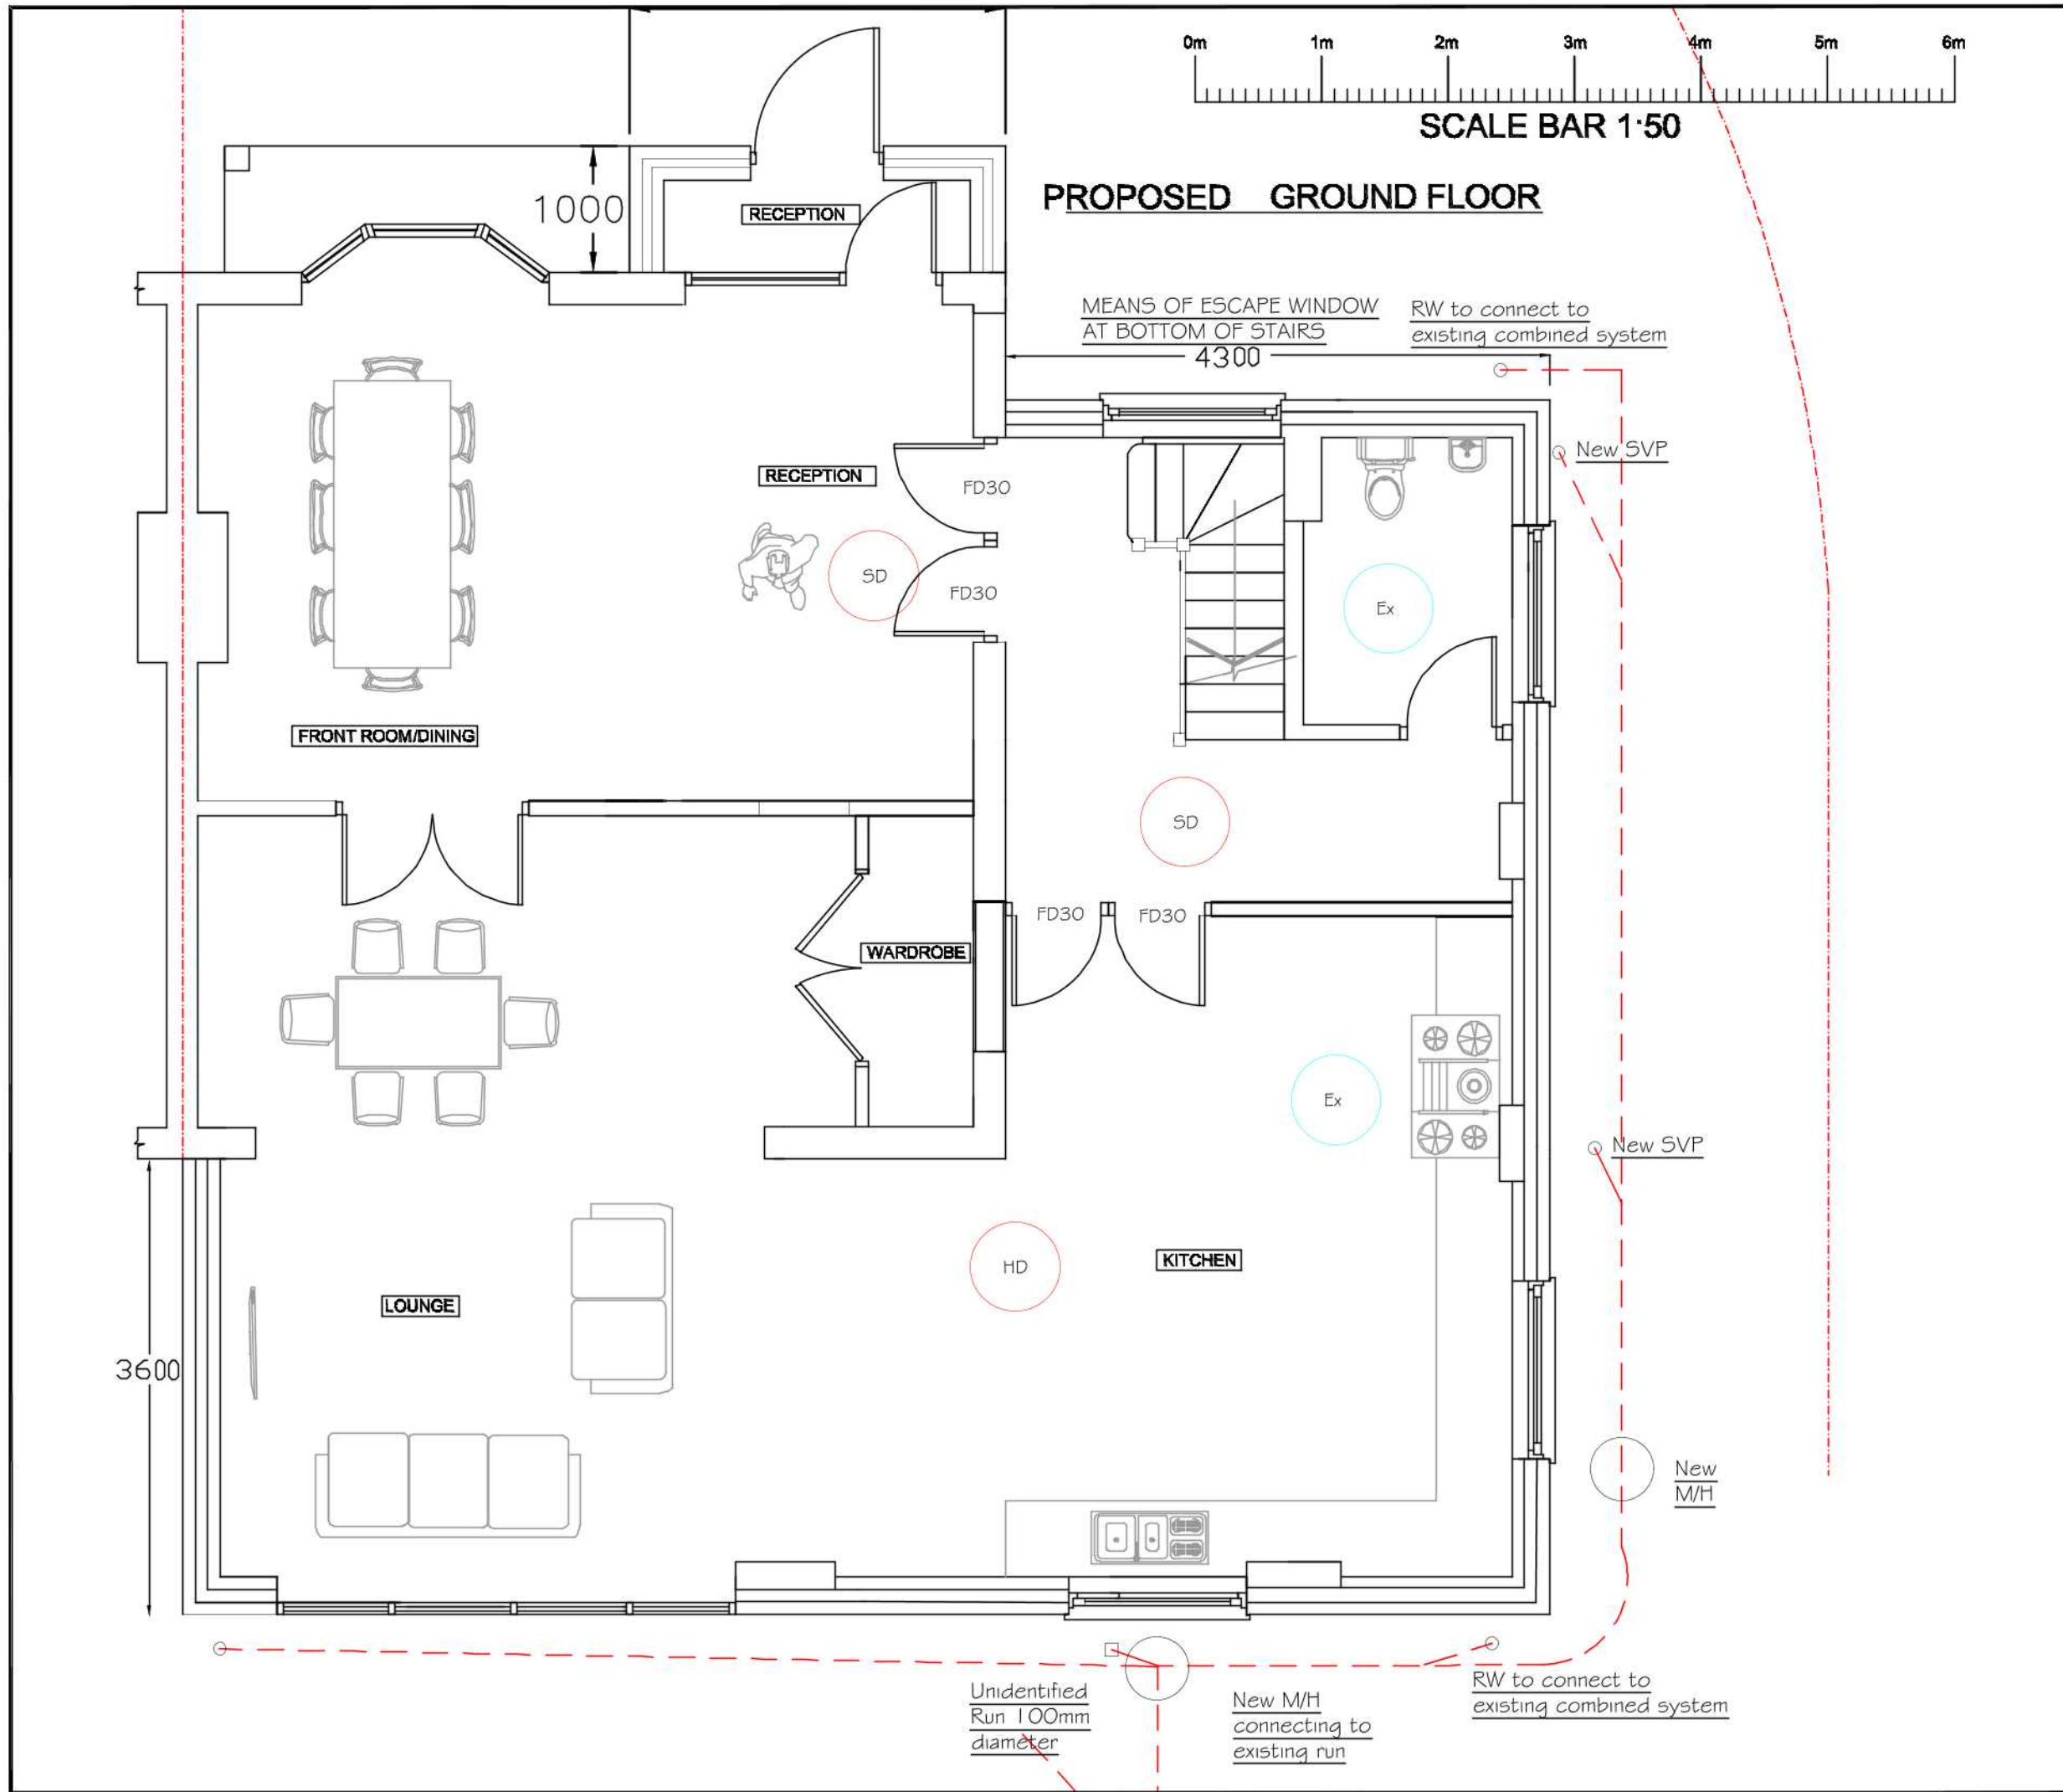

A-Z Building Services

A: Addlestone KT15
E: hthuseyin0809@gmail.com
T: 07969925562

Rev	Description	Date
CLIENT Mr R Kapur		
PROJECT 277 KINGSHILL AVENUE HAYES UB4 8BP		
DRAWING AS BUILT GROUND FLOOR PLAN		
DRAWN: HTH	CHECKED:	APPROVED:
TRACED:	SCALE 1:50 @ A3	DATE MAR 18
DRAWING No. 277KINGSHILL/2016/BREGS/6/2		REV B