


Any dimensions taken from this drawing
should be cross checked on site and
approved prior to any construction works.

A-Z Building Services

A: Addlestone KT15
E: hthuseyin0809@gmail.com
T: 07969925562

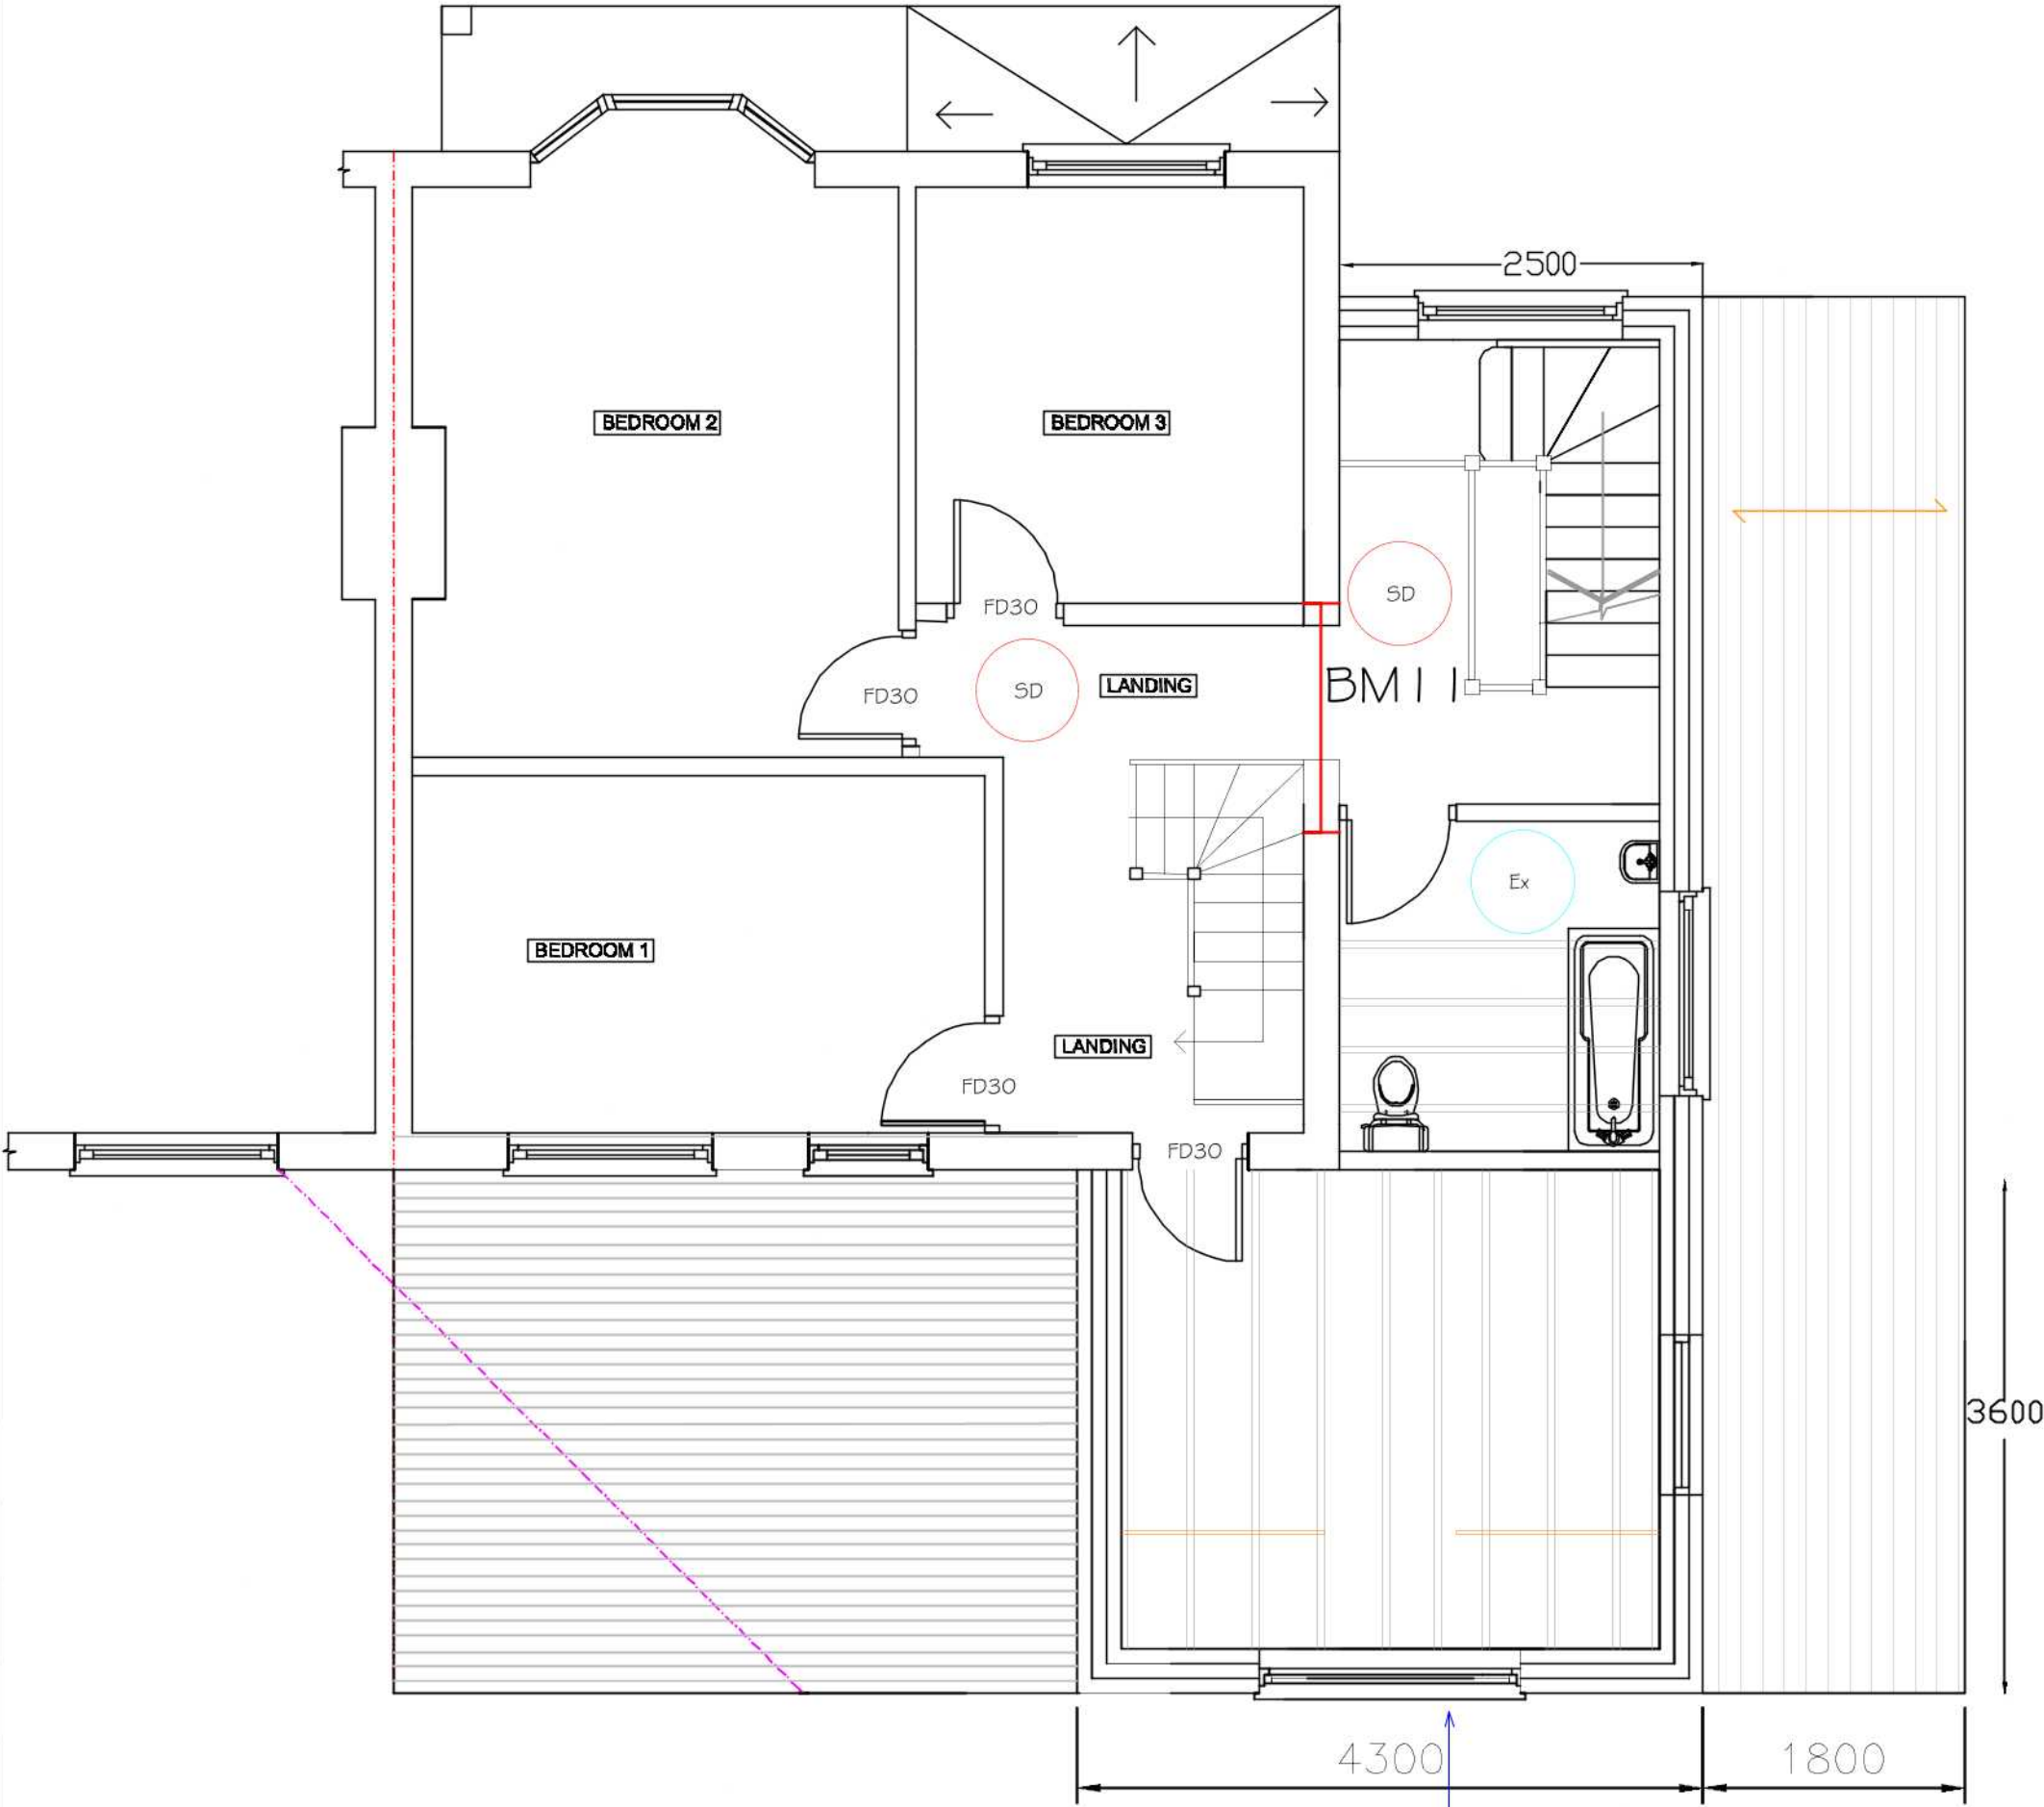

Rev	Description	Date
1	CLIENT	
2	Mr R Kapur	
3	PROJECT	
4	277 KINGSHILL AVENUE HAYES UB4 8BP	
5	DRAWING	
6	AS BUILT FIRST FLOOR PLAN	
7	DRAWN HTH	CHECKED
8	TRACED	SCALE 1:50 @ A3
9	DRAWING No.	APPROVED
10	277KINGSHILL/2016/BREGS/5/2	DATE MAR 18
11		REV
12		A