


Any dimensions taken from this drawing should be cross checked on site and approved prior to any construction works.

A-Z Building Services

A: Addlestone KT15
E: hthuseyin0809@gmail.com
T: 07969925562

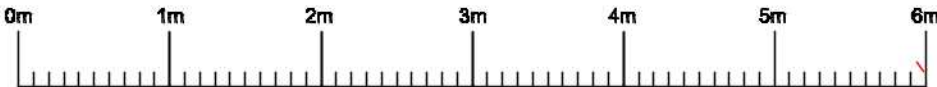

SCALE BAR 1:50



PROPOSED SIDE ELEVATION

GENERAL NOTES:

THIS DRAWING IS NOT TO BE SCALED, THE MAIN CONTRACTOR IS RESPONSIBLE FOR CHECKING ALL DIMENSIONS ON SITE PRIOR TO COMMENCEMENT OF WORKS WITH ANY DISCREPANCIES REPORTED

ANY CONSTRUCTION WORK CARRIED OUT PRIOR TO OBTAINING THE NECESSARY APPROVALS IS ENTIRELY AT THE HOUSEHOLDER/CONTRACTORS RISK.

ALL BUILDING WORK IS TO BE CARRIED OUT TO THE SATISFACTION OF THE LOCAL AUTHORITY AND BUILDING CONTROL OFFICER, AND IN ACCORDANCE WITH CURRENT BUILDING REGULATIONS, AND AS SUCH ANY UNFORESEEN BUILDING WORKS THAT MAY BE REQUIRED ON SITE.

THE MAIN CONTRACTOR SHALL BE ENTIRELY RESPONSIBLE FOR THE SECURITY, STRENGTH AND STABILITY OF THE BUILDING/SITE DURING THE WORKS DURATION.

Rev	Description	Date
CLIENT		
Mr R Kapur		
PROJECT		
277 KINGSHILL AVENUE HAYES UB4 8BP		
DRAWING		
AS BUILT SIDE ELEVATION @ 1:50		
DRAWN	HTH	CHECKED
TRACED	SCALE 1:50 @ A3	APPROVED
DRAWING No.		DATE
277KINGSHILL/2016/BREG/3		MAR 18
REV		A