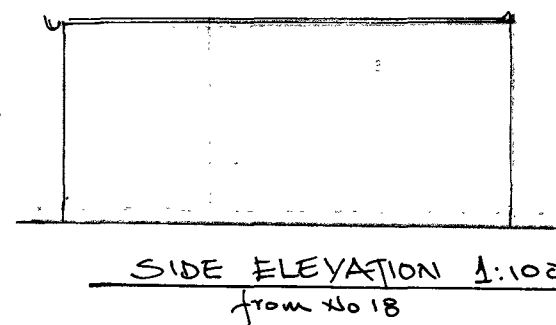
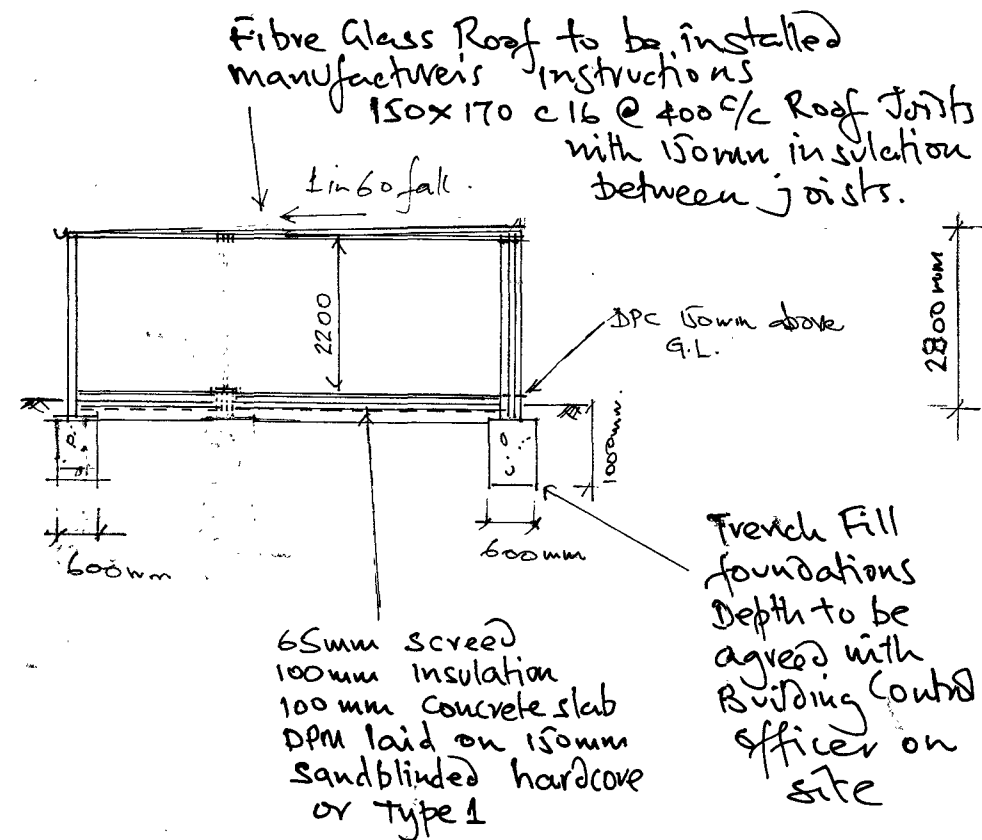
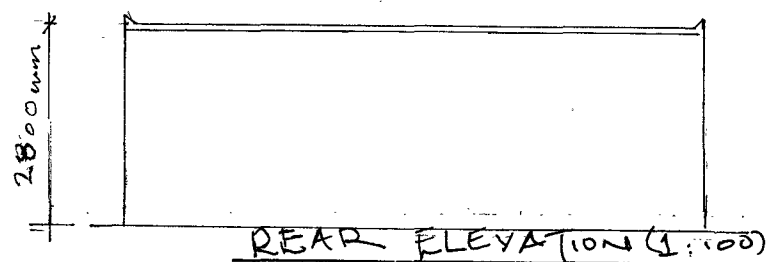
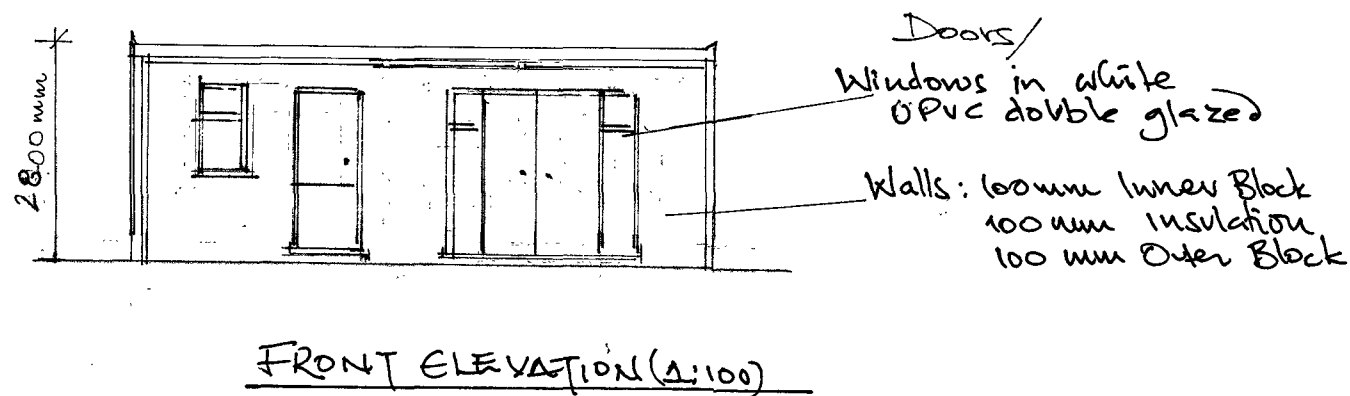
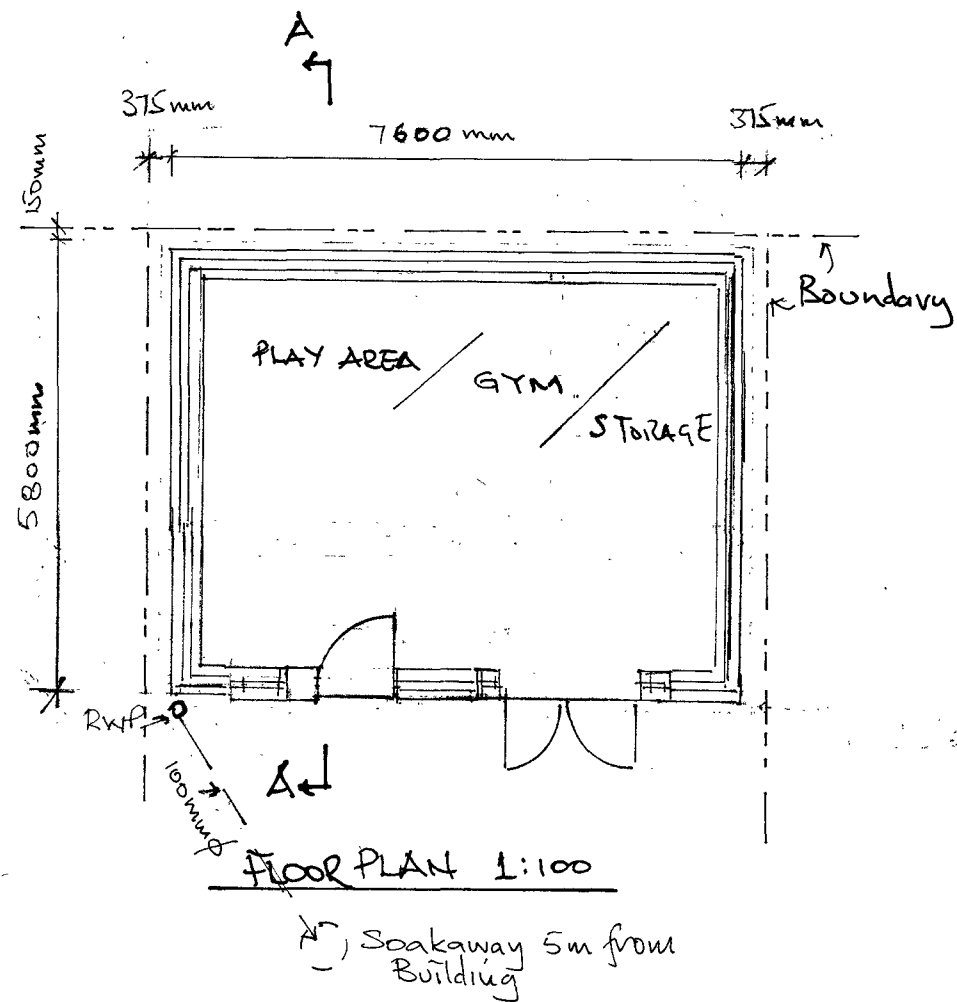


Note:
All dimensions must be checked on site
and not scaled from this drawing.

All measurements in mm
Cross ventilation to
be provide to flat Roof

A	1/9/20	AS BUILT
Date		Revision

© copyright

Client

MRS R CHAFURT

Job Title

NEW OUTBUILDING
20 KINGS ROAD
WEST DRAYTON
UB7 9EF

Drawing Title

PLANS &
ELEVATION &
SECTION

Scale 1:100

Date 12/6/2017 Drawn by KMA

Drg. No.	Rev.
KR-01	A