




Existing Ground Floor Plan

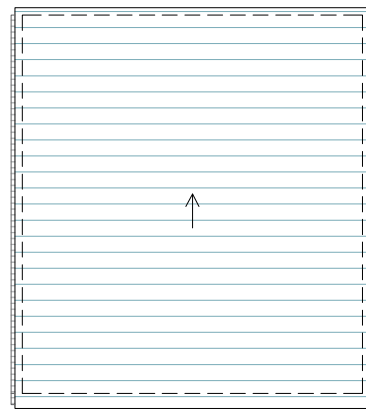


Existing Ground Floor Plan

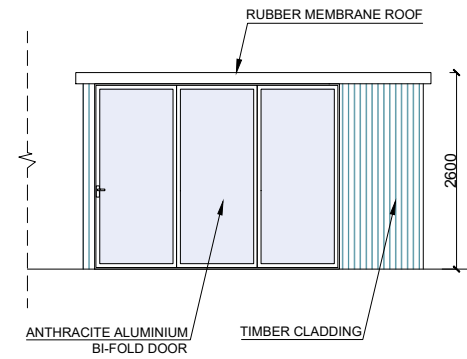


Existing East Elevation

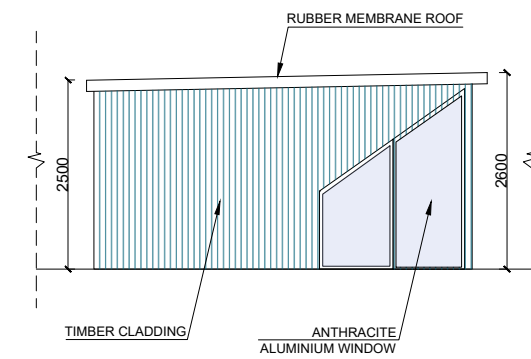

Existing South Elevation

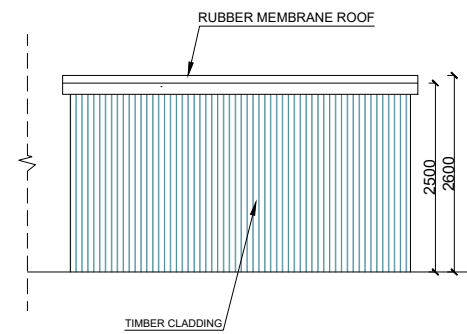


Existing West Elevation

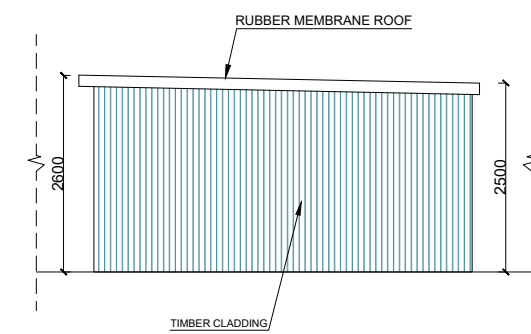

Existing North Elevation

Any dimensions shown should be checked on site and discrepancies reported to the Architect prior to construction. Designs are not coordinated with engineer projects. Do not scale for construction purposes.

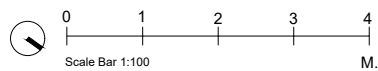

Existing As-Built

Drawing Name

Existing Plans and Elevations

Project Address

36a Broadwater Gardens UB9 6AL

Drawing No.

36aBroadwaterGardens\_ExistingPlansandElevations\_V3

Scale

1/100 at A3

Designer

EC

Date

05.12.2025

Drawing No.

04

Revision

V3



Planning By Design Ltd  
www.planning-by-design.co.uk  
hello@planning-by-design.co.uk