




PROPOSED FRONT ELEVATION

AS BUILT ELEVATION




PROPOSED REAR ELEVATION

AS BUILT ELEVATION

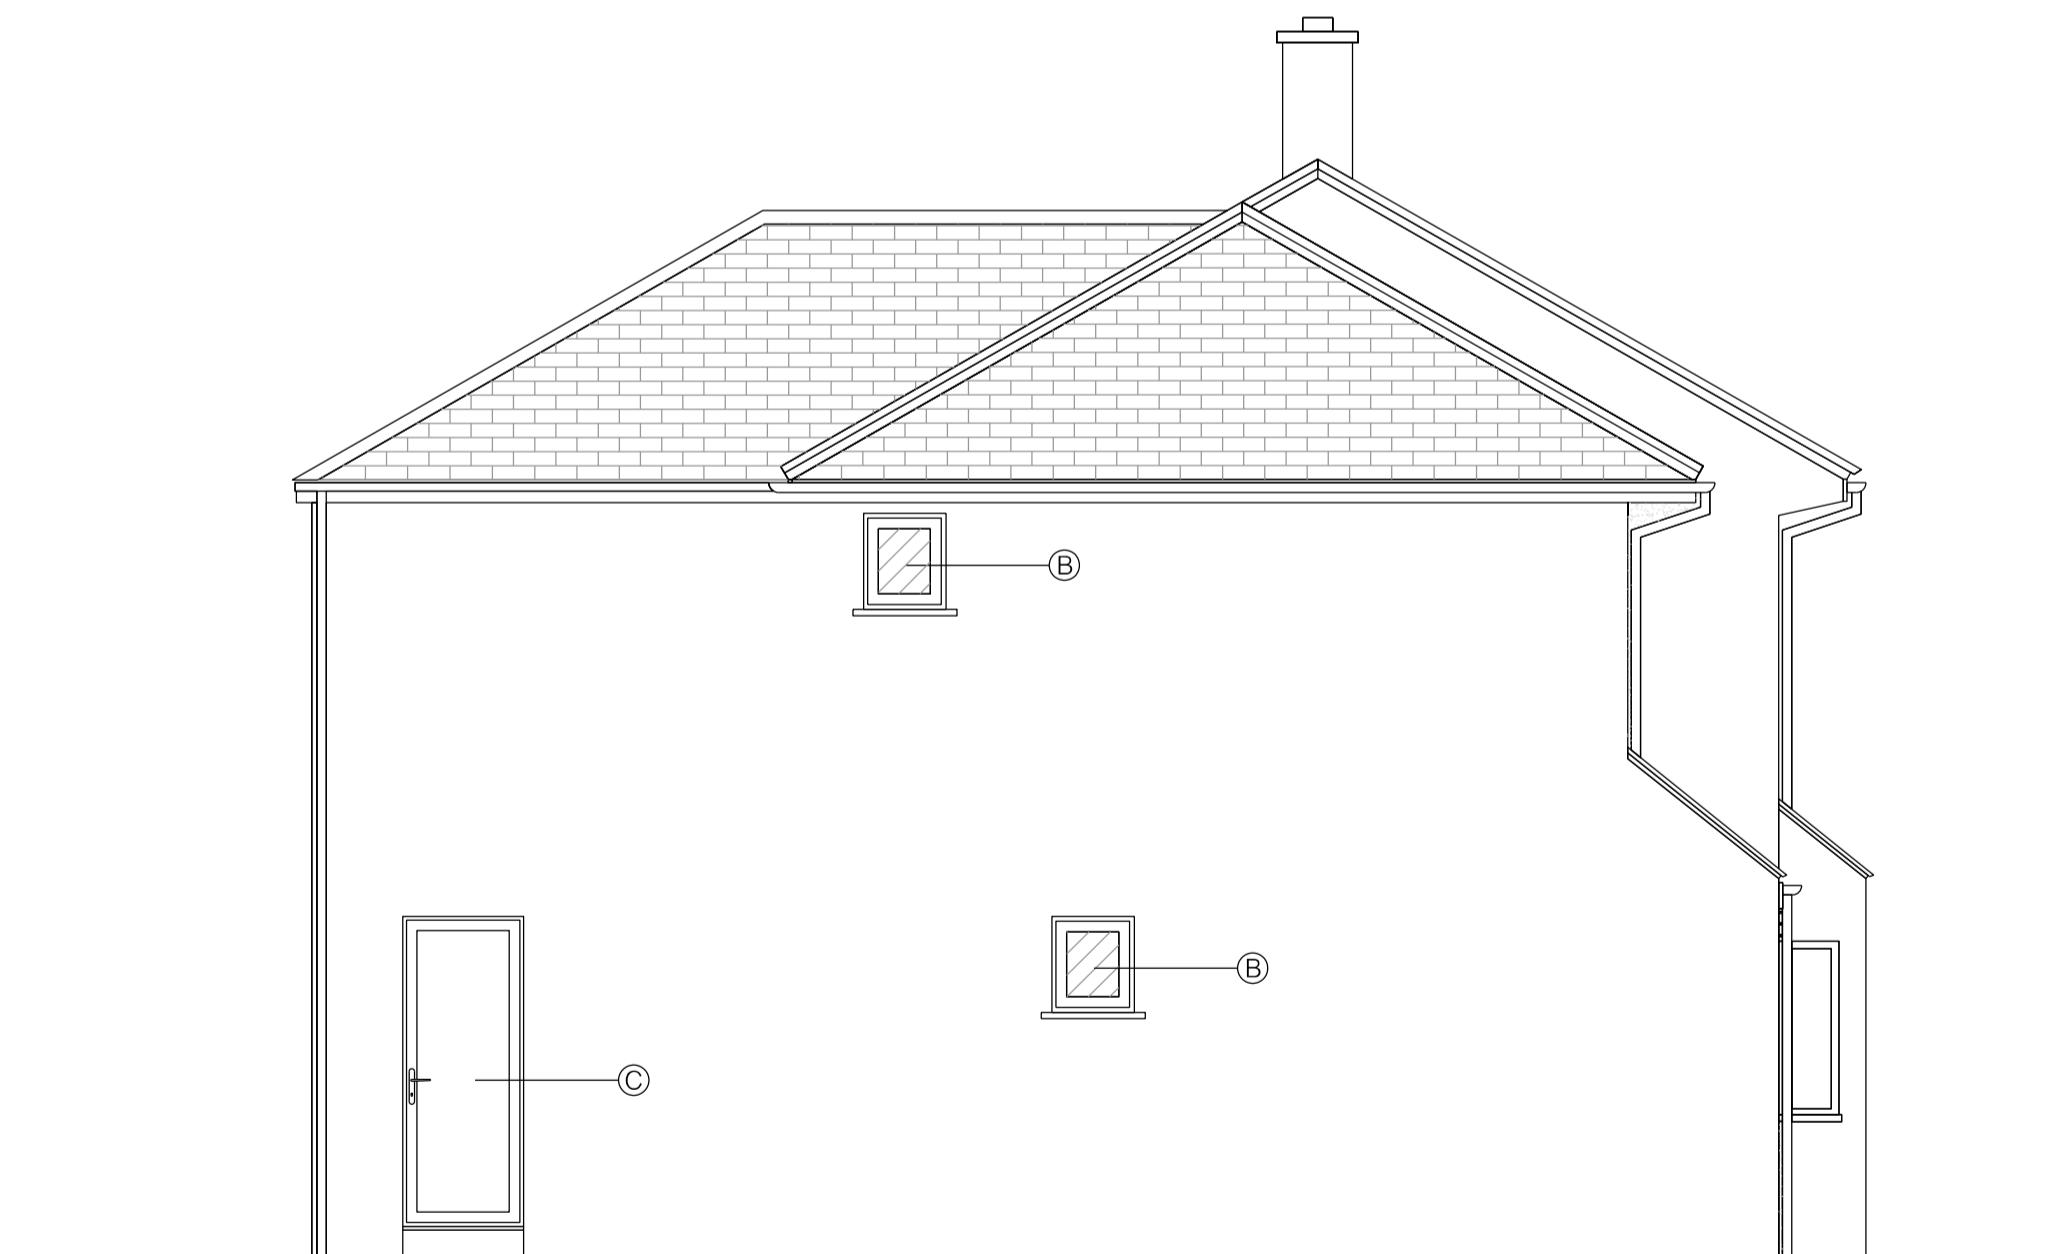

PROPOSED SIDE ELEVATION

AS BUILT ELEVATION

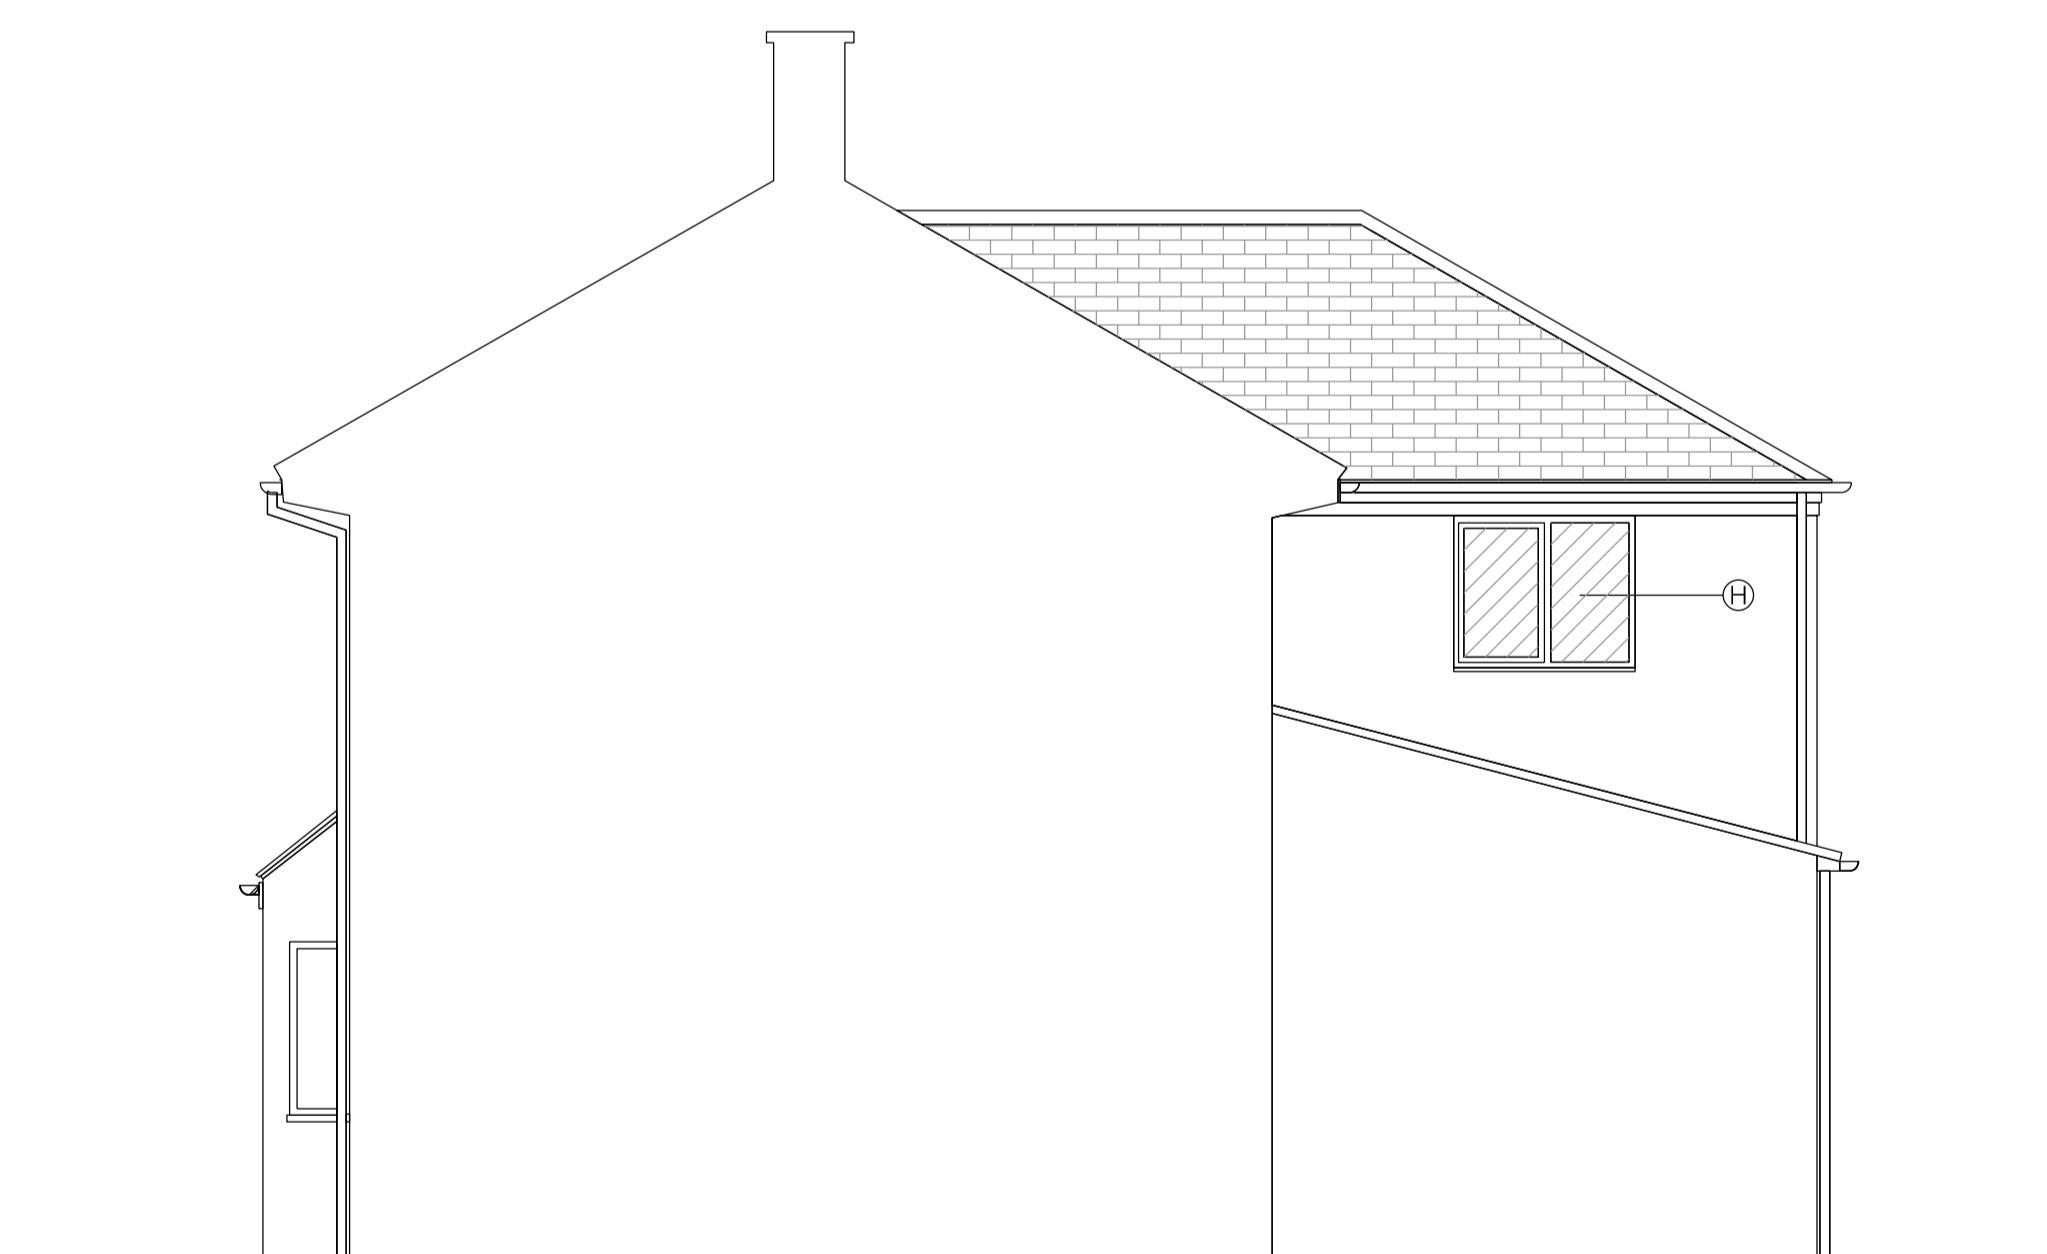

PROPOSED SIDE ELEVATION

AS BUILT ELEVATION

DESIGN REVISIONS	
(A)	Height of porch as per previous Approved Planning App (lower than neighbours porch height)
(B)	Bathroom windows facing neighbours to be made obscure
(C)	Installation of new kitchen door
(D)	Revised roof design to reflect original roof
(E)	Juliet Balcony
(F)	Width of rear first floor Increased to 5m (within the 45 degree angle of clearance).
(G)	Height of rear single storey extension within 4m height
(H)	Bedroom window facing neighbours to be made obscure

REVISIONS	DATE
atelier76	atelier76 limited
	50 Wellington Street Luton LU1 2SH 01582 651309 jag@atelier76.co.uk
TITLE	PROPOSED ELEVATIONS
ADDRESS	37 BRIDGE VILLAGE WESTERLY WYTON UB7 9AS
CLIENT	S. BAINS
SCALE	1:50 @ A1
DRAWING	AT1066/003BW
REV	