



PROPOSED ROOF PLAN

AS BUILT FLOOR PLAN

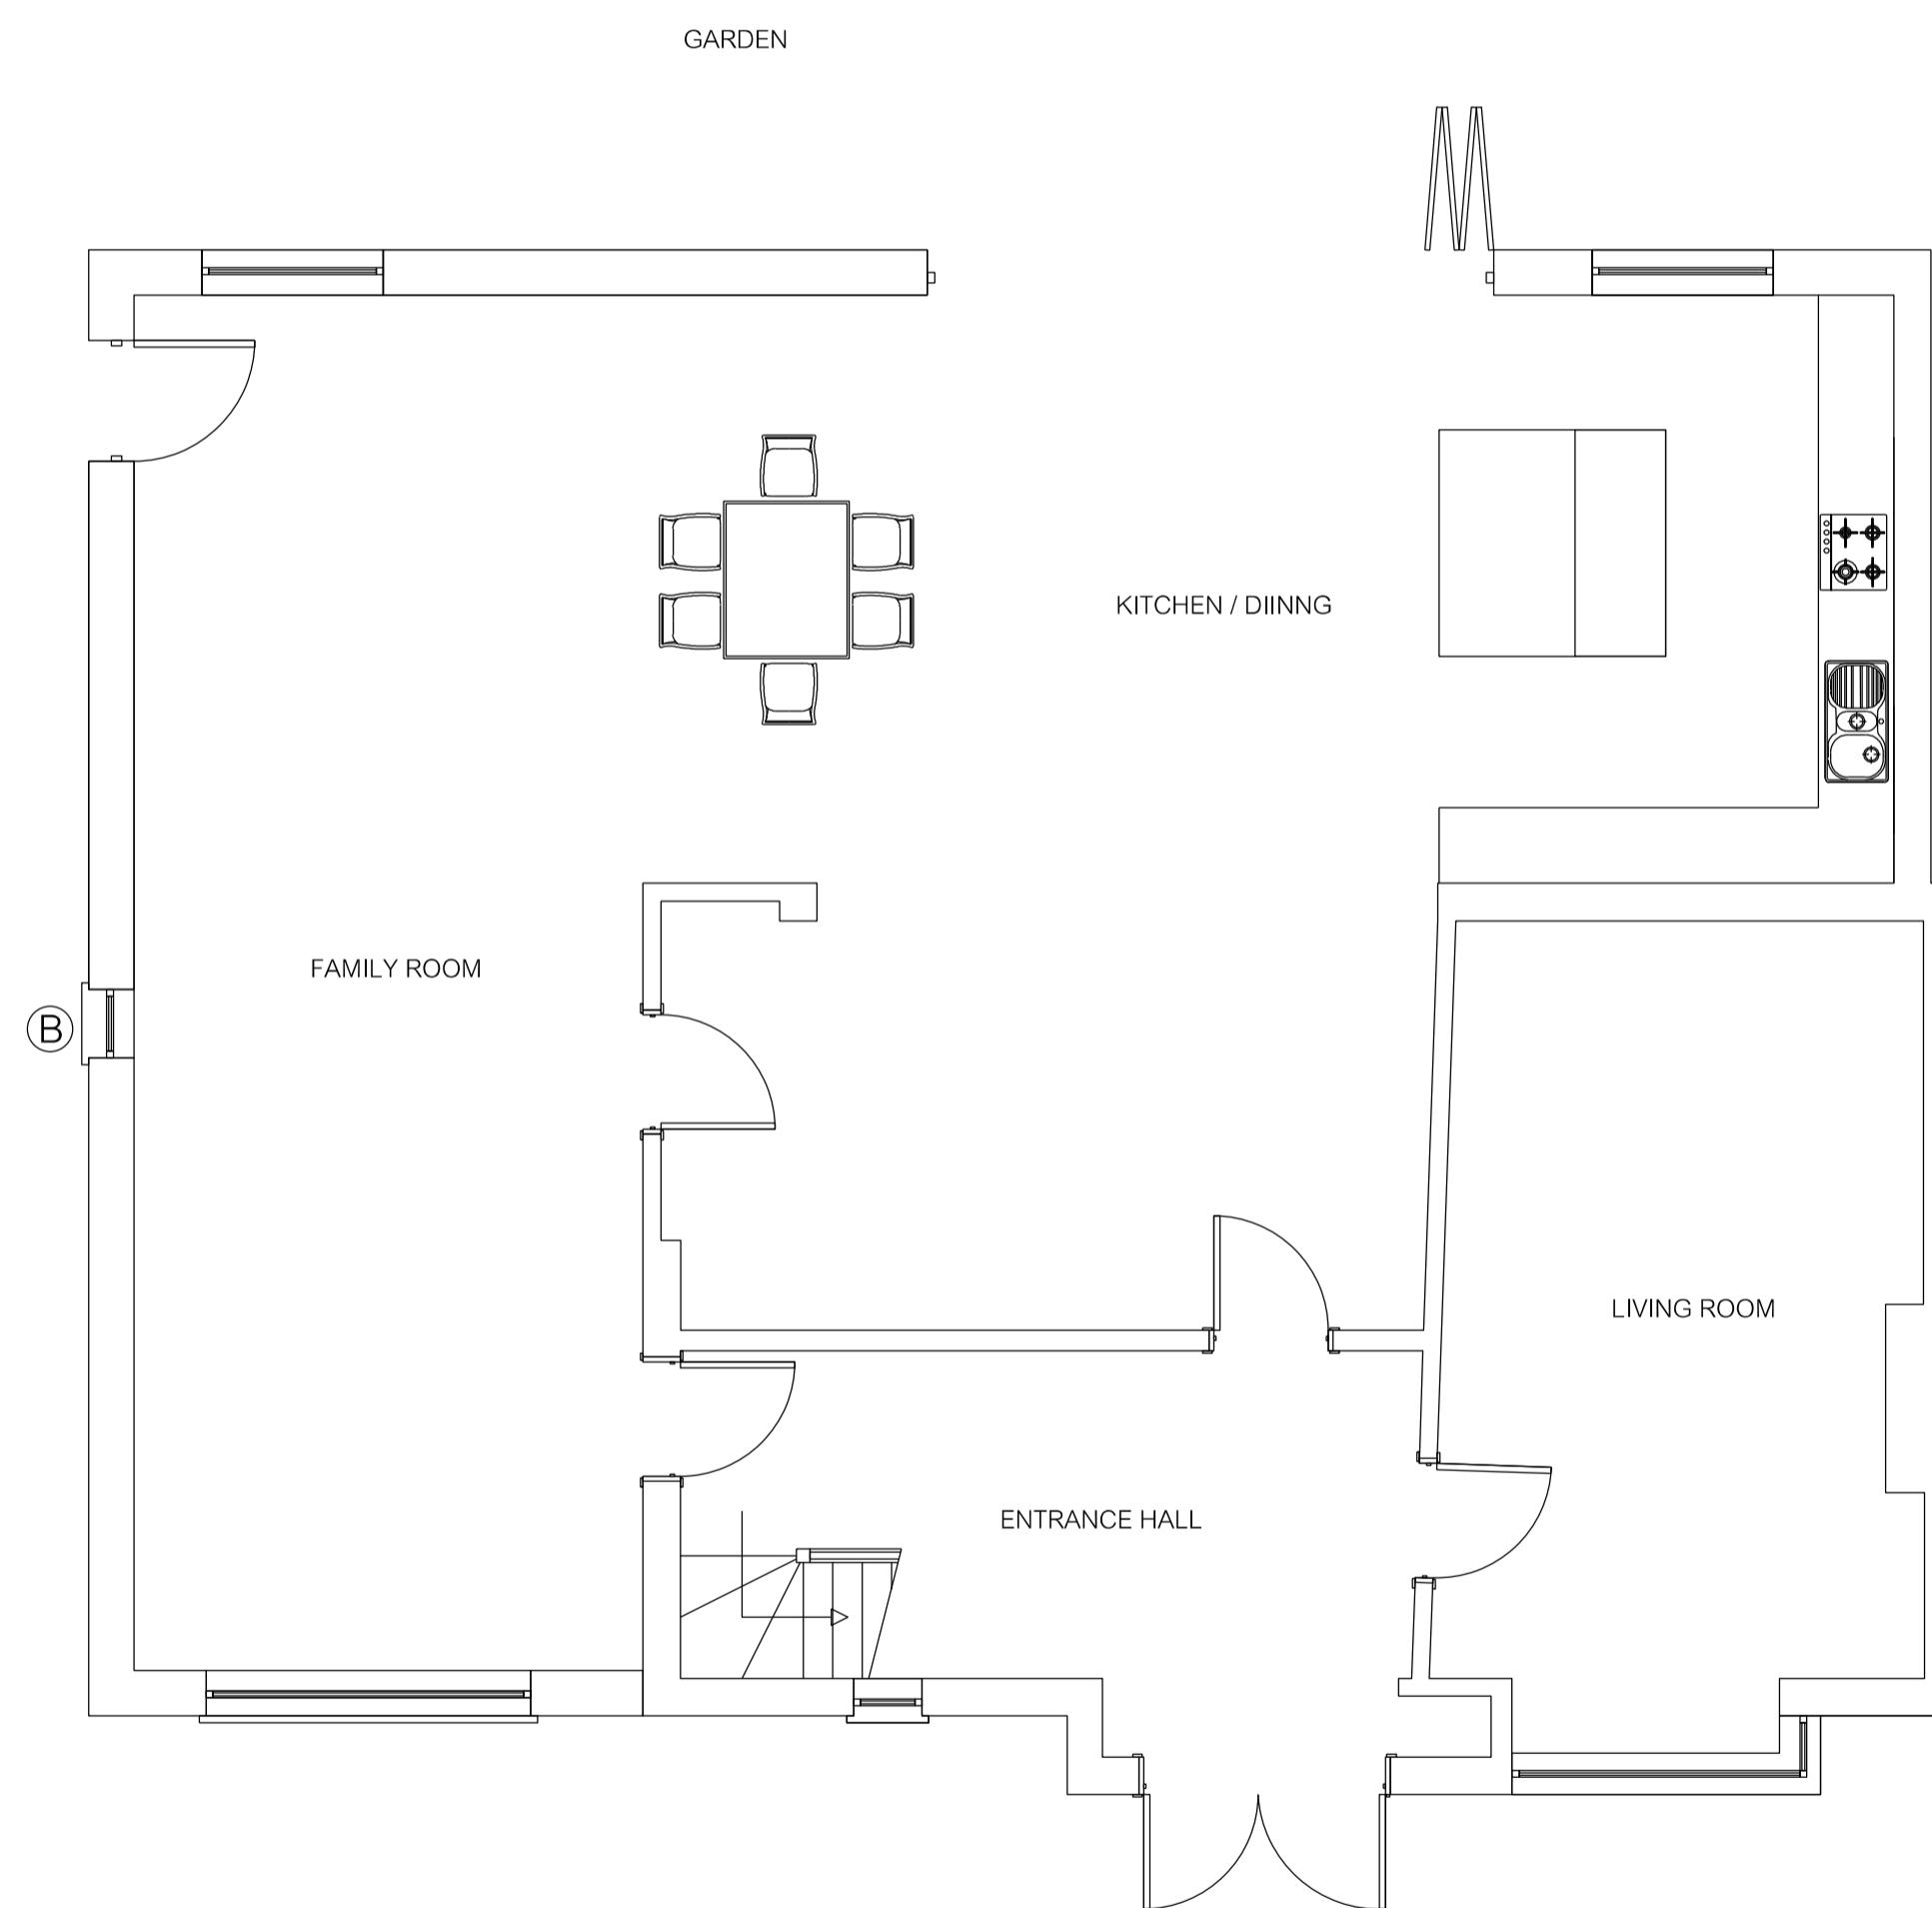

PROPOSED GROUND FLOOR PLAN

AS BUILT FLOOR PLAN

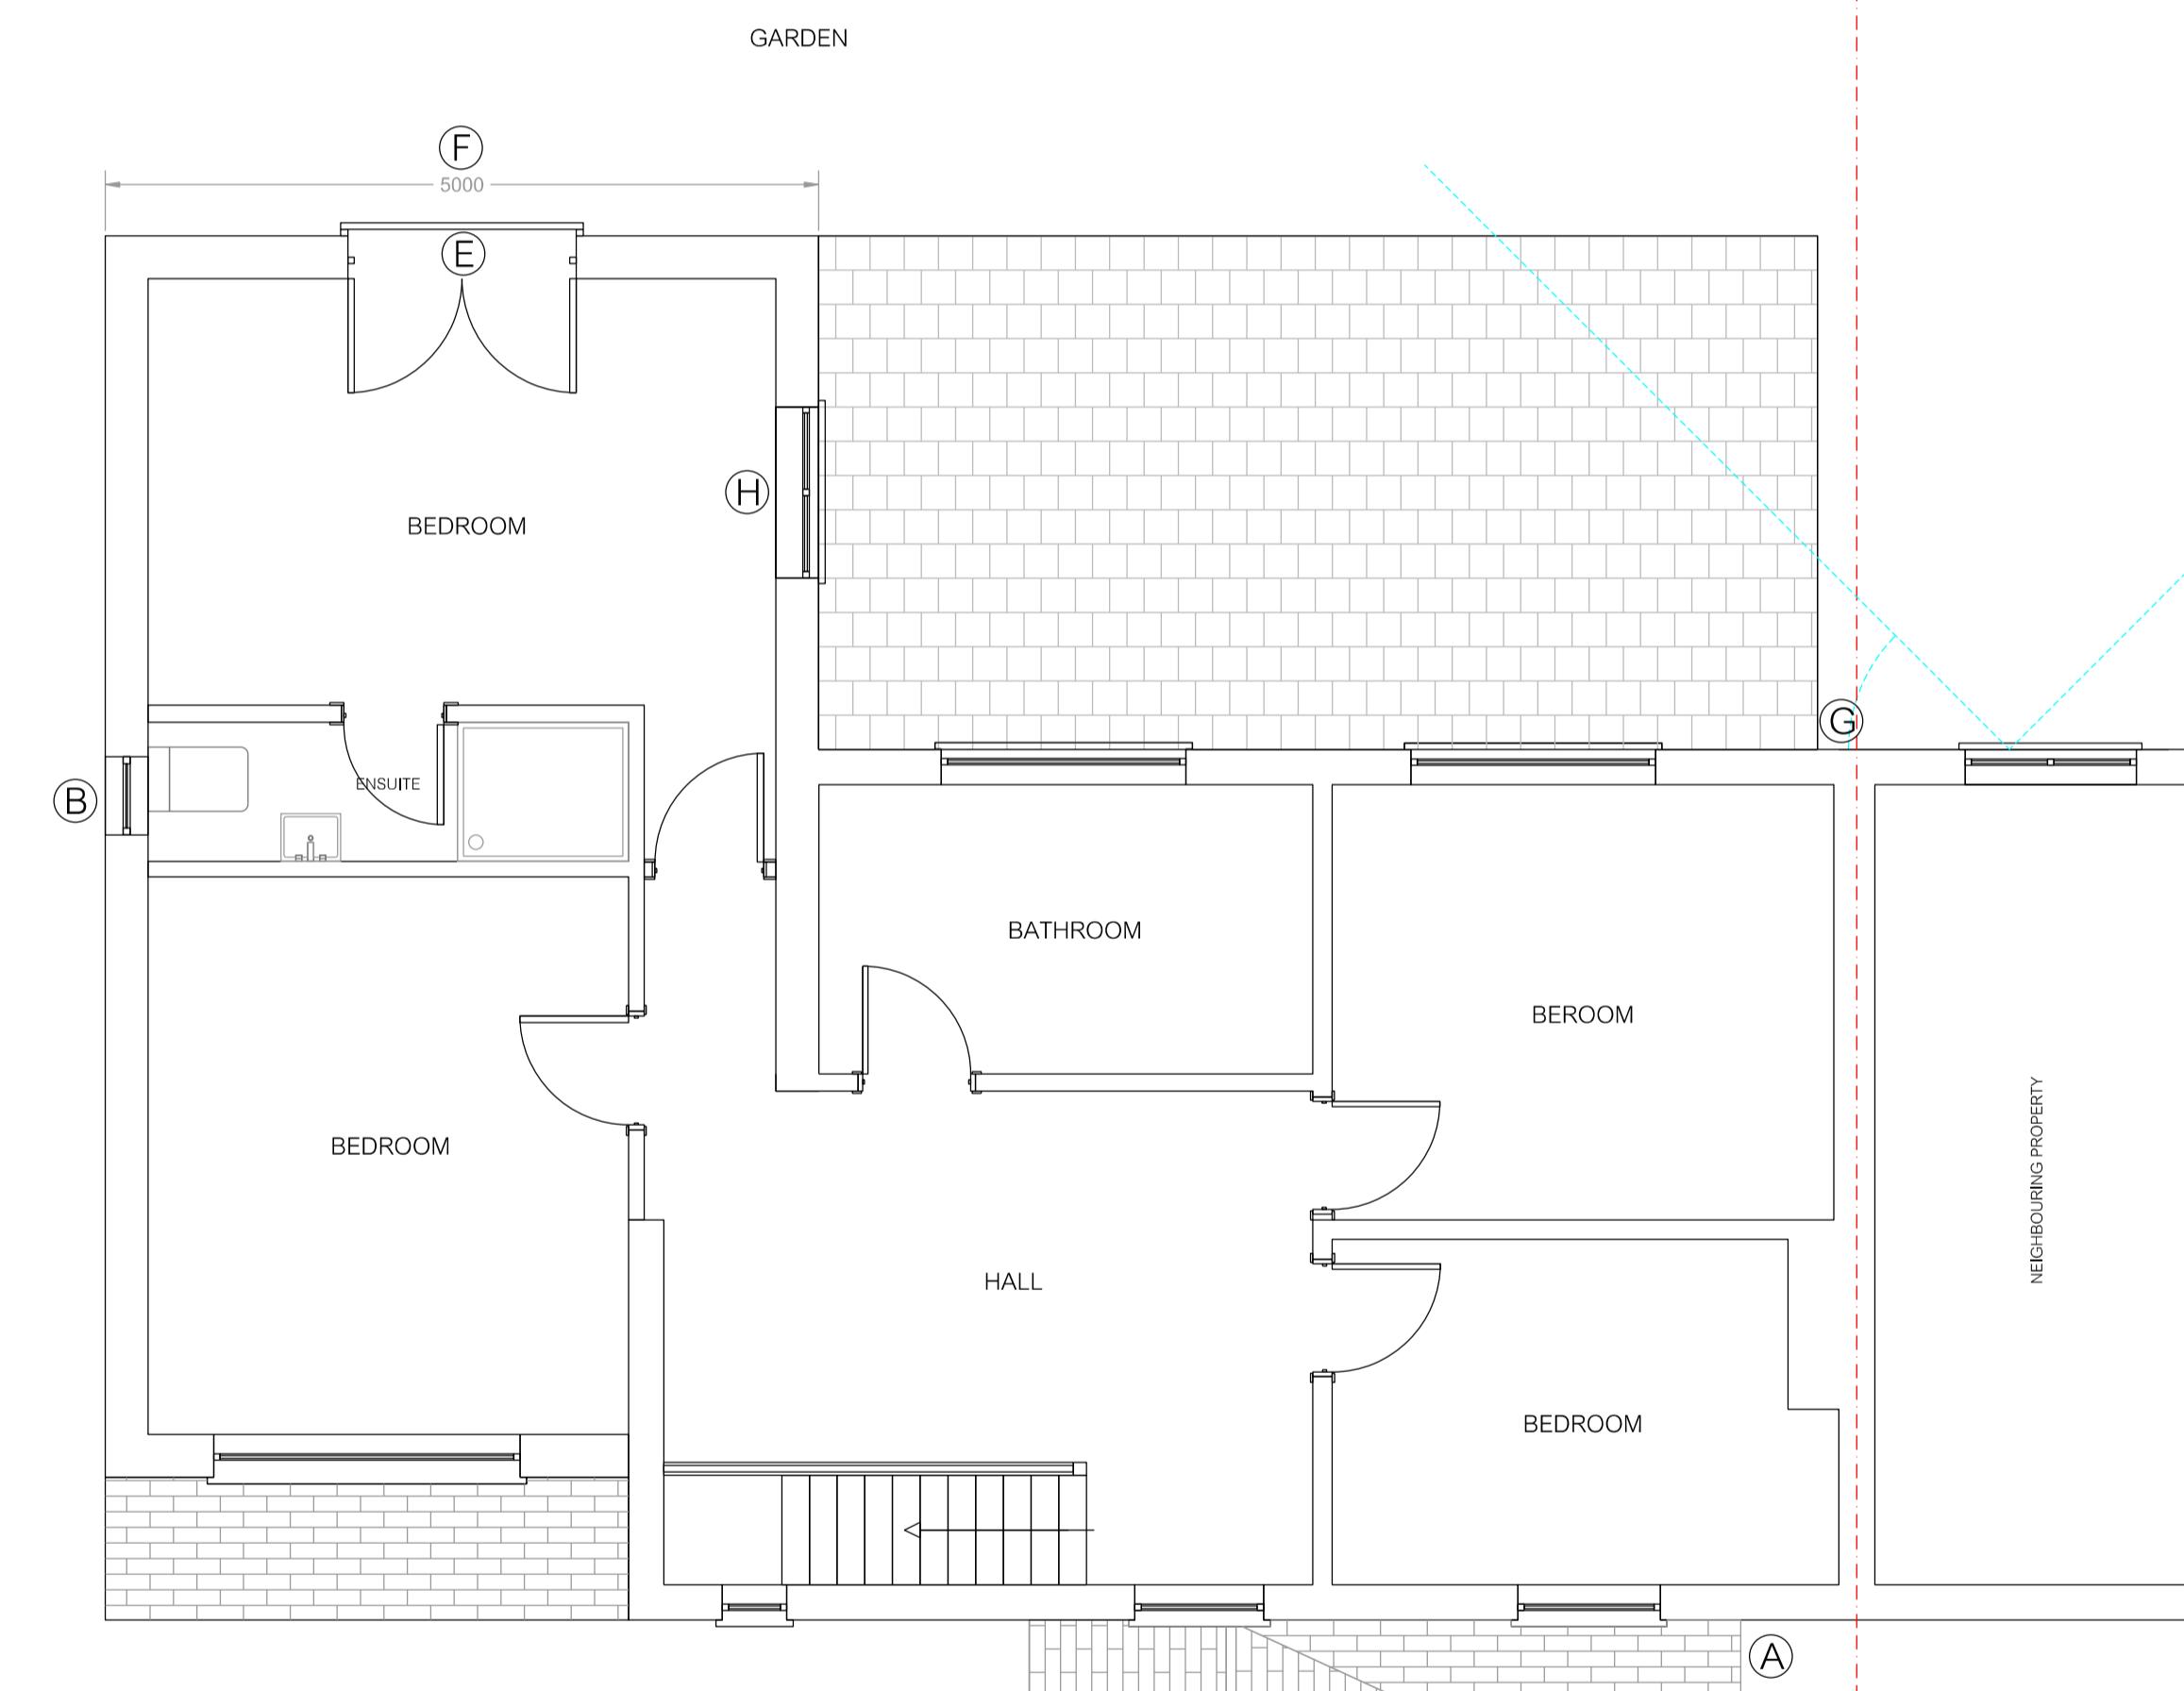

PROPOSED FIRST FLOOR PLAN

AS BUILT FLOOR PLAN

DESIGN REVISIONS	
(A)	Height of porch as per previous Approved Planning App (lower than neighbours porch height)
(B)	Bathroom windows facing neighbours to be made obscure
(C)	Installation of new kitchen door
(D)	Revised roof design to reflect original roof
(E)	Juliet Balcony
(F)	Width of rear first floor increased to 5m (within the 45 degree angle of clearance).
(G)	Height of rear single storey extension within 4m height
(H)	Bedroom window facing neighbours to be made obscure

REVISIONS	DATE
atelier76	atelier76limited
	50 Wellington Street Luton LU1 2SH 0152 589 1500 0152 587 307 je[at]atelier76.co.uk
TITLE	PROPOSED PLANS
ADDRESS	37 BROADWAY WEST GATTON UB7 9AS
CLIENT	S. BAINS
SCALE	1:50 @ A1 DRAWN JA DATE JUL 25
DRAWING	AT1066/004BW REV