


North




HTS DESIGN LIMITED
The copyright in this drawing is owned by HTS Design Ltd. All rights reserved.
Neither this drawing, nor any part of it, may be reproduced or transmitted in any
form or by any means, electrical or mechanical, including (without limitation)
by photo- copying, recording, or any information, storage or retrieval system
without prior permission from the owner.

Minor Material Amendment are-


- 1- formation of new glazed door to the rear garden.
- 2- Addition of door from the living room into the gallery.
- 3- Shower room formed in the gallery extension instead of the bedroom ensuite.

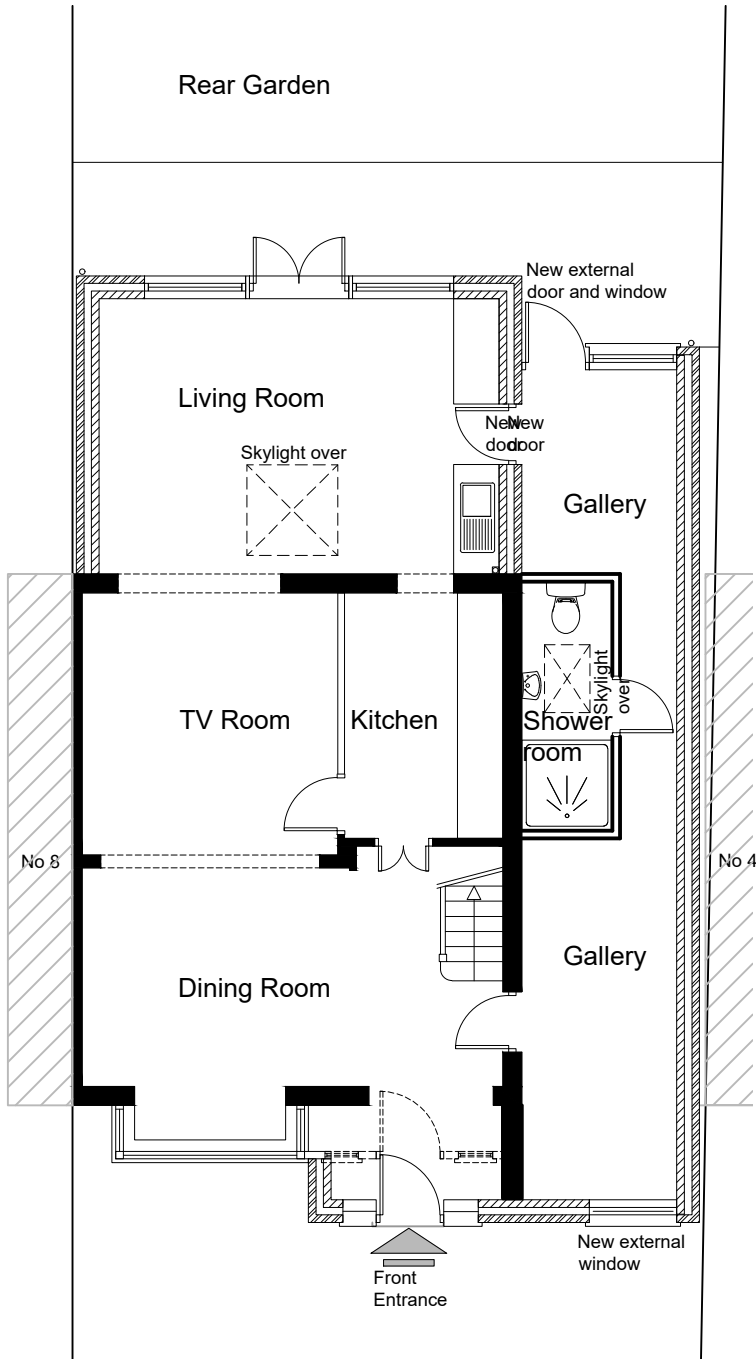

Proposed Ground Floor Plan- Sc 1:100

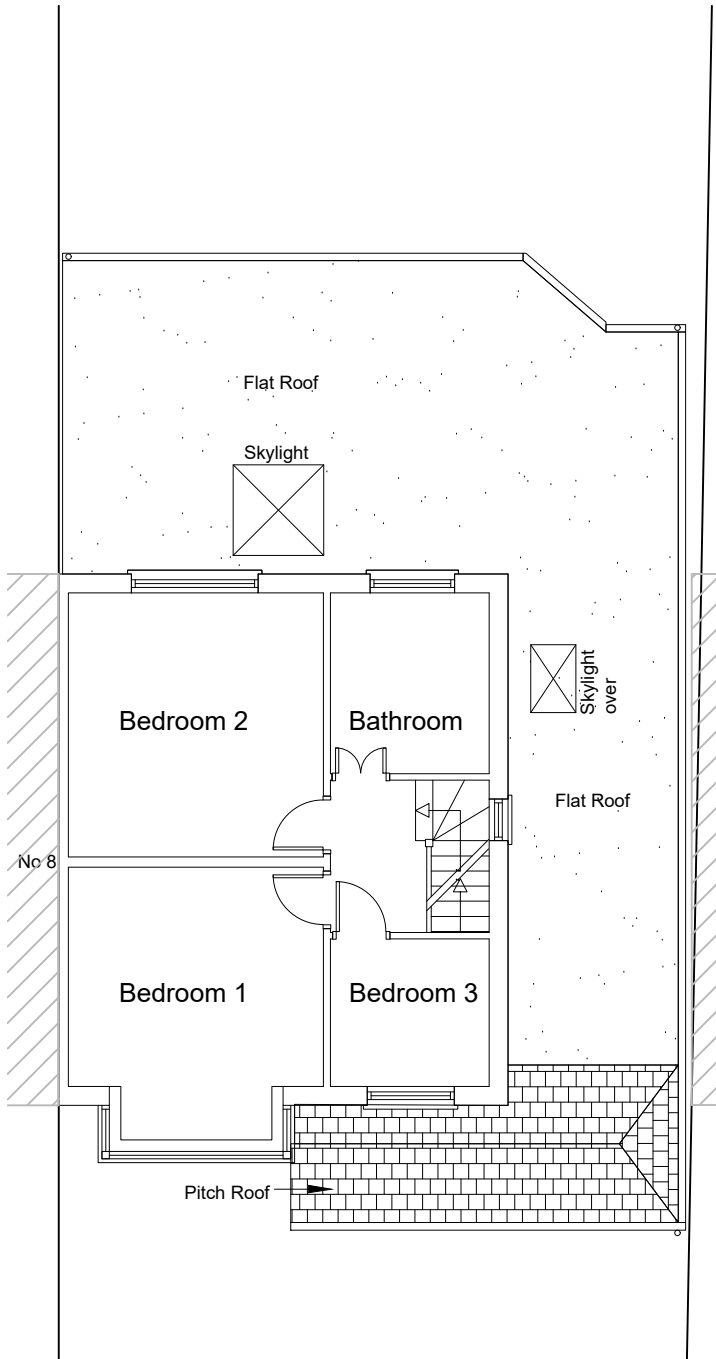

Proposed First Floor Plan- Sc 1:100

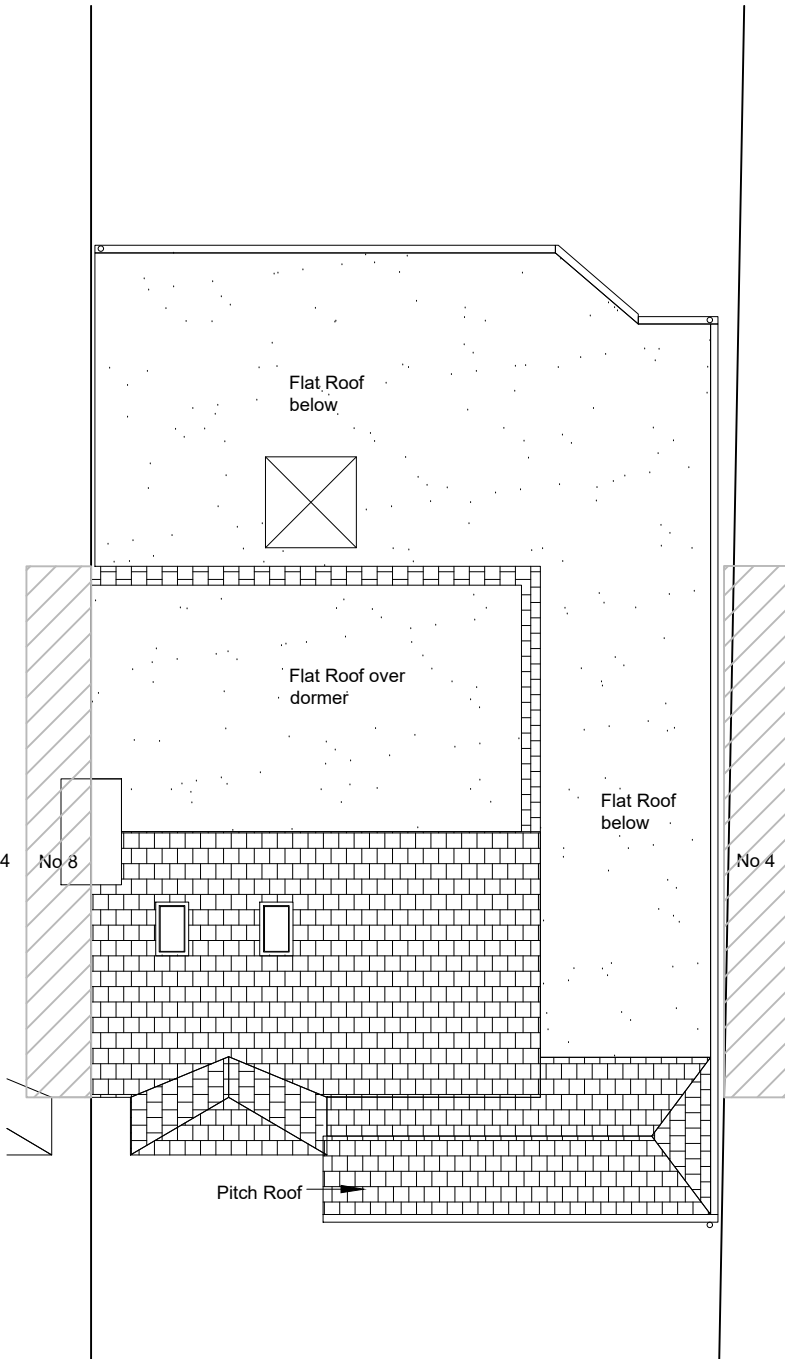

Proposed Roof Plan- Sc 1:100

A	Issued for minor material amendment	TR	SR	20-05-21
Rev	Revision details	Drwn	Chkd	Date

FEASIBILITY		BUILDING CONTROL	
DESIGN		TENDER	
BILLING		CONSTRUCTION	
PLANNING	X	AS BUILT	

	Signed	Date
Drawn:	TR	20-05-21
Designed:	TR	20-05-21
Checked:	SR	20-05-21
Buildability:		

HTS DESIGN LIMITED
ARCHITECTURAL CONSULTANT/ PROJECT MANAGEMENT
29 ARCHDALE PLACE,
NEW MALDEN,
SURREY KT3 3RW
TEL: 020 8549 4733
FAX: 020 8549 4733
MOBILE: 07930 949 313
EMAIL: talaat.ramadan@htsdesign.org.uk



Client

Ms. S Rahimi

Project Name

**6 Charnwood Road
Uxbridge
UB10 0HX**

Drawing Title

**Proposed Floor and Roof Plans
As agreed with the Enforcement
Officer**

Drawing No	Scale @ A3	Rev
121/A/SK103	1:100	A