





Existing Front Elevation- Sc 1:100



Existing Rear Elevation- Sc 1:100

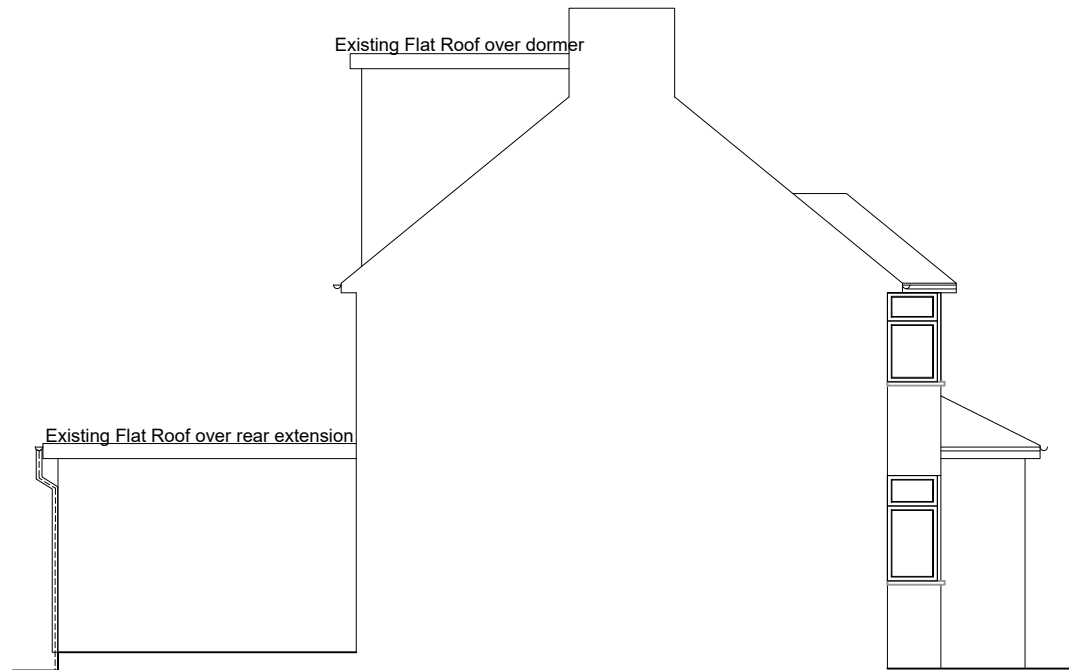

Existing Side Elevation Abutting Nos. 8- Sc 1:100

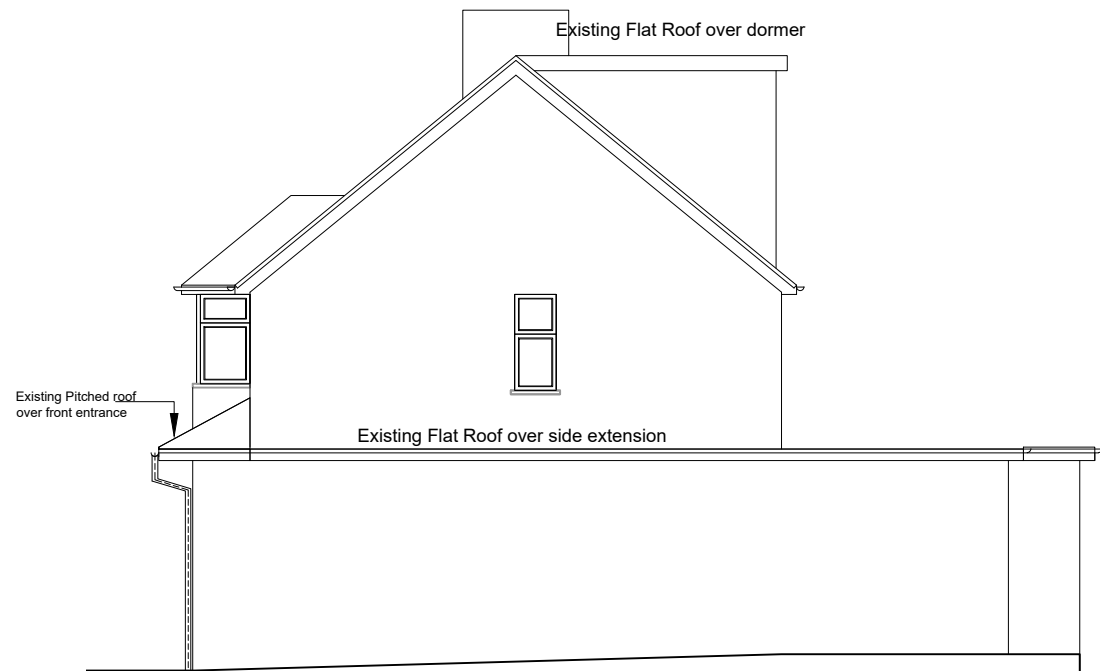

Existing Side elevation- Sc 1:100

HTS DESIGN LIMITED
The copyright in this drawing is owned by HTS Design Ltd. All rights reserved. Neither this drawing, nor any part of it, may be reproduced or transmitted in any form or by any means, electrical or mechanical, including (without limitation) by photo-copying, recording, or any information, storage or retrieval system without prior permission from the owner.

A	Existing Elevations (As Built) Issued for Planning Application	TR	SR	30-06-21
Rev	Revision details	Drwn	Chkd	Date

FEASIBILITY		BUILDING CONTROL	
DESIGN		TENDER	
BILLING		CONSTRUCTION	
PLANNING	X	AS BUILT	

	Signed	Date
Drawn:	TR	20-05-21
Designed:	TR	20-05-21
Checked:	SR	20-05-21
Buildability:		

HTS DESIGN LIMITED
ARCHITECTURAL CONSULTANT/ PROJECT MANAGEMENT
29 ARCHDALE PLACE,
NEW MALDEN,
SURREY KT3 3RW
TEL: 020 8549 4733
FAX: 020 8549 4733
MOBILE: 07930 949 313
EMAIL: talaat.ramadan@htsdesign.org.uk



Client

Ms. S Rahimi

Project Name

**6 Charnwood Road
Uxbridge
UB10 0HX**

Drawing Title

**Existing Elevations
As Built**

Drawing No SK/A/202	Scale @ A3 1:100	Rev A
-------------------------------	----------------------------	-----------------