

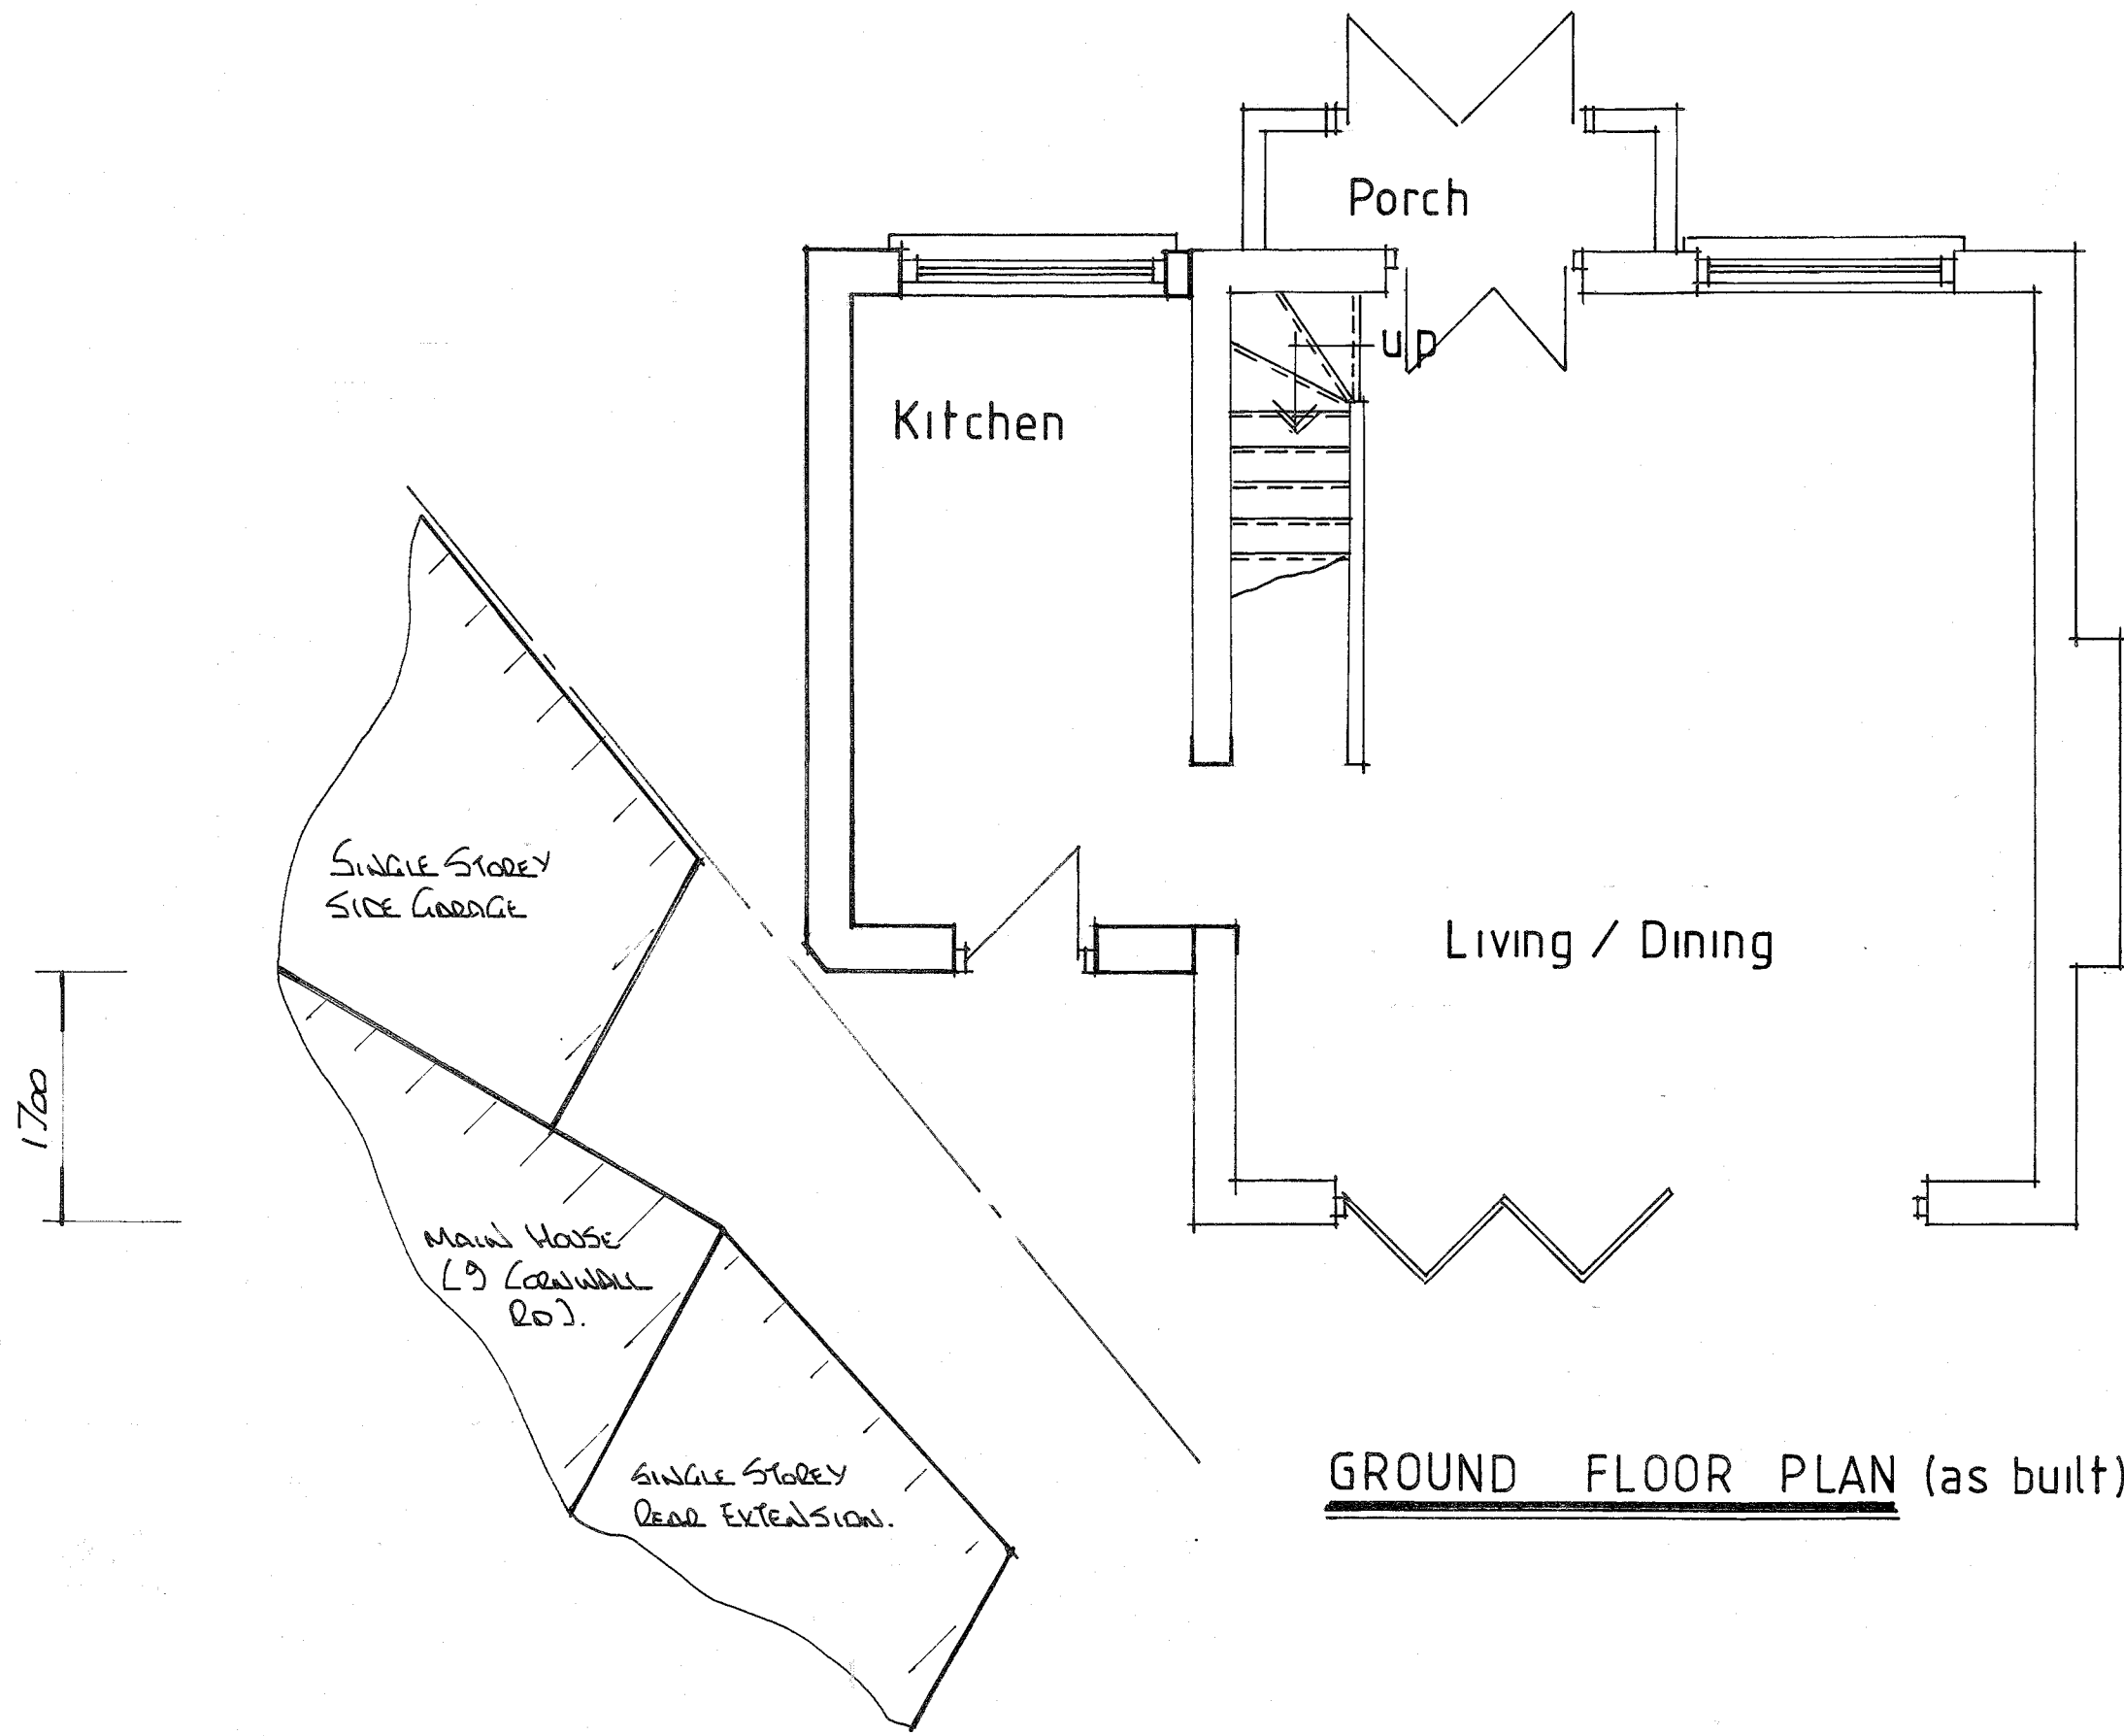


NOTES:
All dimensions must be checked on site and not scaled from this drawing.

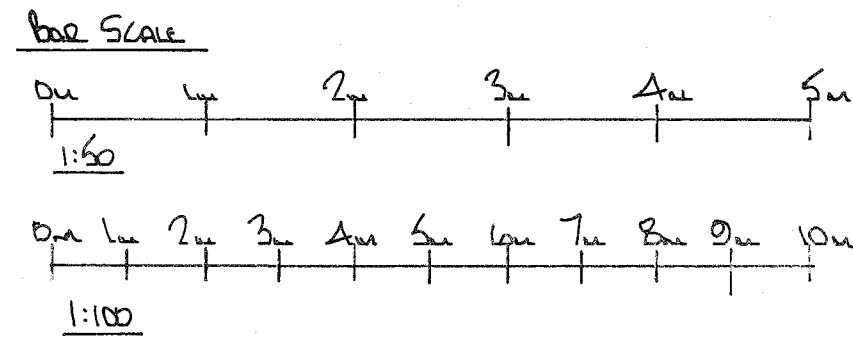

GROUND FLOOR PLAN (as built)

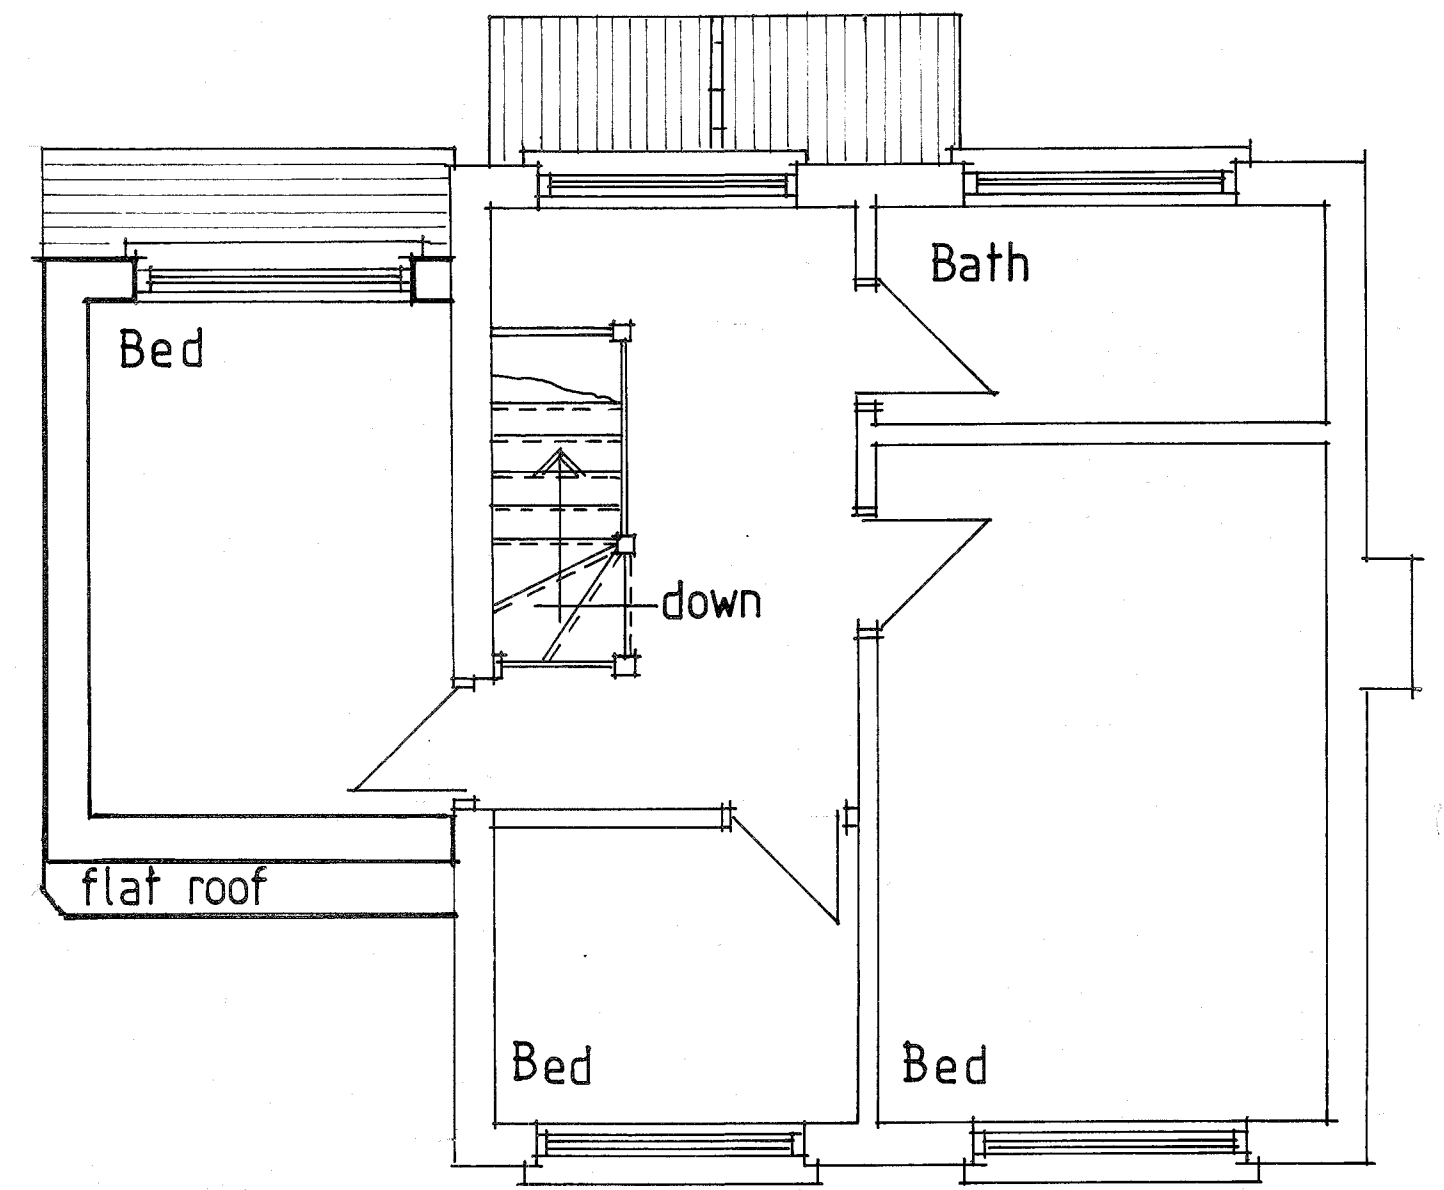


FIRST FLOOR PLAN (as built - no change from as approved)

THIS DRAWING TO BE READ
IN CONJUNCTION WITH DRG
No 4620 /01

ALL MATERIALS TO MATCH EXISTING




FRONT ELEVATION (no change - as approved)

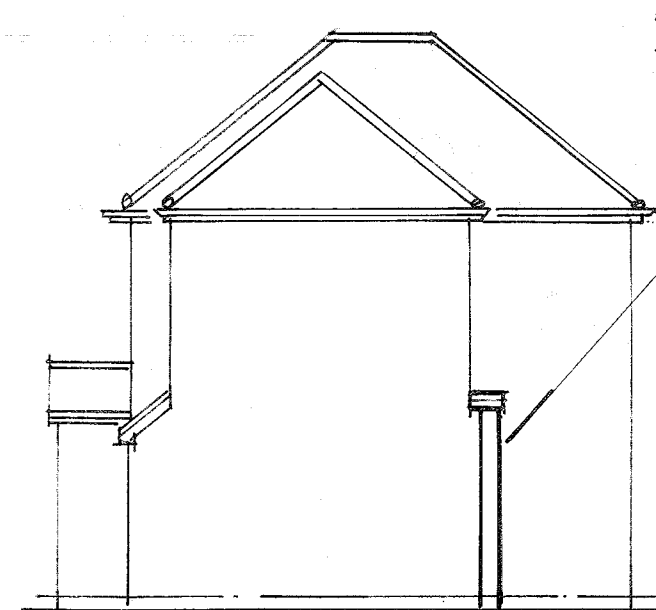


SIDE ELEVATION

Nominal Rear Ground Floor
Extension Enlargement
From that previously
approved (Planning Ref
No 74955/0001202/010)

Tot of Front Roof
3000
1/4 x
Ground L.L.

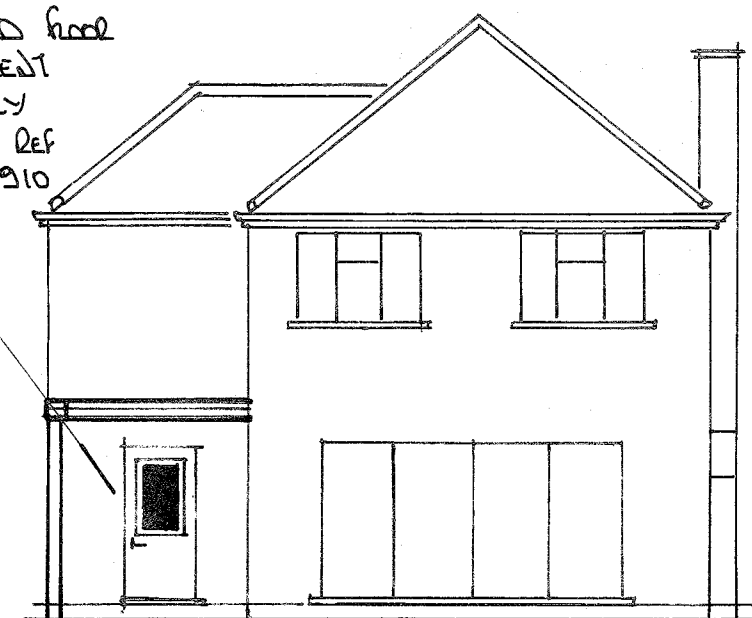

REAR ELEVATION

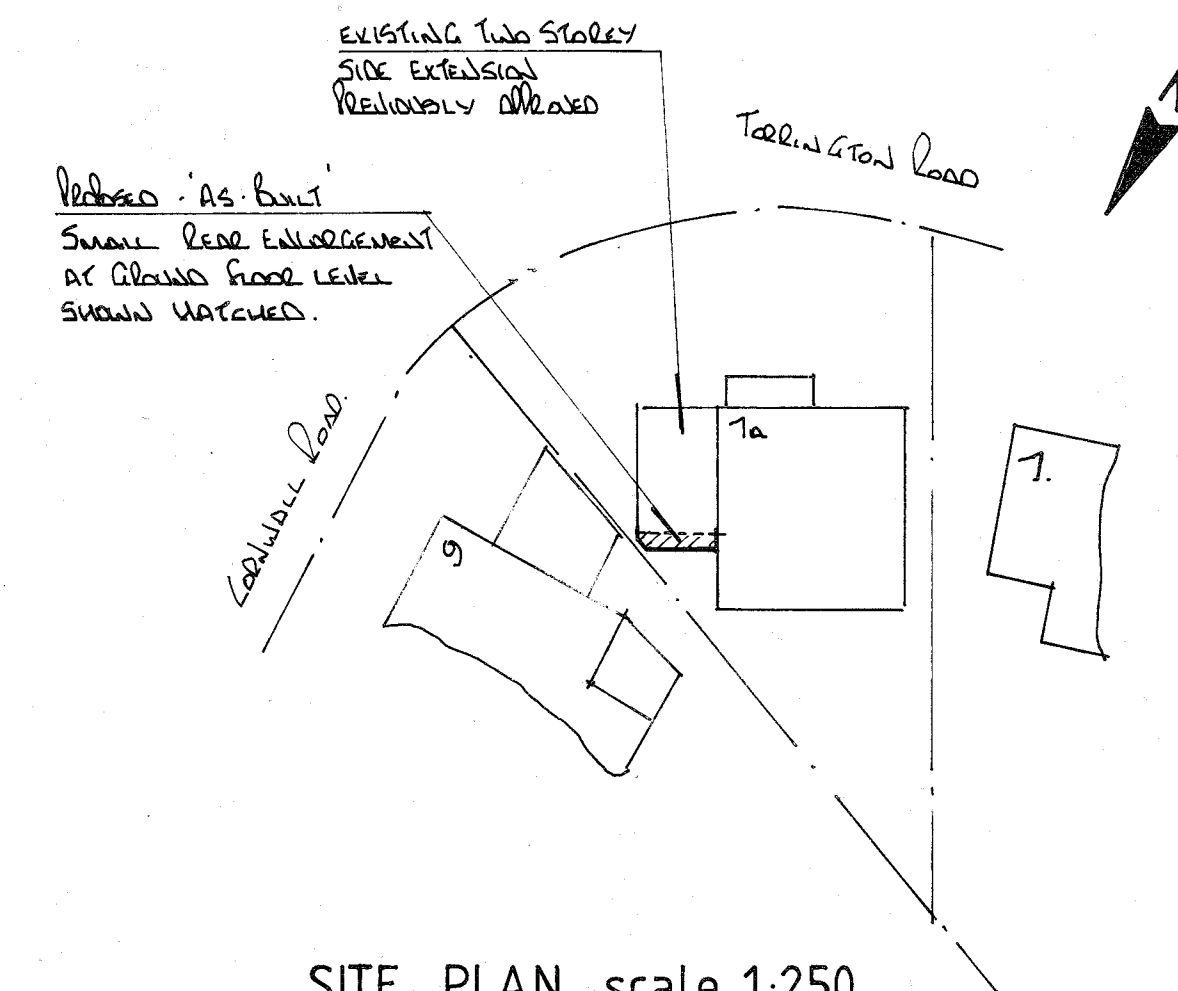

SITE PLAN scale 1:250

A	Date	Revisions

© copyright

Pottle & Co Ltd
Planning & Building Consultants
Suite A, 128 Manor Way
Ruislip, Middlesex, HA4 8HR
Tel: 01895 622800
www.pottle.uk.com

Client
MR MRS REKA

Job Title
**7A CORNWALL ROAD
RUISLIP
MIDDXX**

Drawing Title
**RETROSPECTIVE
PLANNING APPLICATION
(nominal rear ground floor
enlargement)**

Scale 1:100, 50, 250.

Date November 2021 Drawn by GEL

Drg No. **4620 /02** Rev.