

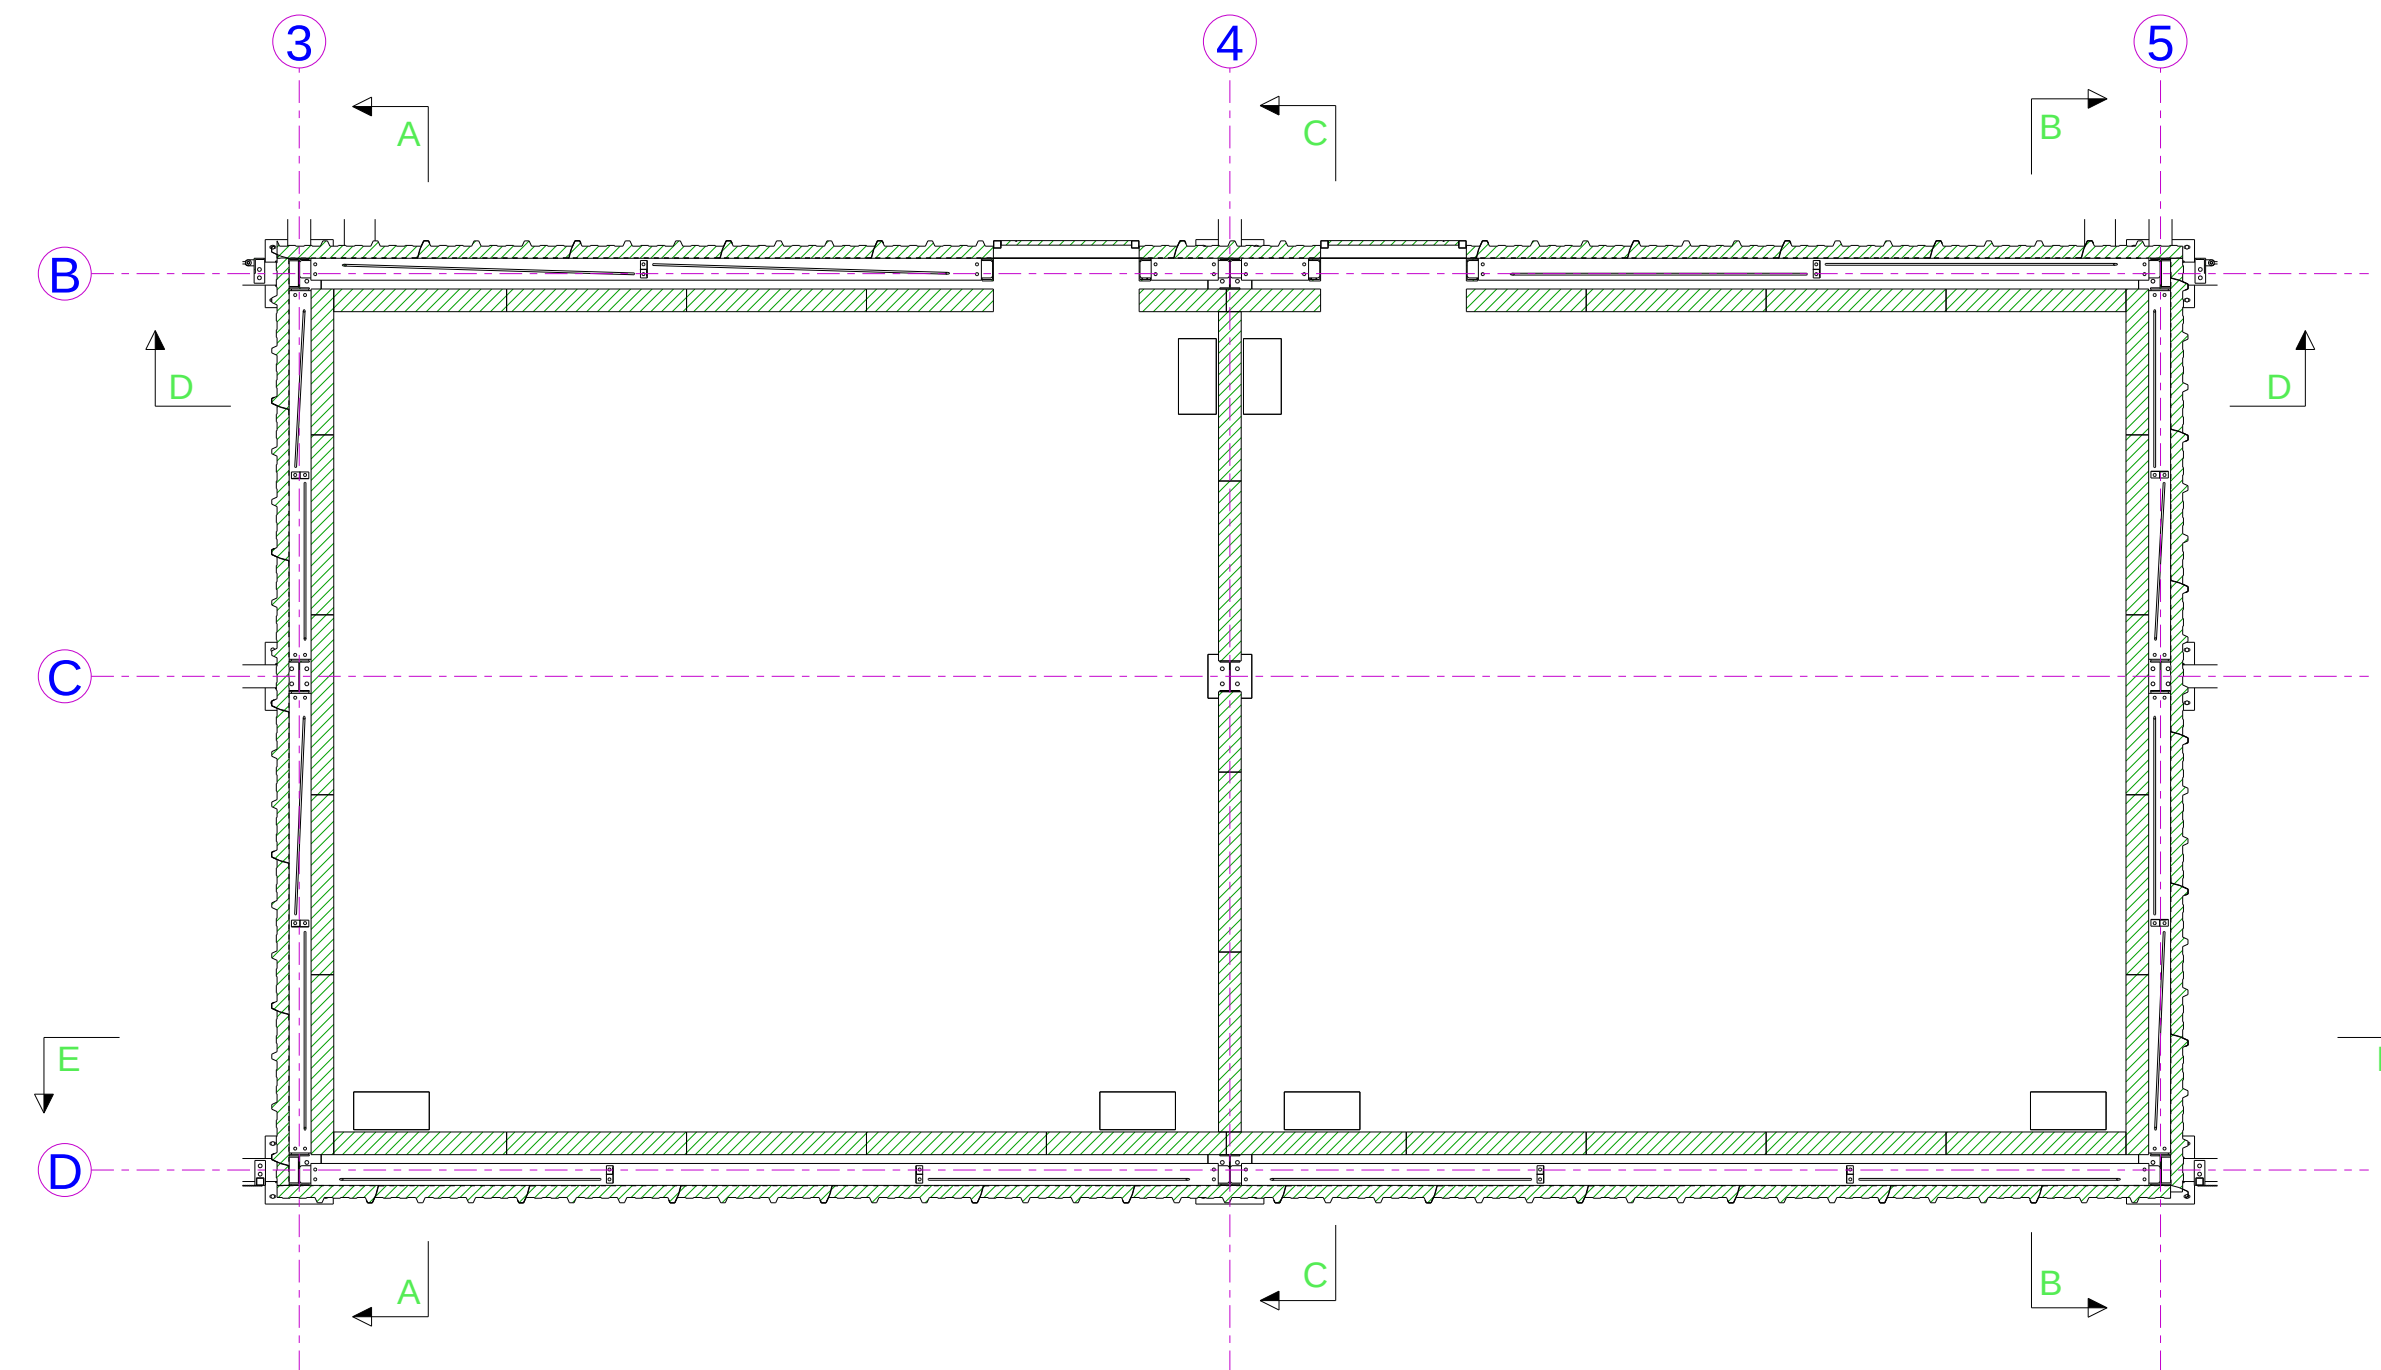
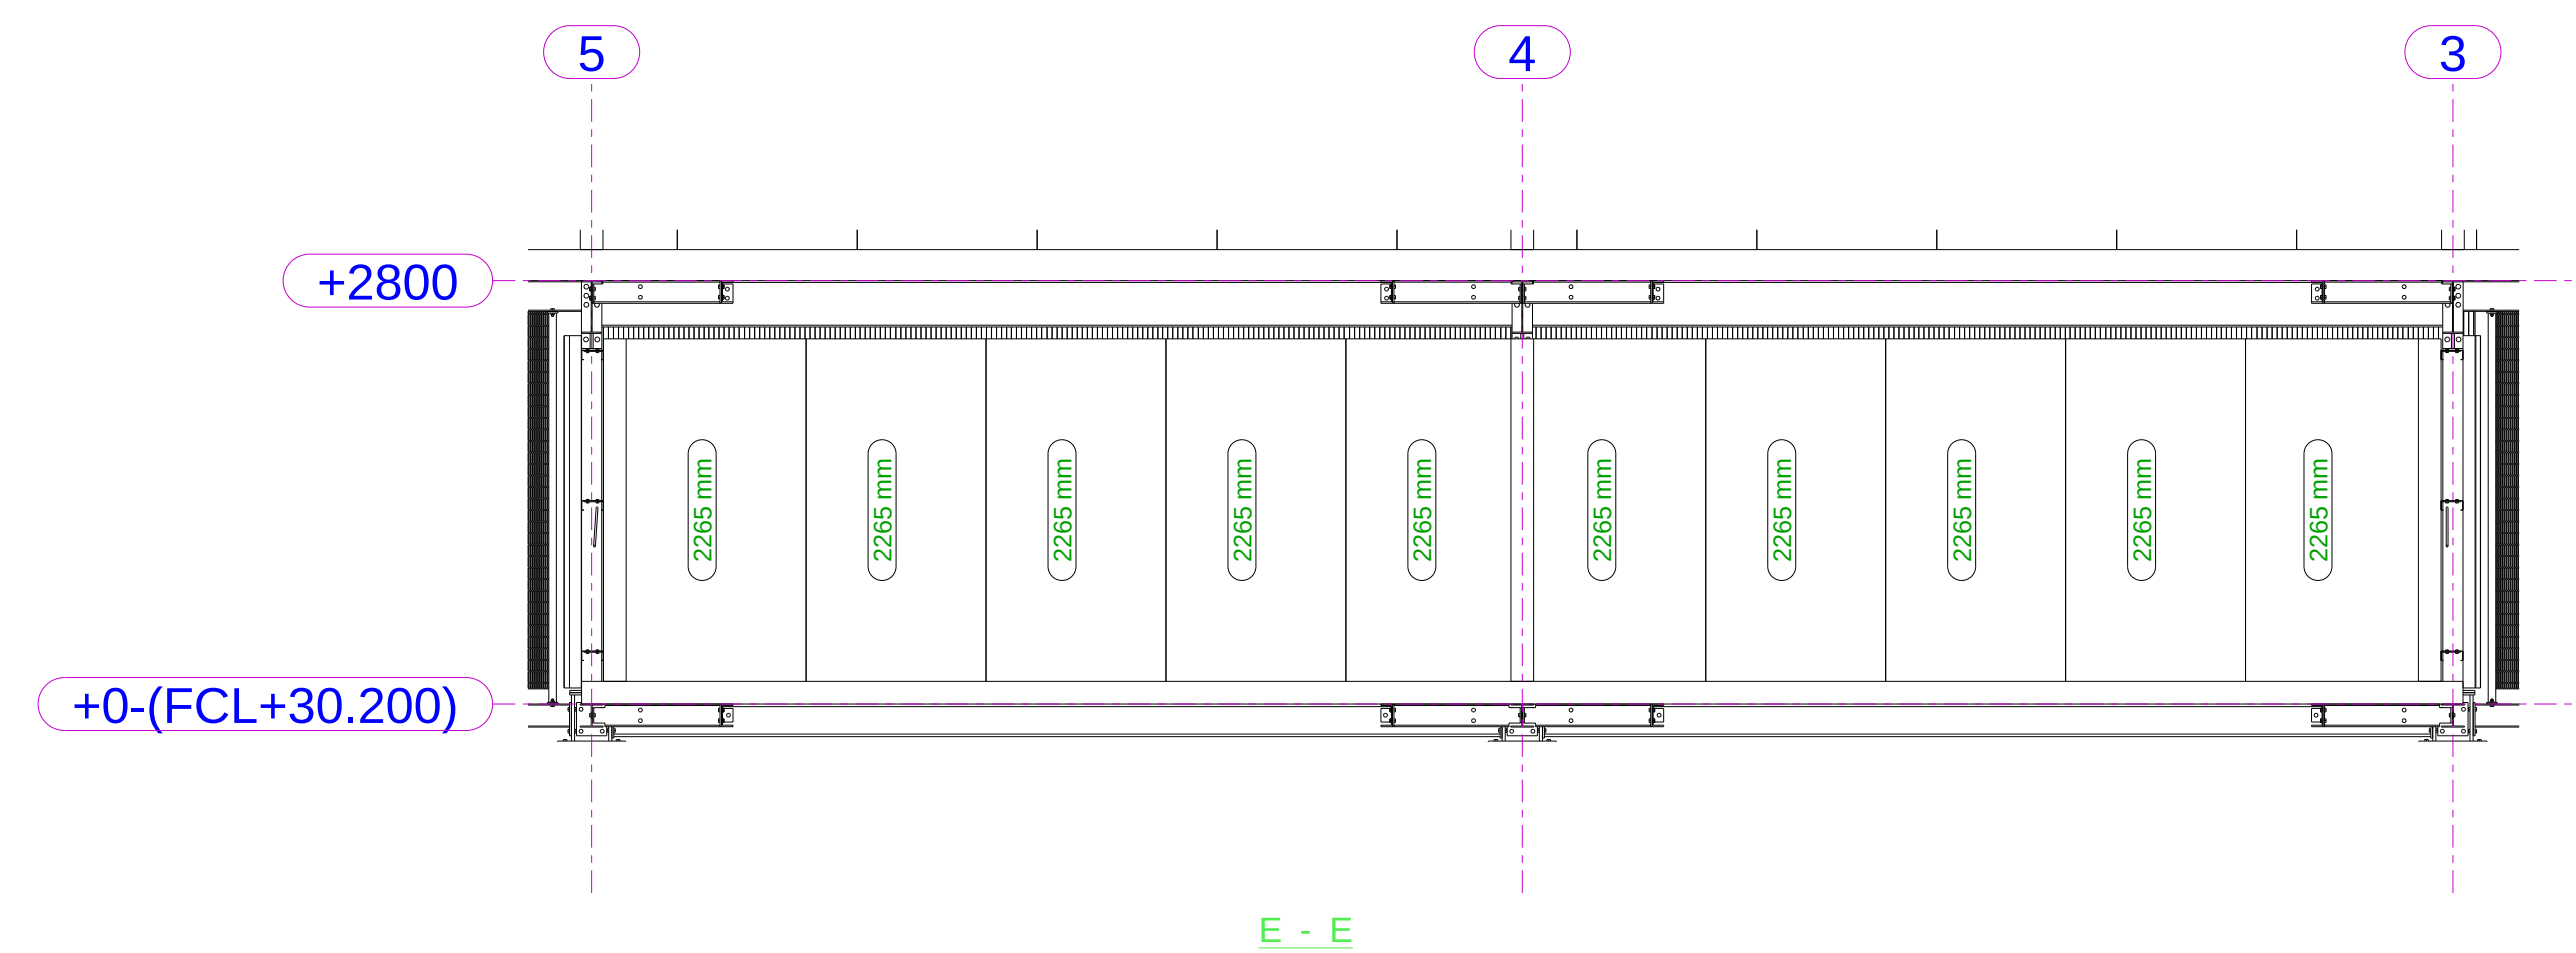
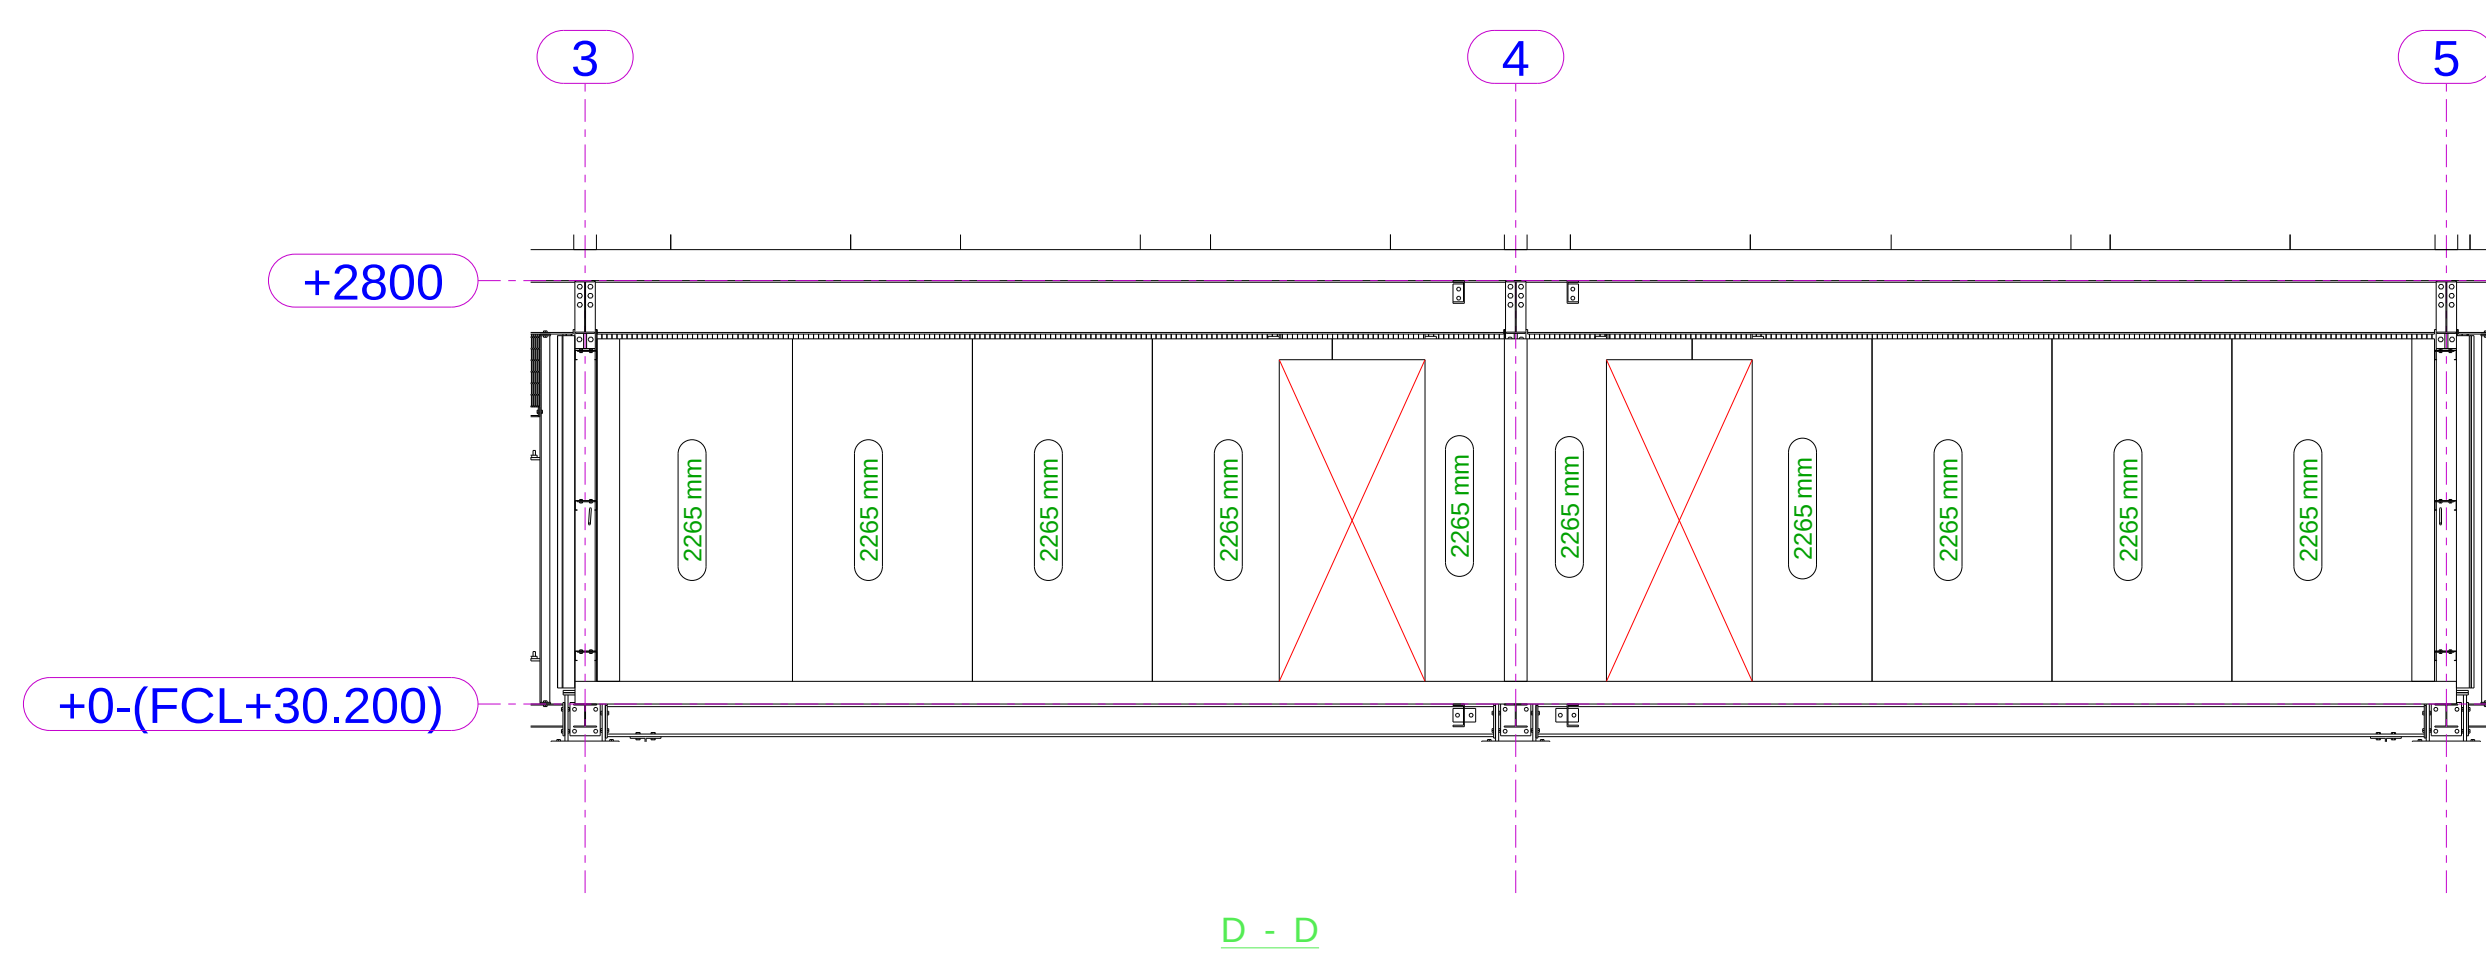
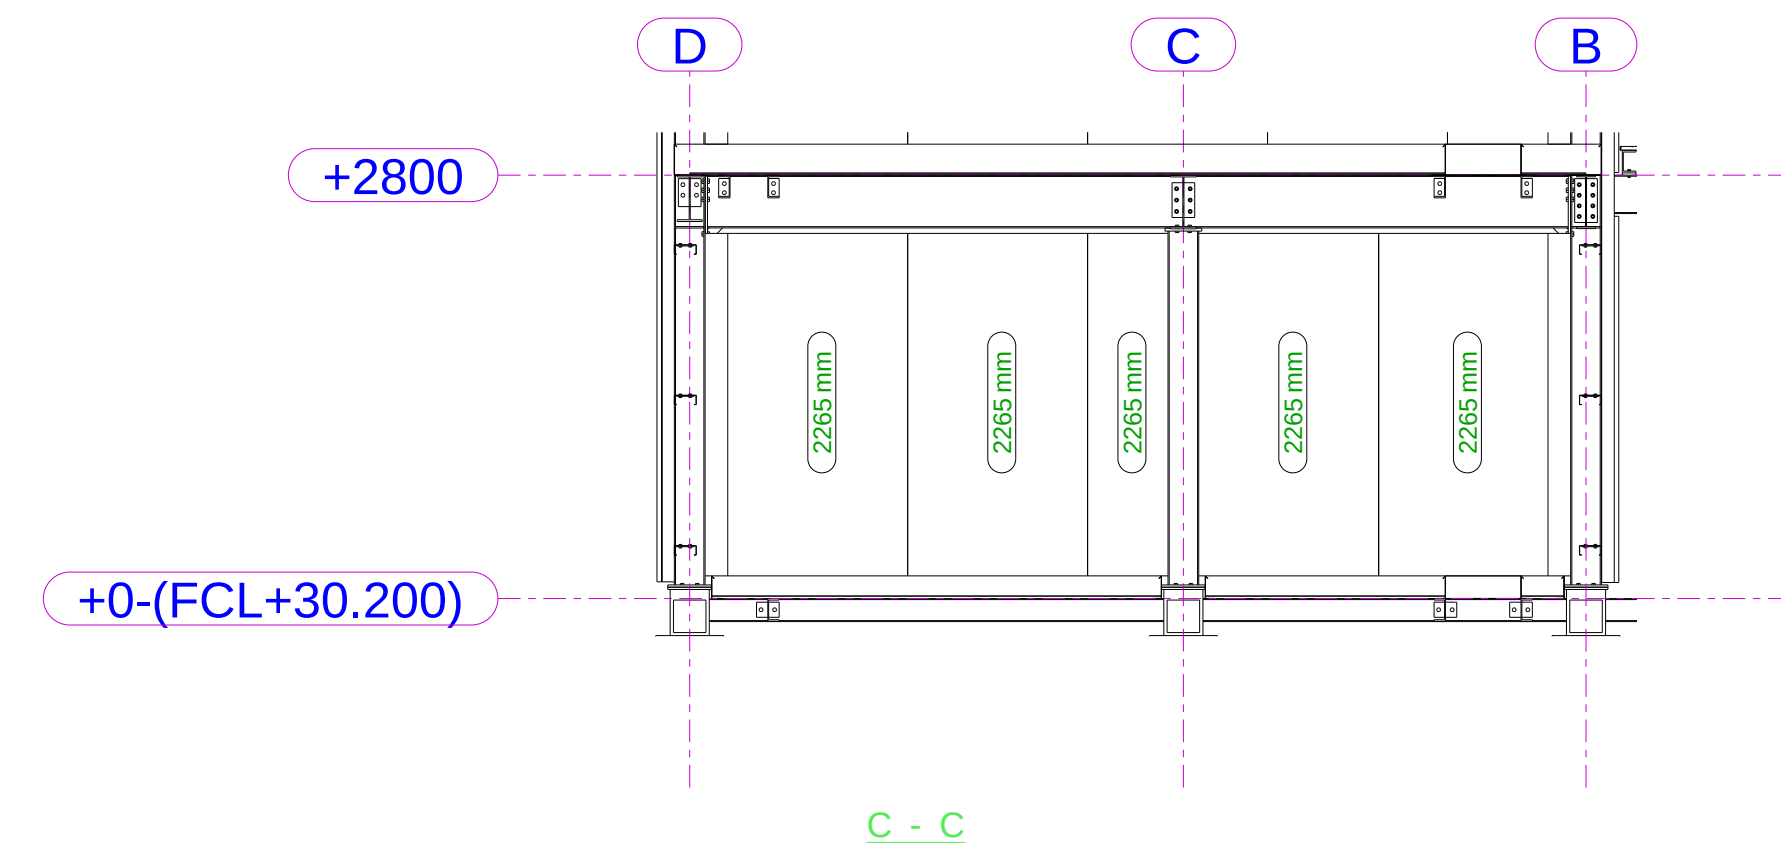


AS BUILT

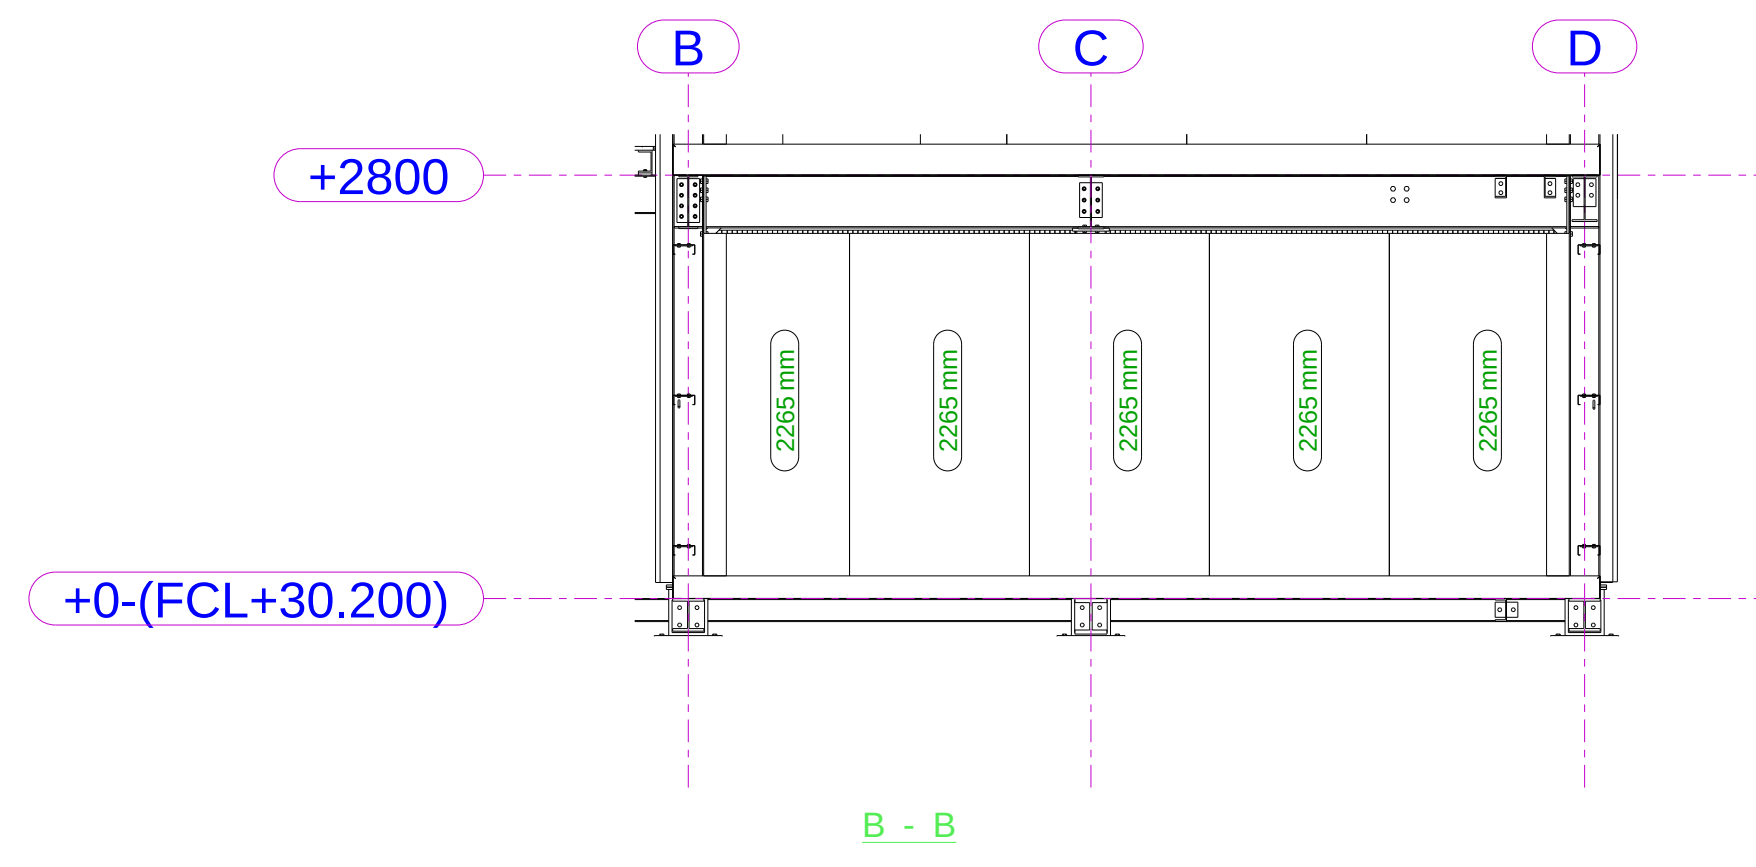

GFL ISOCCLAD LOCATION PLAN

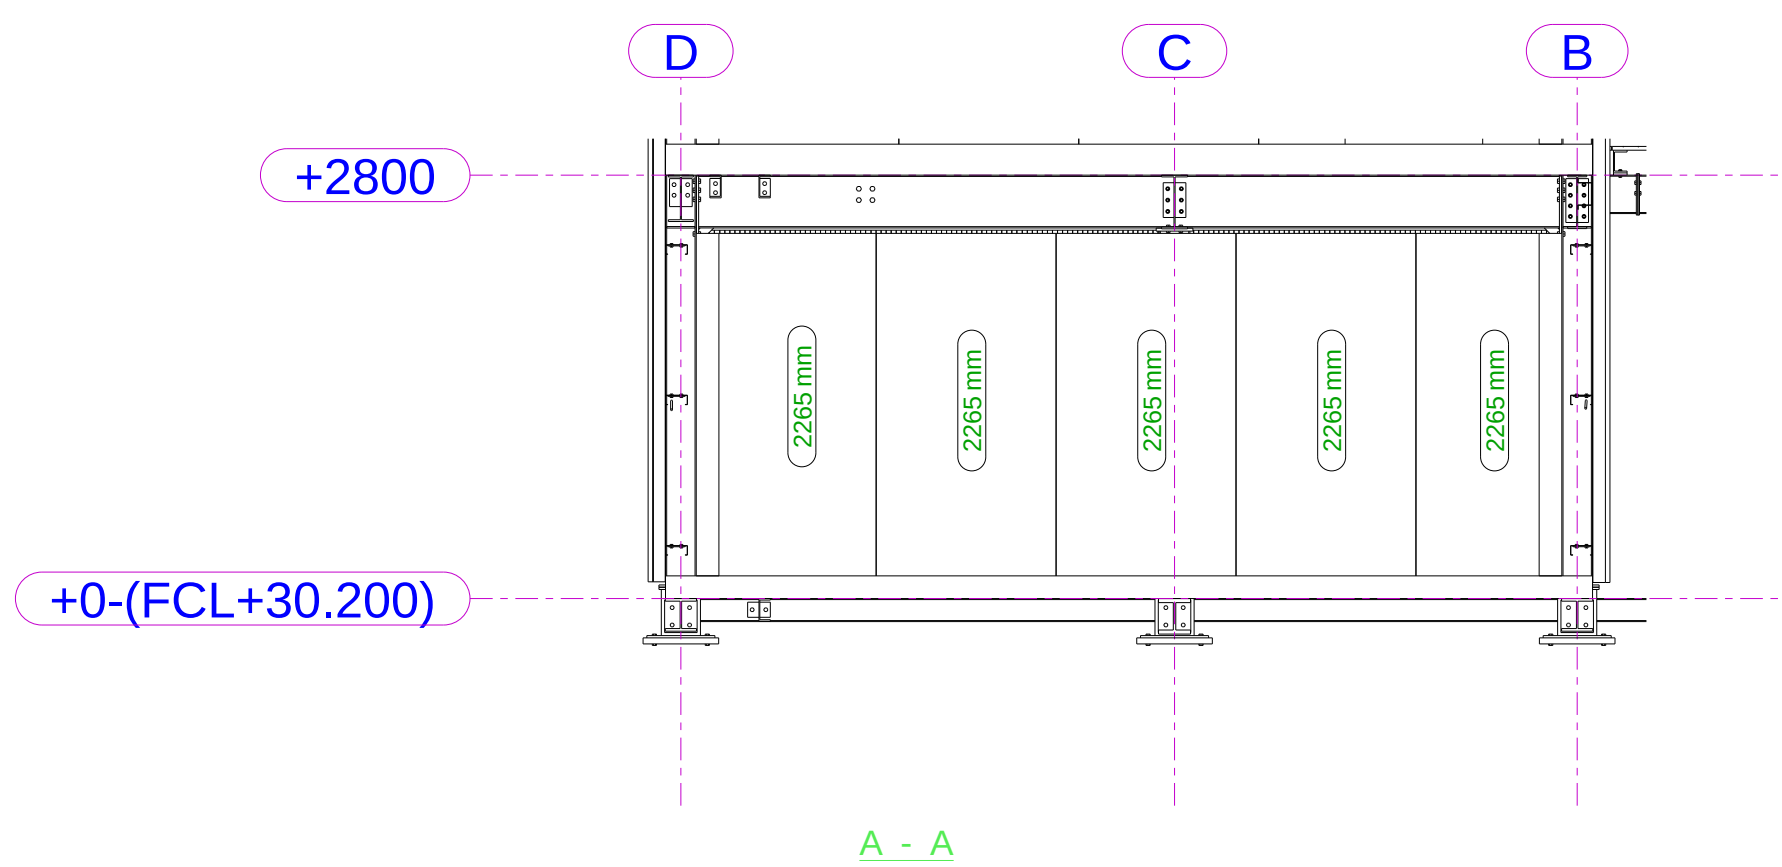

A	As Built	13.03.2022
REV MARK	REVISION DESCRIPTION	REVISION DATE
JSM Project Union Data Centre  Unit 2a Thorpe Way Hardy Croft Station CV15 6JF T 01295 252 963 F 01295 251 008 E info@hawkins-group.co.uk www.hawkins-group.co.uk		
DRAWING TITLE	GFL Isoclad Elevations	
CONTRACT	Project Union Data Centre	
MODELLED BY	MC	ISSUE DATE
CONTRACT NO	JOB149980	SCALE 1:50
DRAWING No	149980 130	REVISION No. A