




AS BUILT

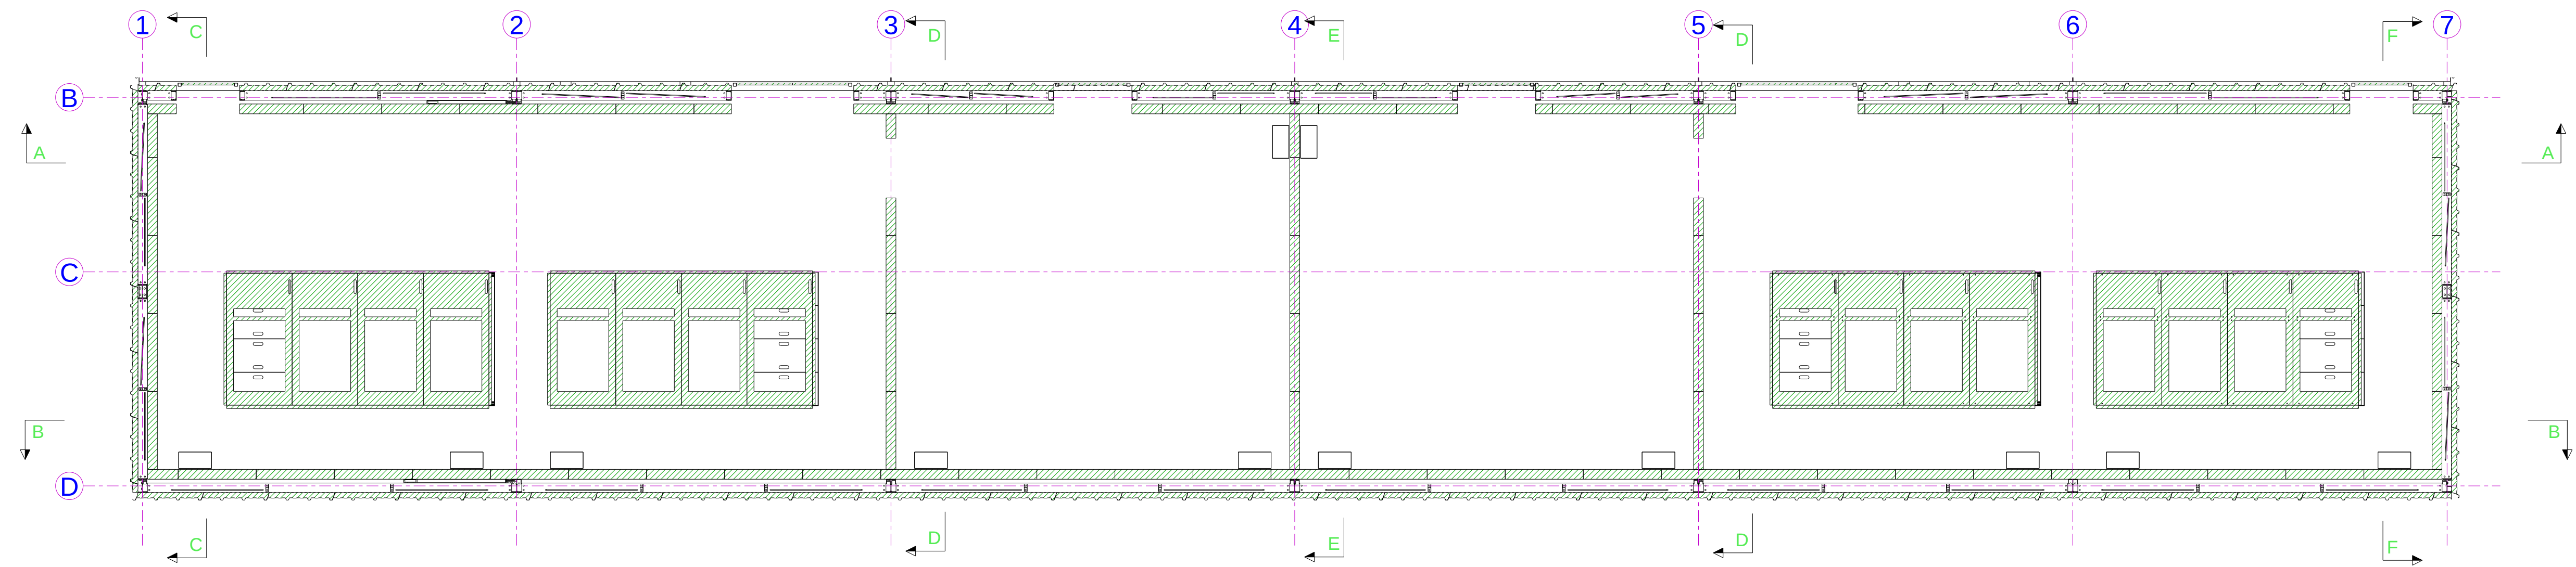


FFL ISOCLAD LOCATION PLAN

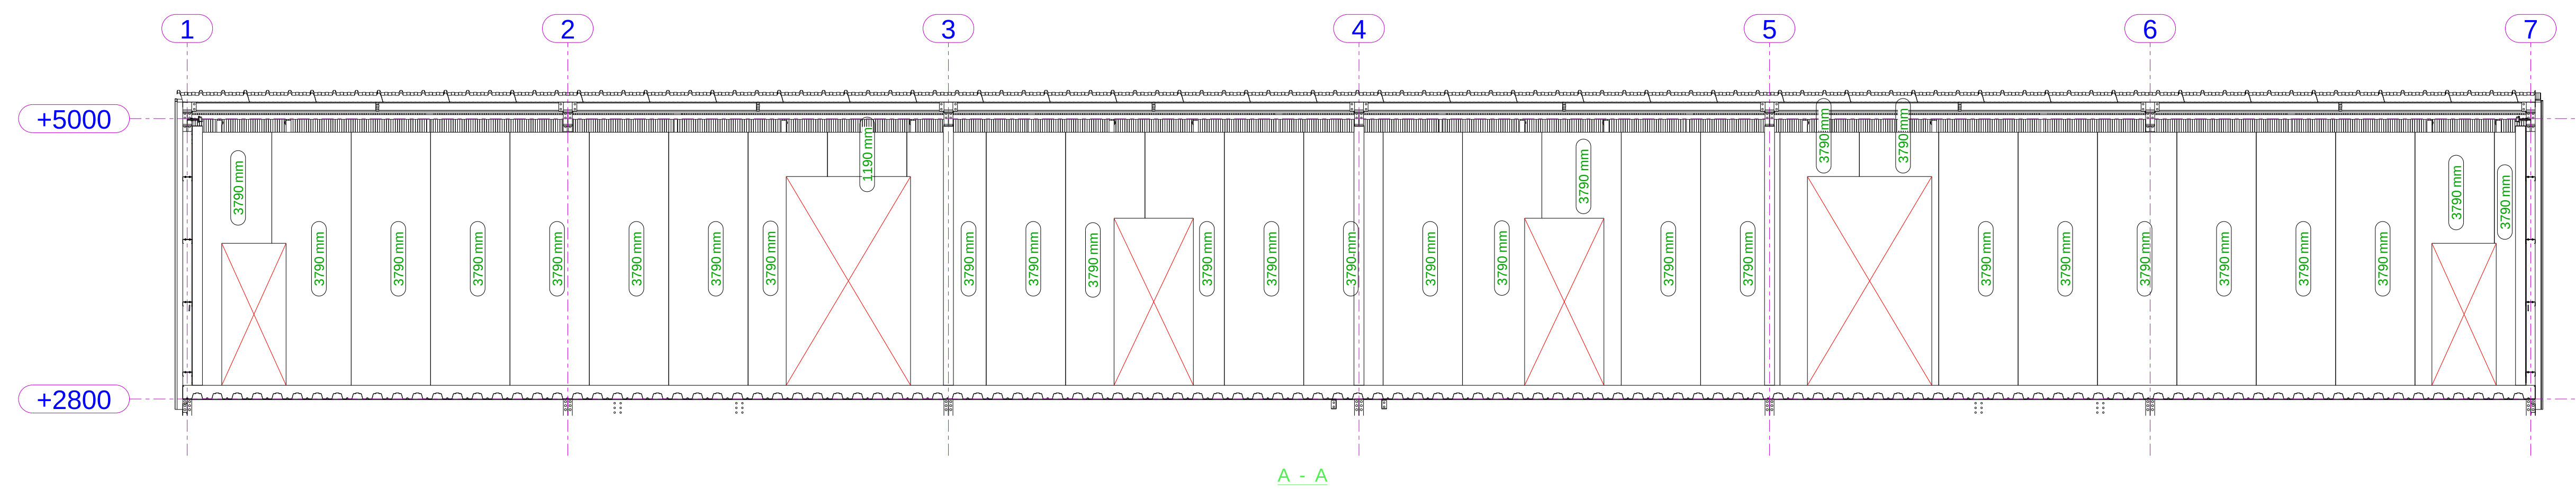

A - A

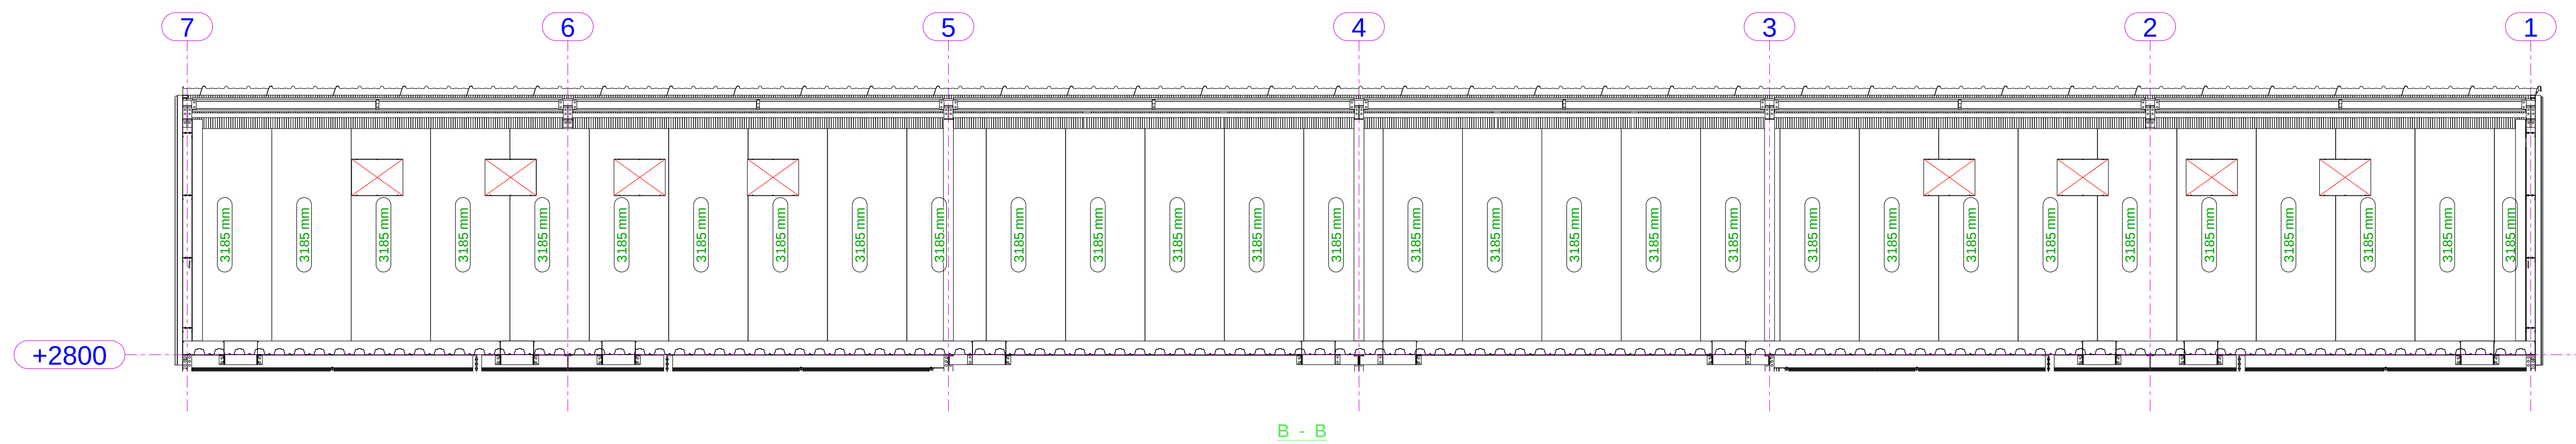

B - B

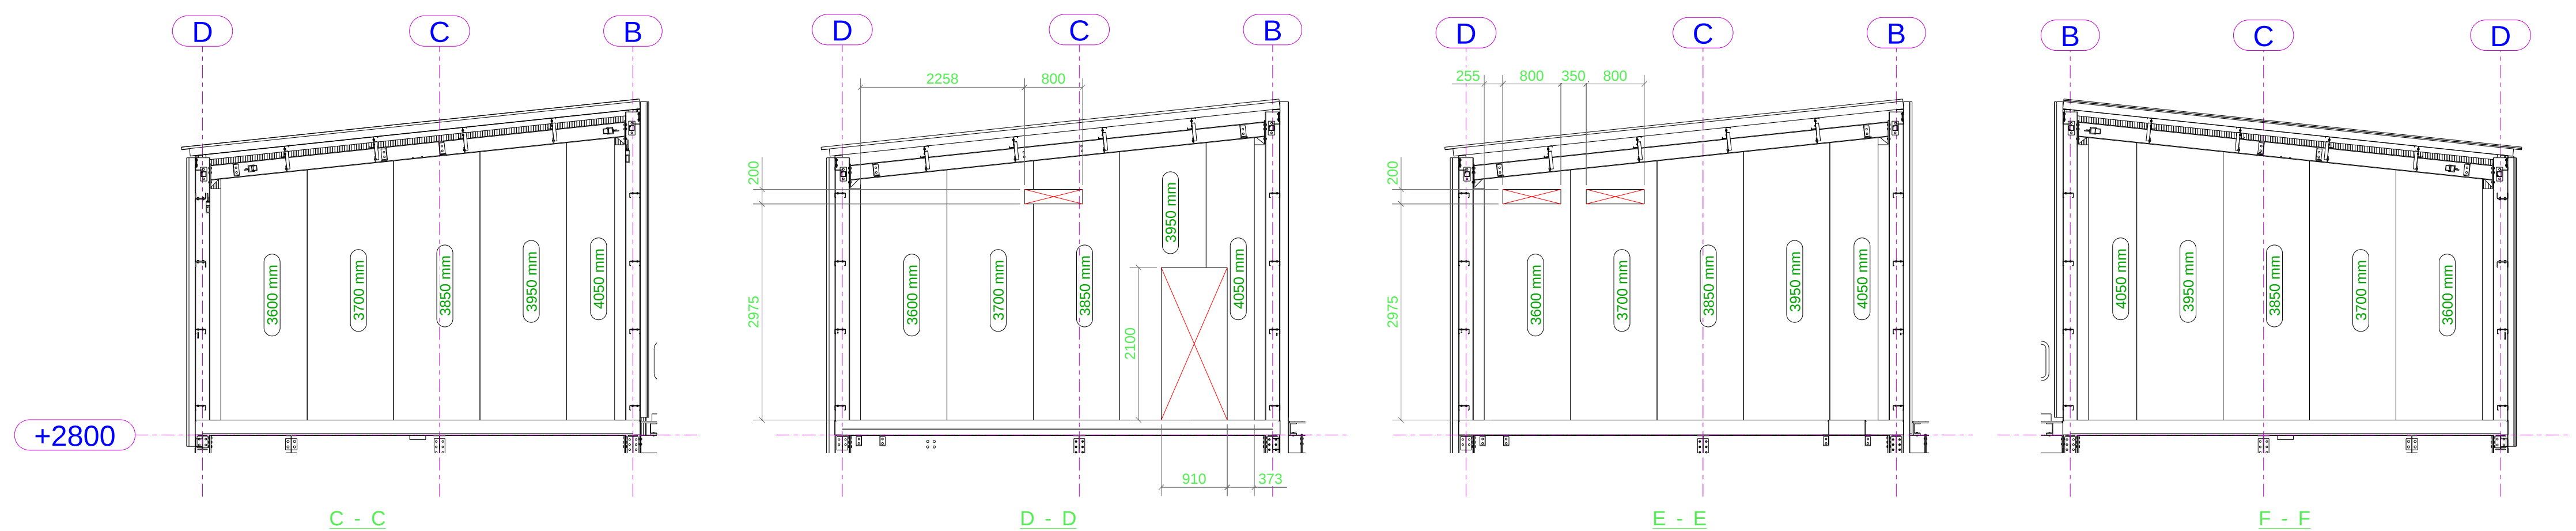

C - C

D - D

E - E

F - F

B	As Built	13.05.2021
A	Section D Door Location Updated	26.05.2021
REV MARK	REVISION DESCRIPTION	REVISION DATE

JSM

Project Union Data Centre



Unit 5a Thorpe Way
Hawthorn Crickcliffe
OX10 4SP
t: 01295 252 065
f: 01295 251 000
e: info@hawkins-group.co.uk
www.hawkins-group.co.uk

DRAWING TITLE	FFL Isoclad Elevations		
CONTRACT	Project Union Data Centre		
MODELLED BY	MC	ISSUE DATE	
CONTRACT NO	JOB149980	SCALE	1:60
DRAWING No	149980 131	REVISION No.	B

For installations use B.3 Erection Tolerances BS EN 1090-2: 2018 Class 1 on steel handover document