




Front Elevation



Side 1 Elevation



Rear Elevation

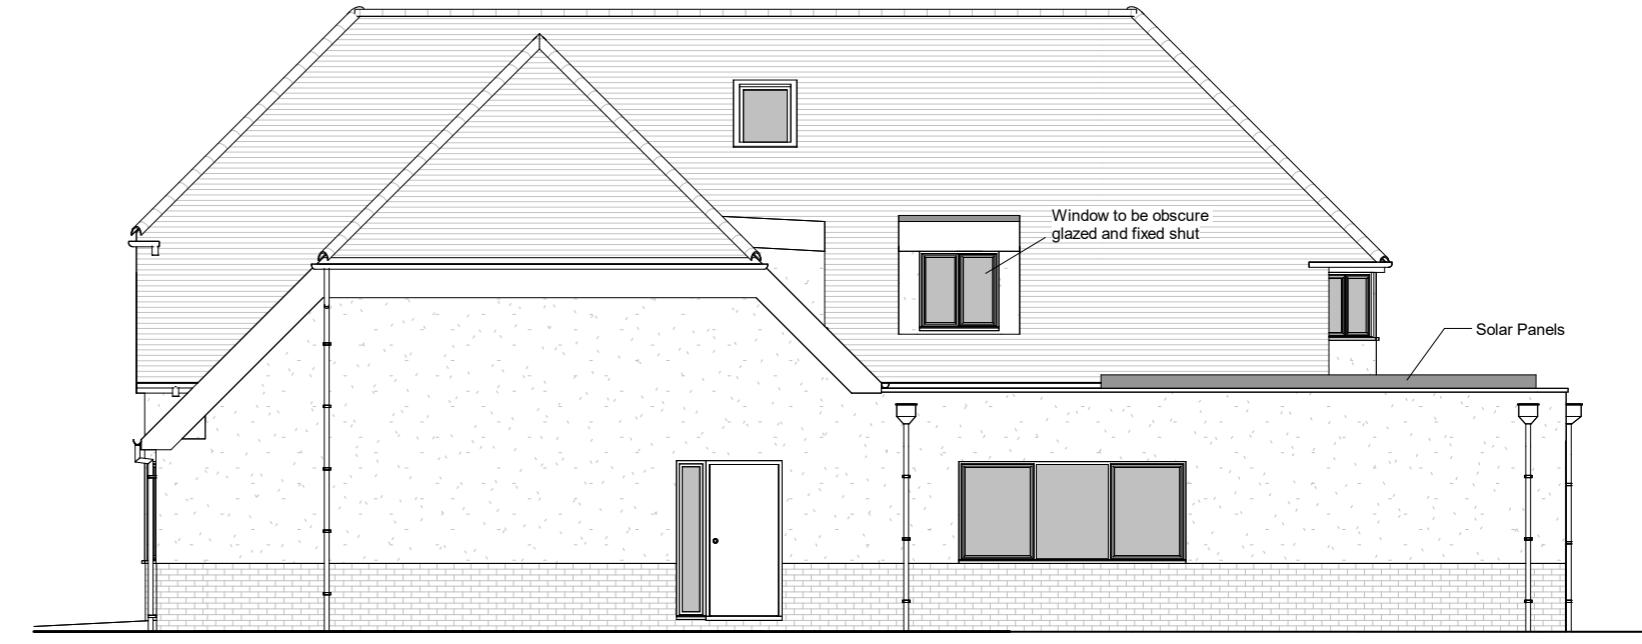

Side 2 Elevation



7 Meadow Close, Ruislip

Proposed Elevations (Retention of as built)

Scale @ A3
1:10

Drawing number
P M 600

Date

Project number
1942

Drawn by
N.Mil

Rev
A

Ke

Existing Proposed SVP Boundary line

11. *What is the best way to increase the number of people who use a particular service?*

— Existing drainage - - - Proposed drainage - - - - Overhead

For more information, contact the Office of the Vice President for Research and Economic Development at 515-294-6450 or research@iastate.edu.

A horizontal checkerboard pattern consisting of eight black and white squares, used as a visual element in the document.

GRAPHIC SCALE: 1:100