




AS-INSTALLED FRONT ELEVATION
Scale 1:50

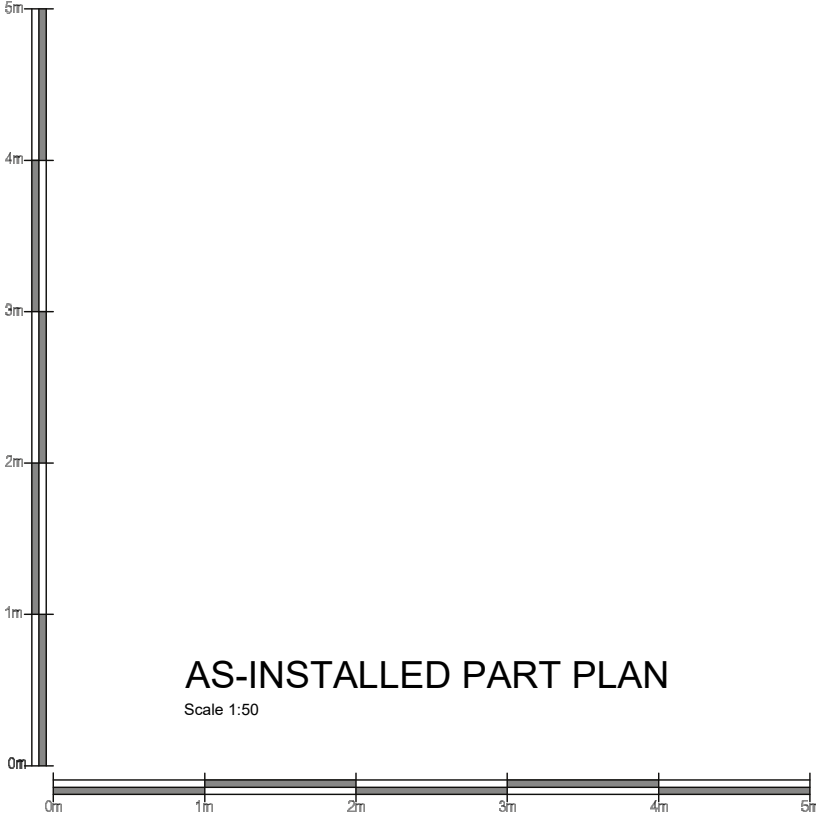

AS-INSTALLED PART PLAN
Scale 1:50

Date:	Comments:	By:

GENERAL NOTES:
1) All dimensions in millimeters unless otherwise stated.

Site:
Clayton Off Licence,
Unit A,
11-21 Clayton Road,
Hayes,
UB3 1AX

Drawing Title:
As-Installed Plan and Elevation

Ref: T019740_AI	Date: 11/02/2020	Rev:
Scale: 1:50	Paper: A3	Date Rev: