


## Pre-Existing Ground Floor Plan

---

Scale:1:50

1:50  5 Meter

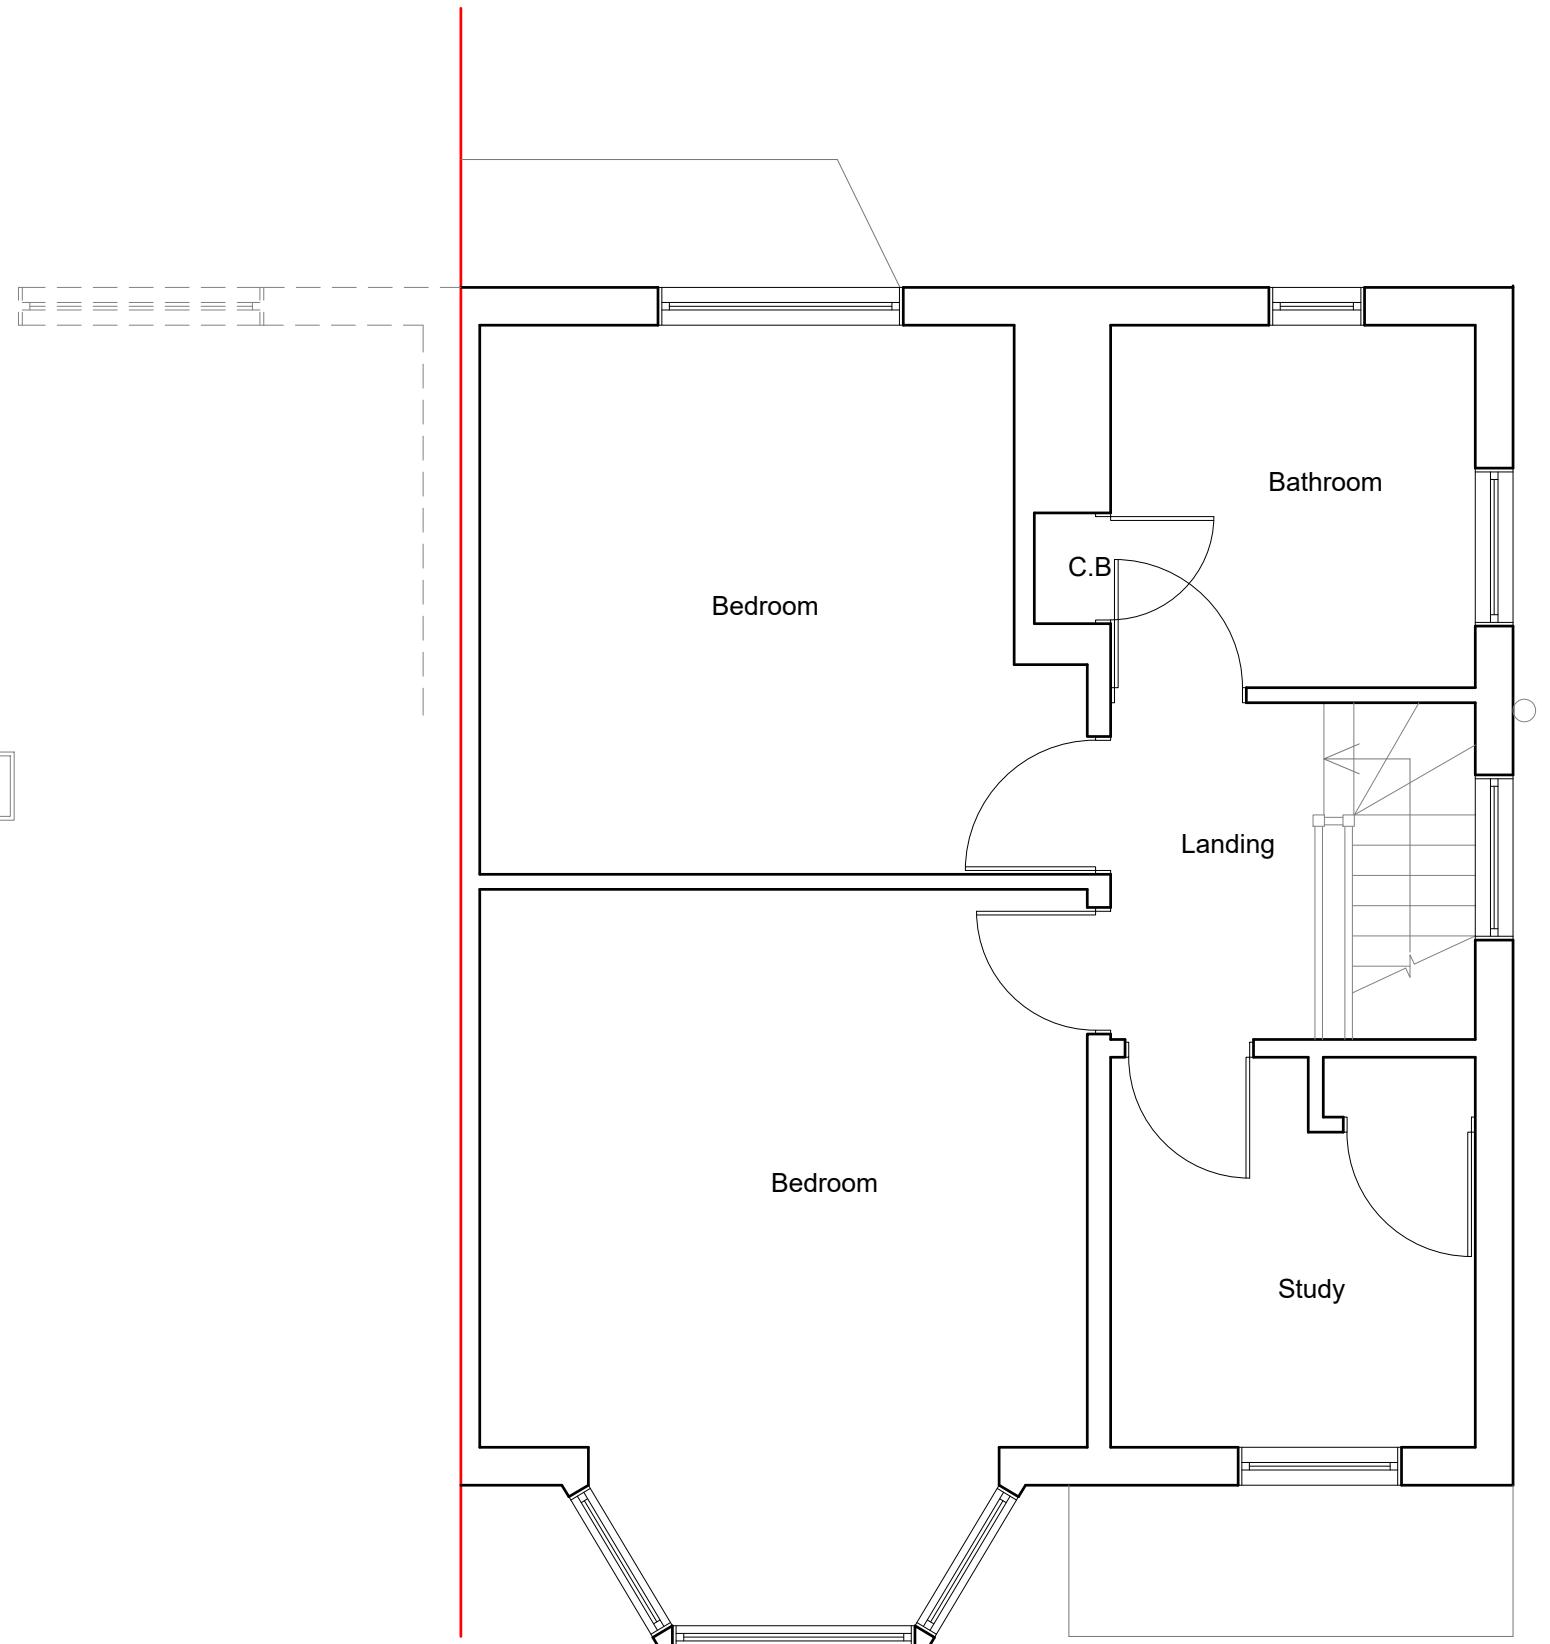

## Pre-Existing First Floor Plan

Scale:1:50

<p>Modhwadia Design Services</p>	<p>Project: 51 York Road Northwood HA6 1JJ</p>	<p>Title: Pre-Existing Floor Plans</p>	<p>Scale: 1:50 @ A3 Date: 04.2020 Drawing No.: MD/6020 - 01/MT</p>									
		<p>Revision</p> <table border="1" data-bbox="2782 1983 2944 2014"> <tr><td></td><td></td><td></td></tr> <tr><td></td><td></td><td></td></tr> <tr><td></td><td></td><td></td></tr> </table>										




Pre-Existing Front  
Elevation  
Scale:1:100



Pre-Existing Side  
Elevation  
Scale:1:100



Pre-Existing Rear  
Elevation  
Scale:1:100

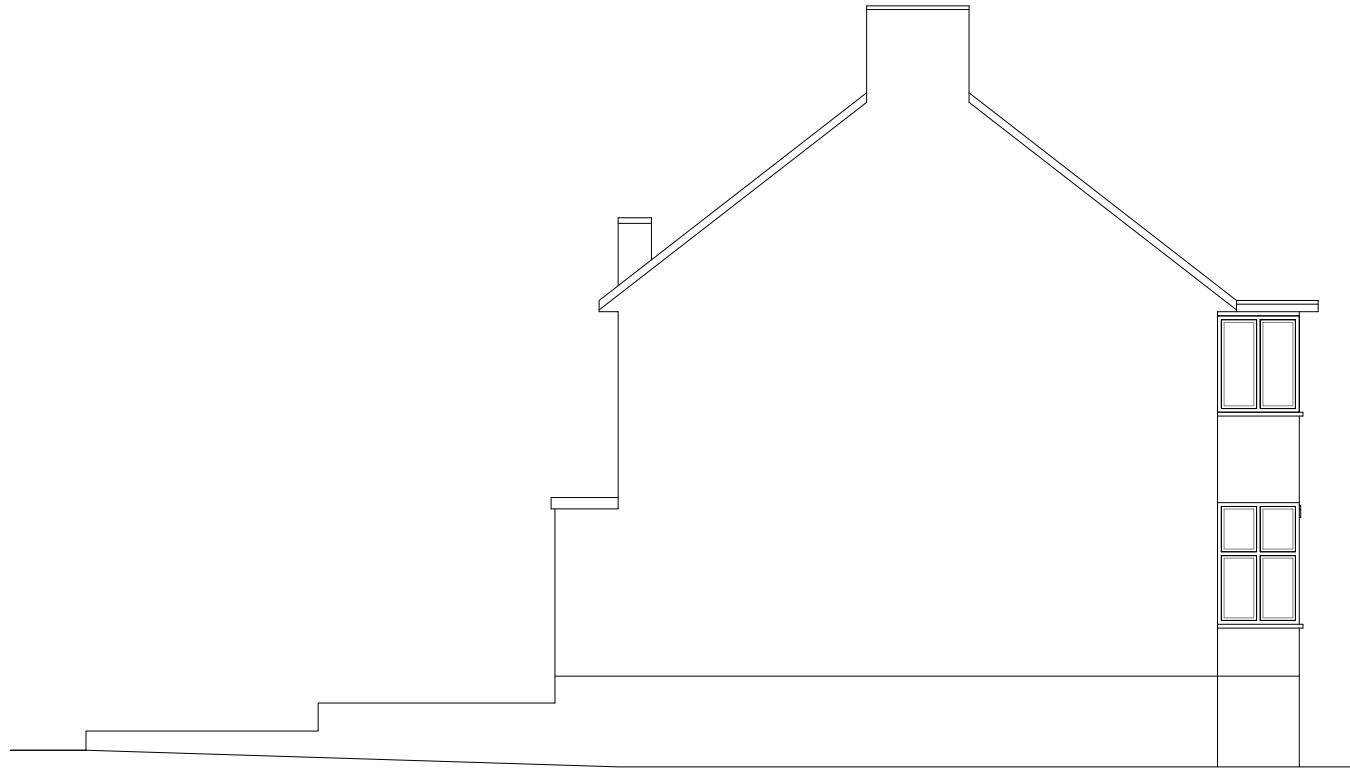

Pre-Existing Side  
Elevation  
Scale:1:100

1:100 0 1 2 5 10 Meter


Modhwadia  
Design  
Services

Project:  
51 York Road  
Northwood  
HA6 1JJ

Title:  
Pre-Existing  
Elevations

Scale: 1:100 @ A3  
Date: 04 . 2020  
Drawing No.:  
MD/6020 - 02/MT  
Revision  

1	2	3	4	5	6	7	8	9	10
---	---	---	---	---	---	---	---	---	----

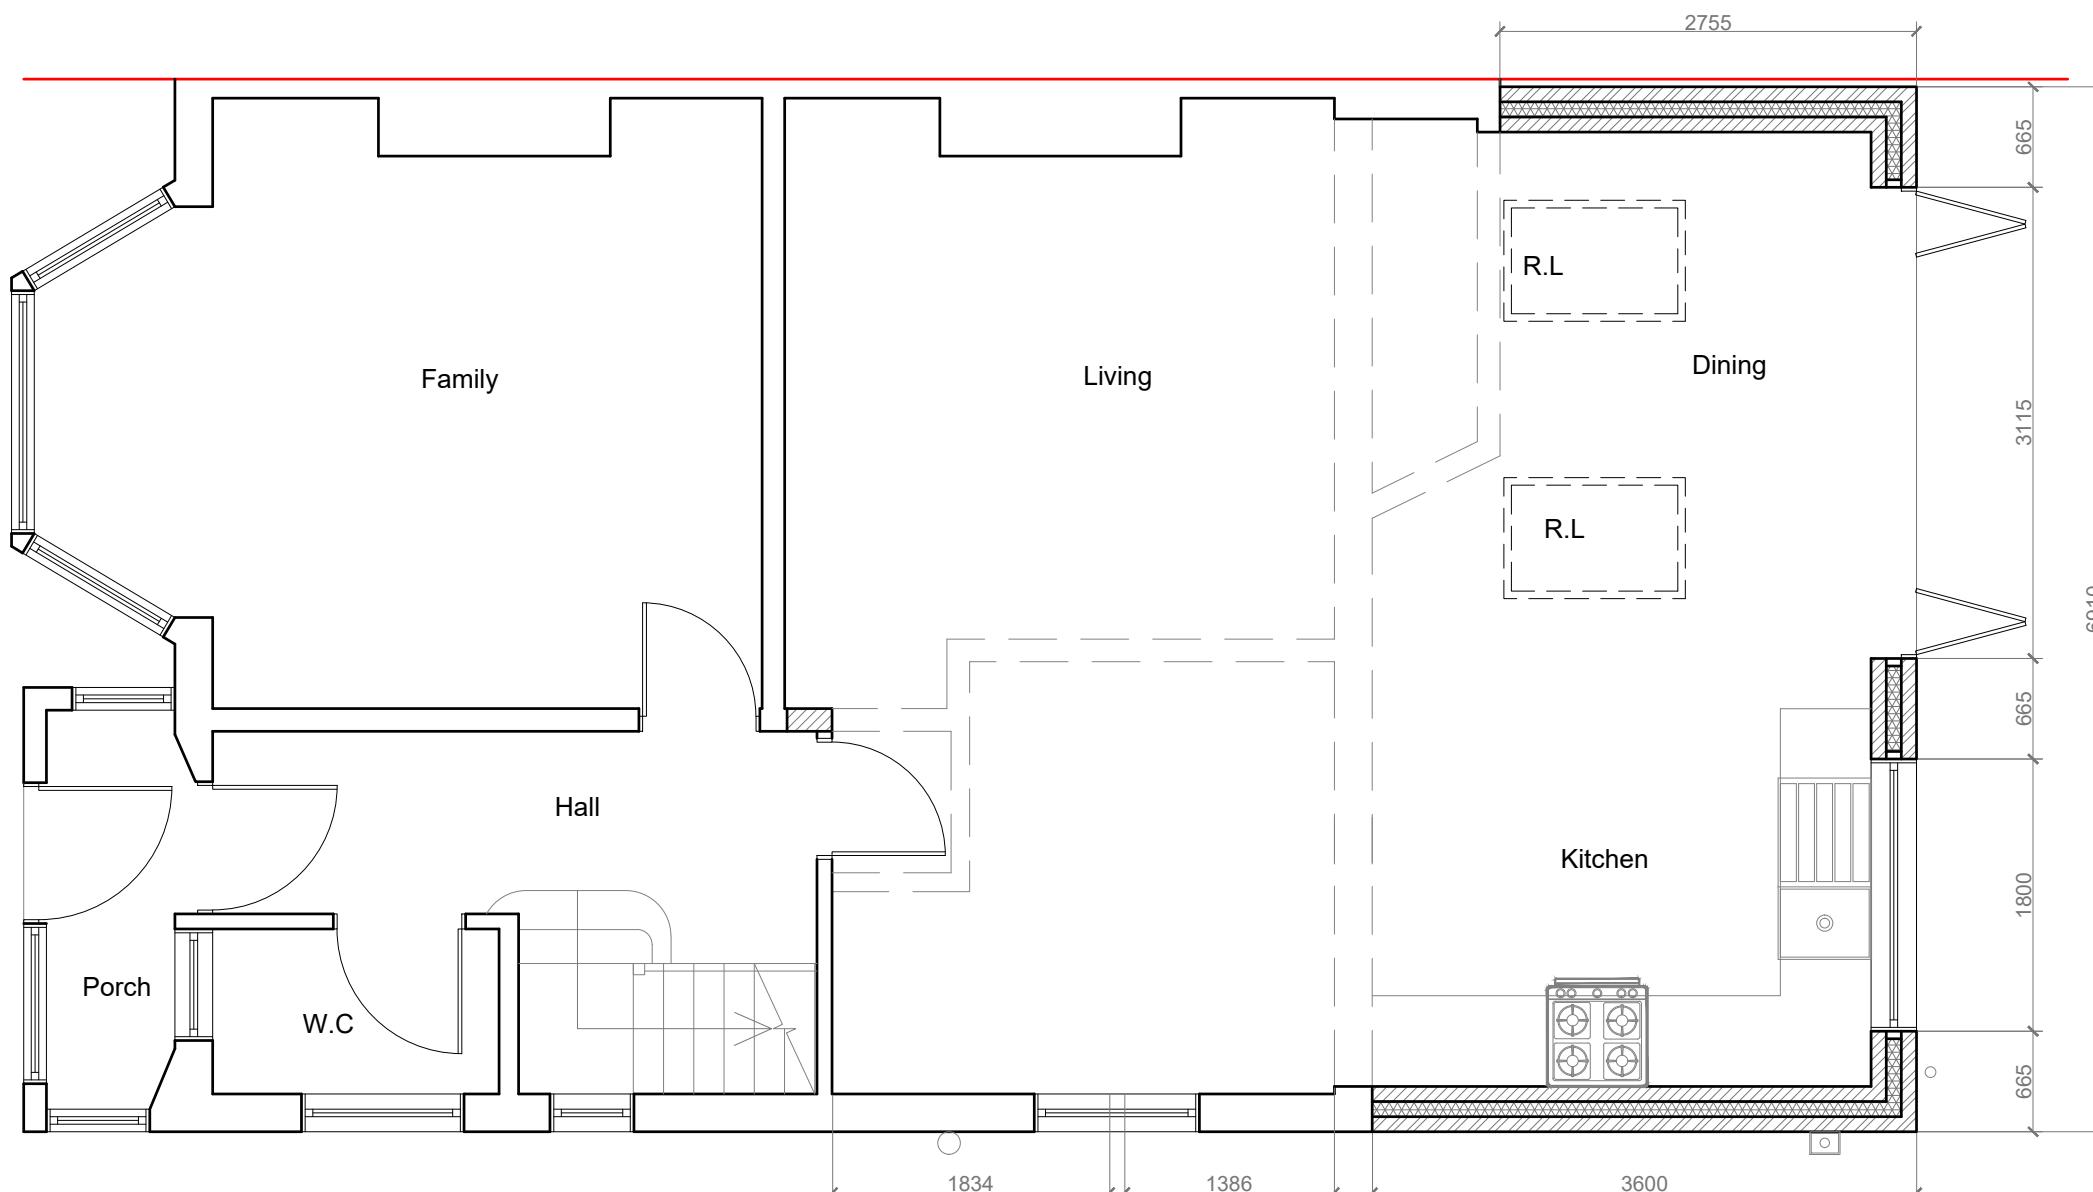

## Approved Ground Floor Plan


Scale:1:50

1

1:50

0 1 2 5 Meter

<p>Modhwadia Design Services</p>	<p>Project: 51 York Road Northwood HA6 1JJ</p>	<p>Title: Approved Ground Floor Plan</p>	<p>Scale: 1:50 @ A3 Date: 04 . 2020 Drawing No.: MD/6020 - 03/MT</p>												
		<p>Revision</p> <table border="1" data-bbox="2775 1992 2940 2016"> <tr><td></td><td></td><td></td><td></td></tr> <tr><td></td><td></td><td></td><td></td></tr> <tr><td></td><td></td><td></td><td></td></tr> </table>													
<p>239 Western Road, Southall, Middlesex, UB2 5HS 020 8571 1369</p>															

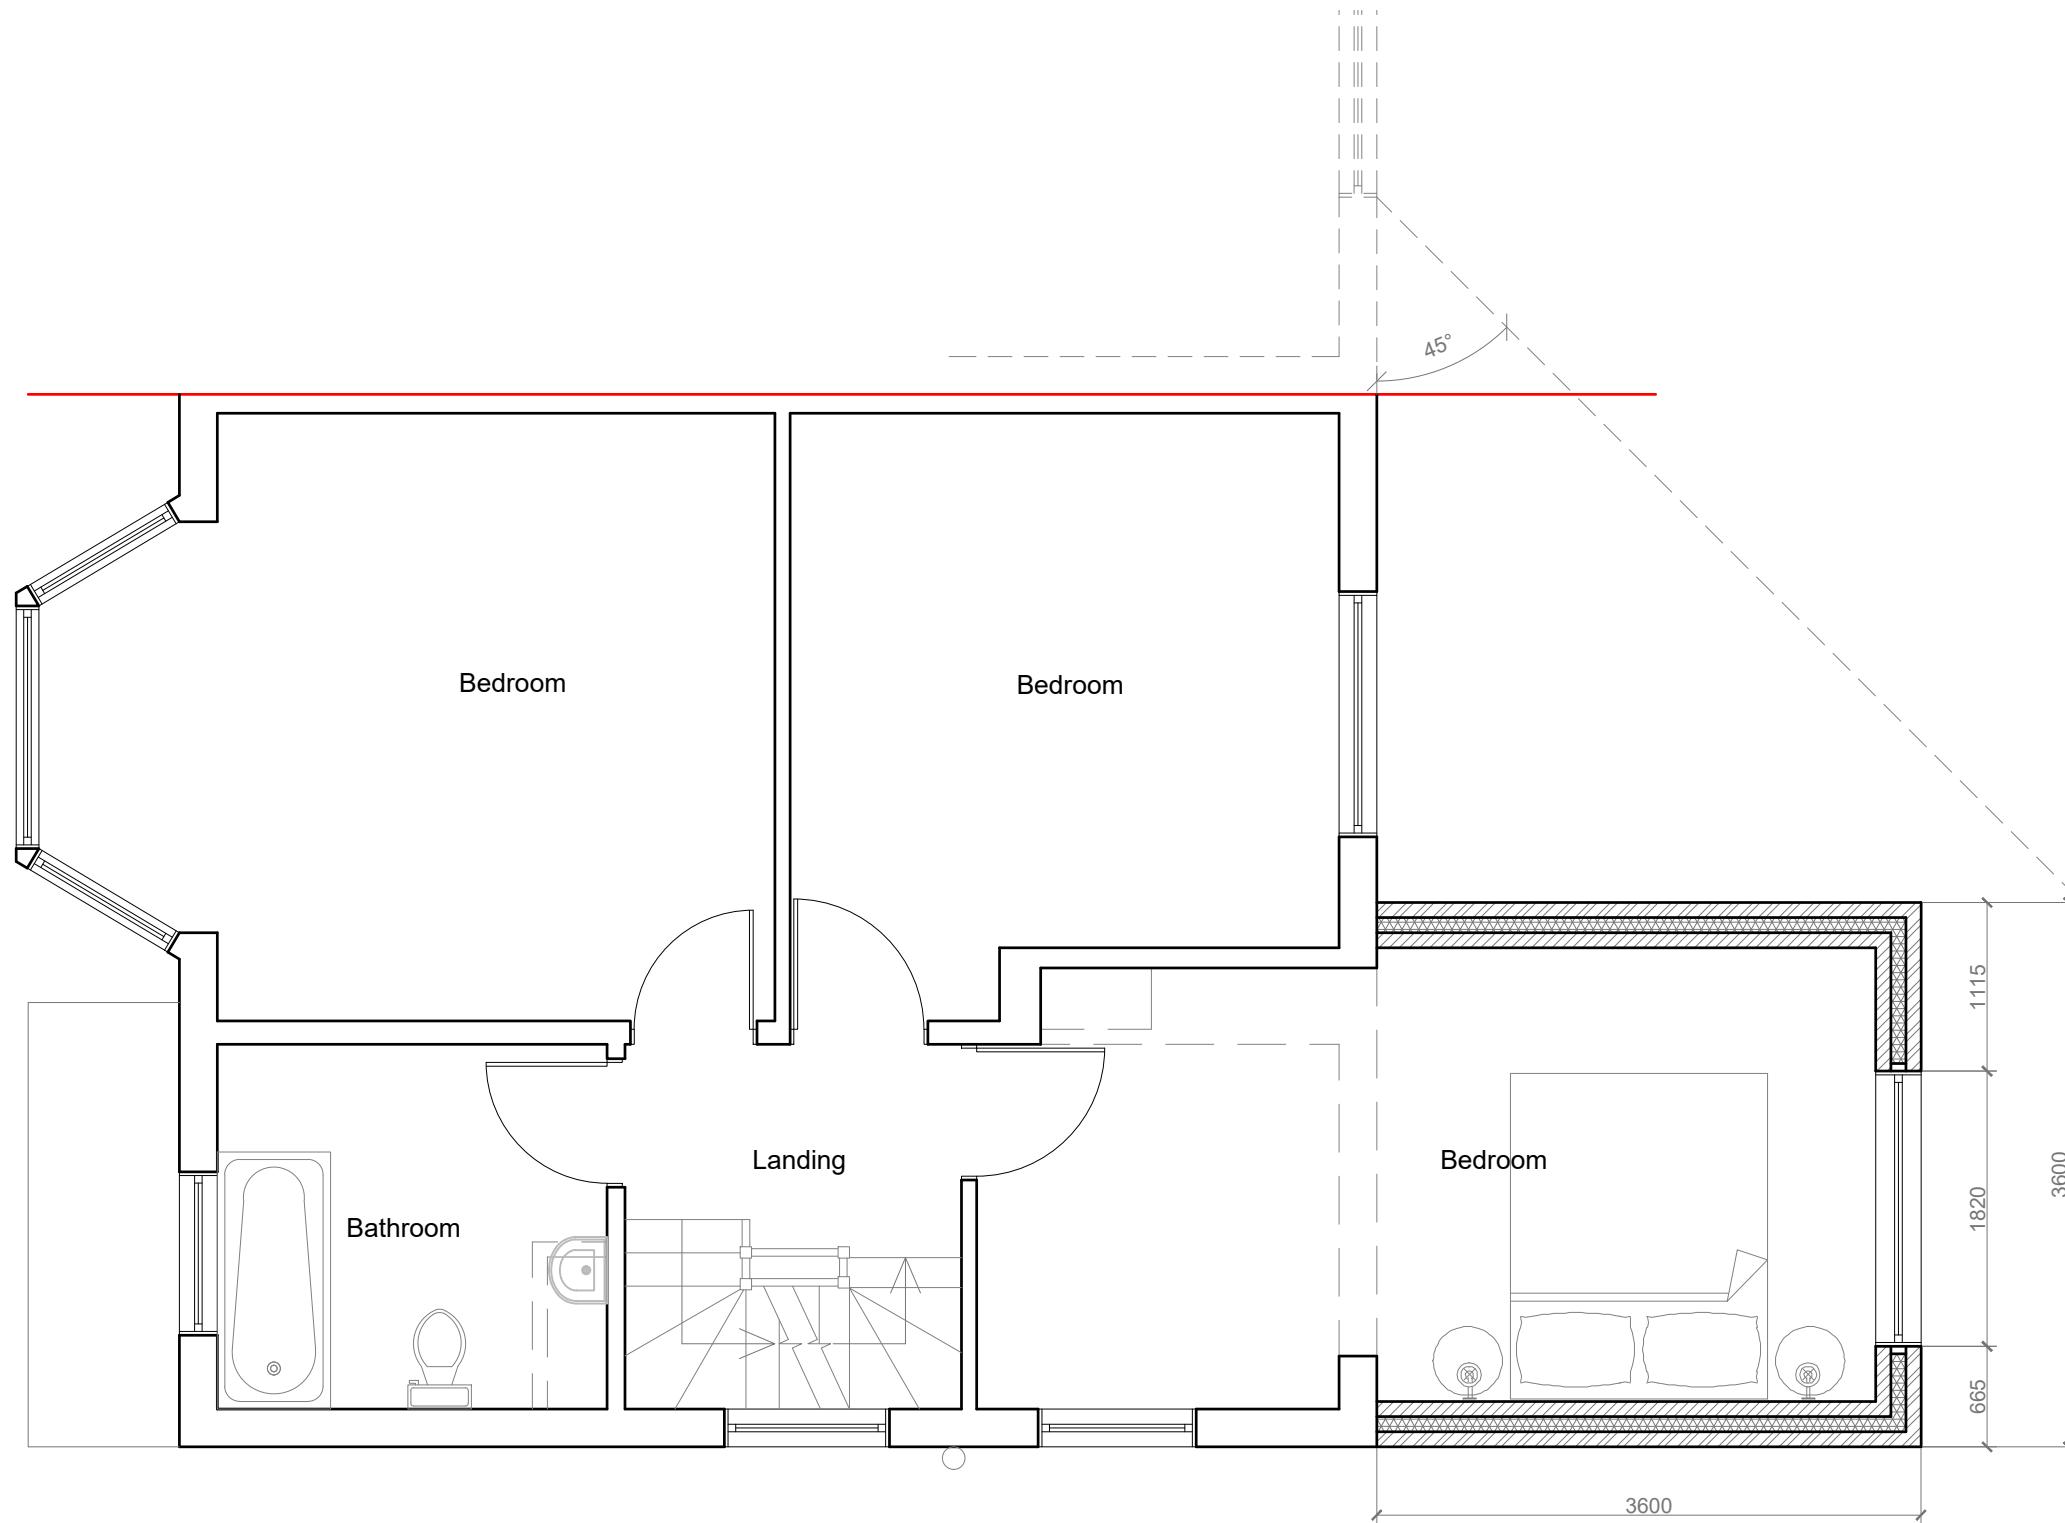


Approved First Floor Plan

Scale: 1:50

1:50 0 1 2 5 Meter

Modhwadia Design Services	Project: 51 York Road Northwood HA6 1JJ	Title: Approved First Floor Plan	Scale: 1:50 @ A3
	Date: 04 . 2020		Date: 04 . 2020
	Drawing No.: MD/6020 - 04/MT		Drawing No.: MD/6020 - 04/MT
	Revision		Revision

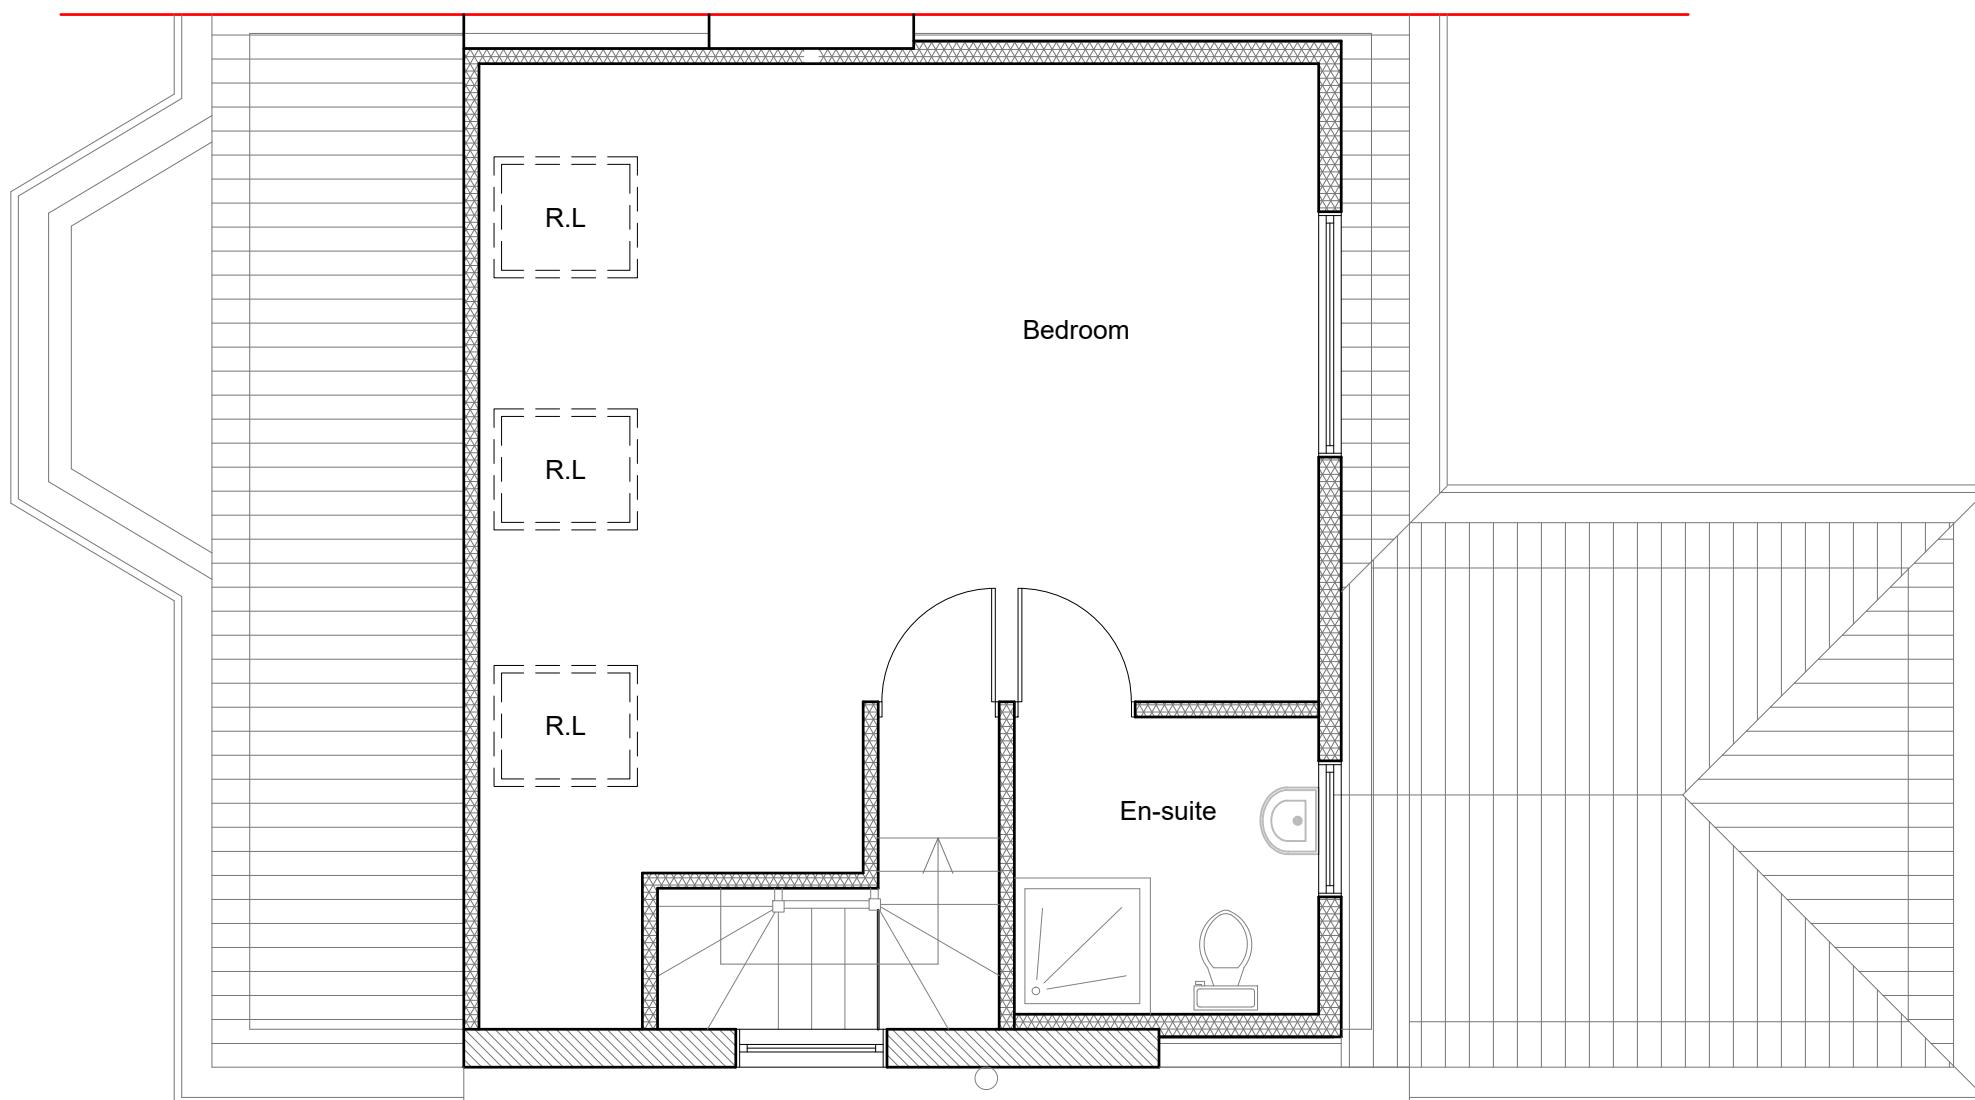

## Approved Loft Plan

Scale:1:50

1:50

0 1 2 5 Meter

<p>Modhwadia Design Services</p>	<p>Project: 51 York Road Northwood HA6 1JJ</p>	<p>Title: Approved Loft Plan</p>	<p>Scale: 1:50 @ A3 Date: 04 . 2020 Drawing No.: MD/6020 - 04/MT</p>												
<p>Revision</p> <table border="1" data-bbox="2207 2019 2347 2019"> <tr><td></td><td></td><td></td><td></td></tr> <tr><td></td><td></td><td></td><td></td></tr> <tr><td></td><td></td><td></td><td></td></tr> </table>															
<p>239 Western Road, Southall, Middlesex, UB2 5HS 020 8571 1369</p>															


Proposed External Finish  
Materials to Match Existing  
External Finish Materials




Approved Front Elevation  
Scale: 1:100



Approved Side Elevation  
Scale: 1:100

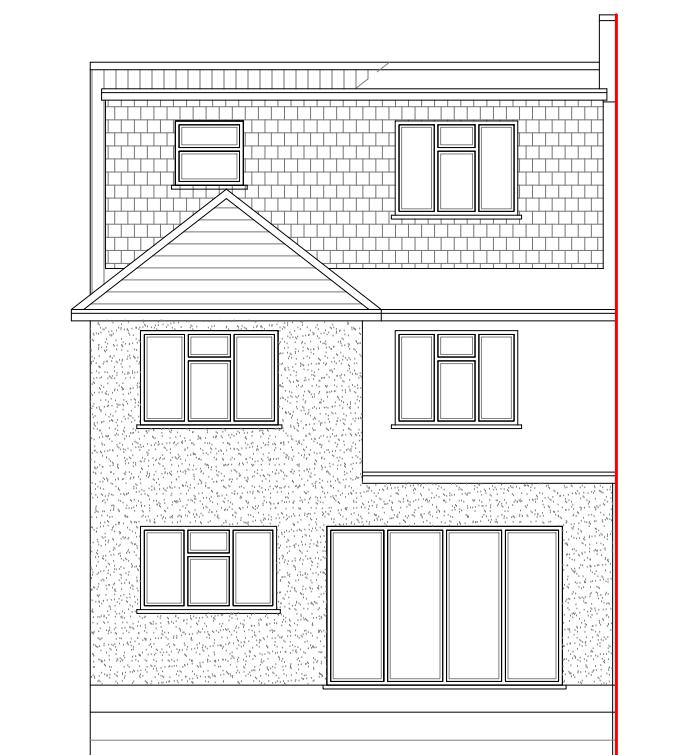

Approved Rear Elevation  
Scale: 1:100

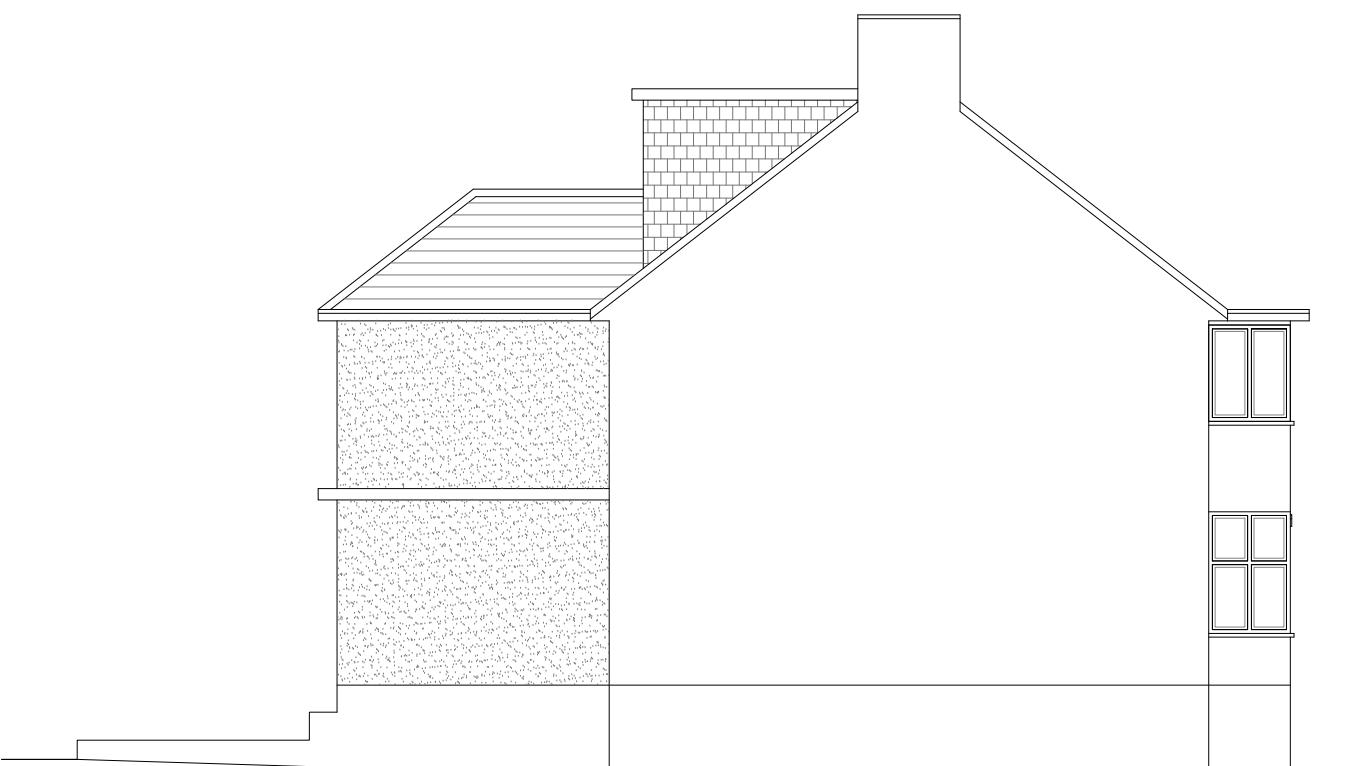


Approved Side Elevation  
Scale: 1:100

1:100 0 1 2 5


10 Meter

Modhwadia Design Services	Project: 51 York Road Northwood HA6 1JJ	Title: Approved Elevations	Scale: 1:100 @ A3 Date: 04 . 2020 Drawing No.: MD/6020 - 04/MT Revision
239 Western Road, Southall, Middlesex, UB2 5HS 020 8571 1369			

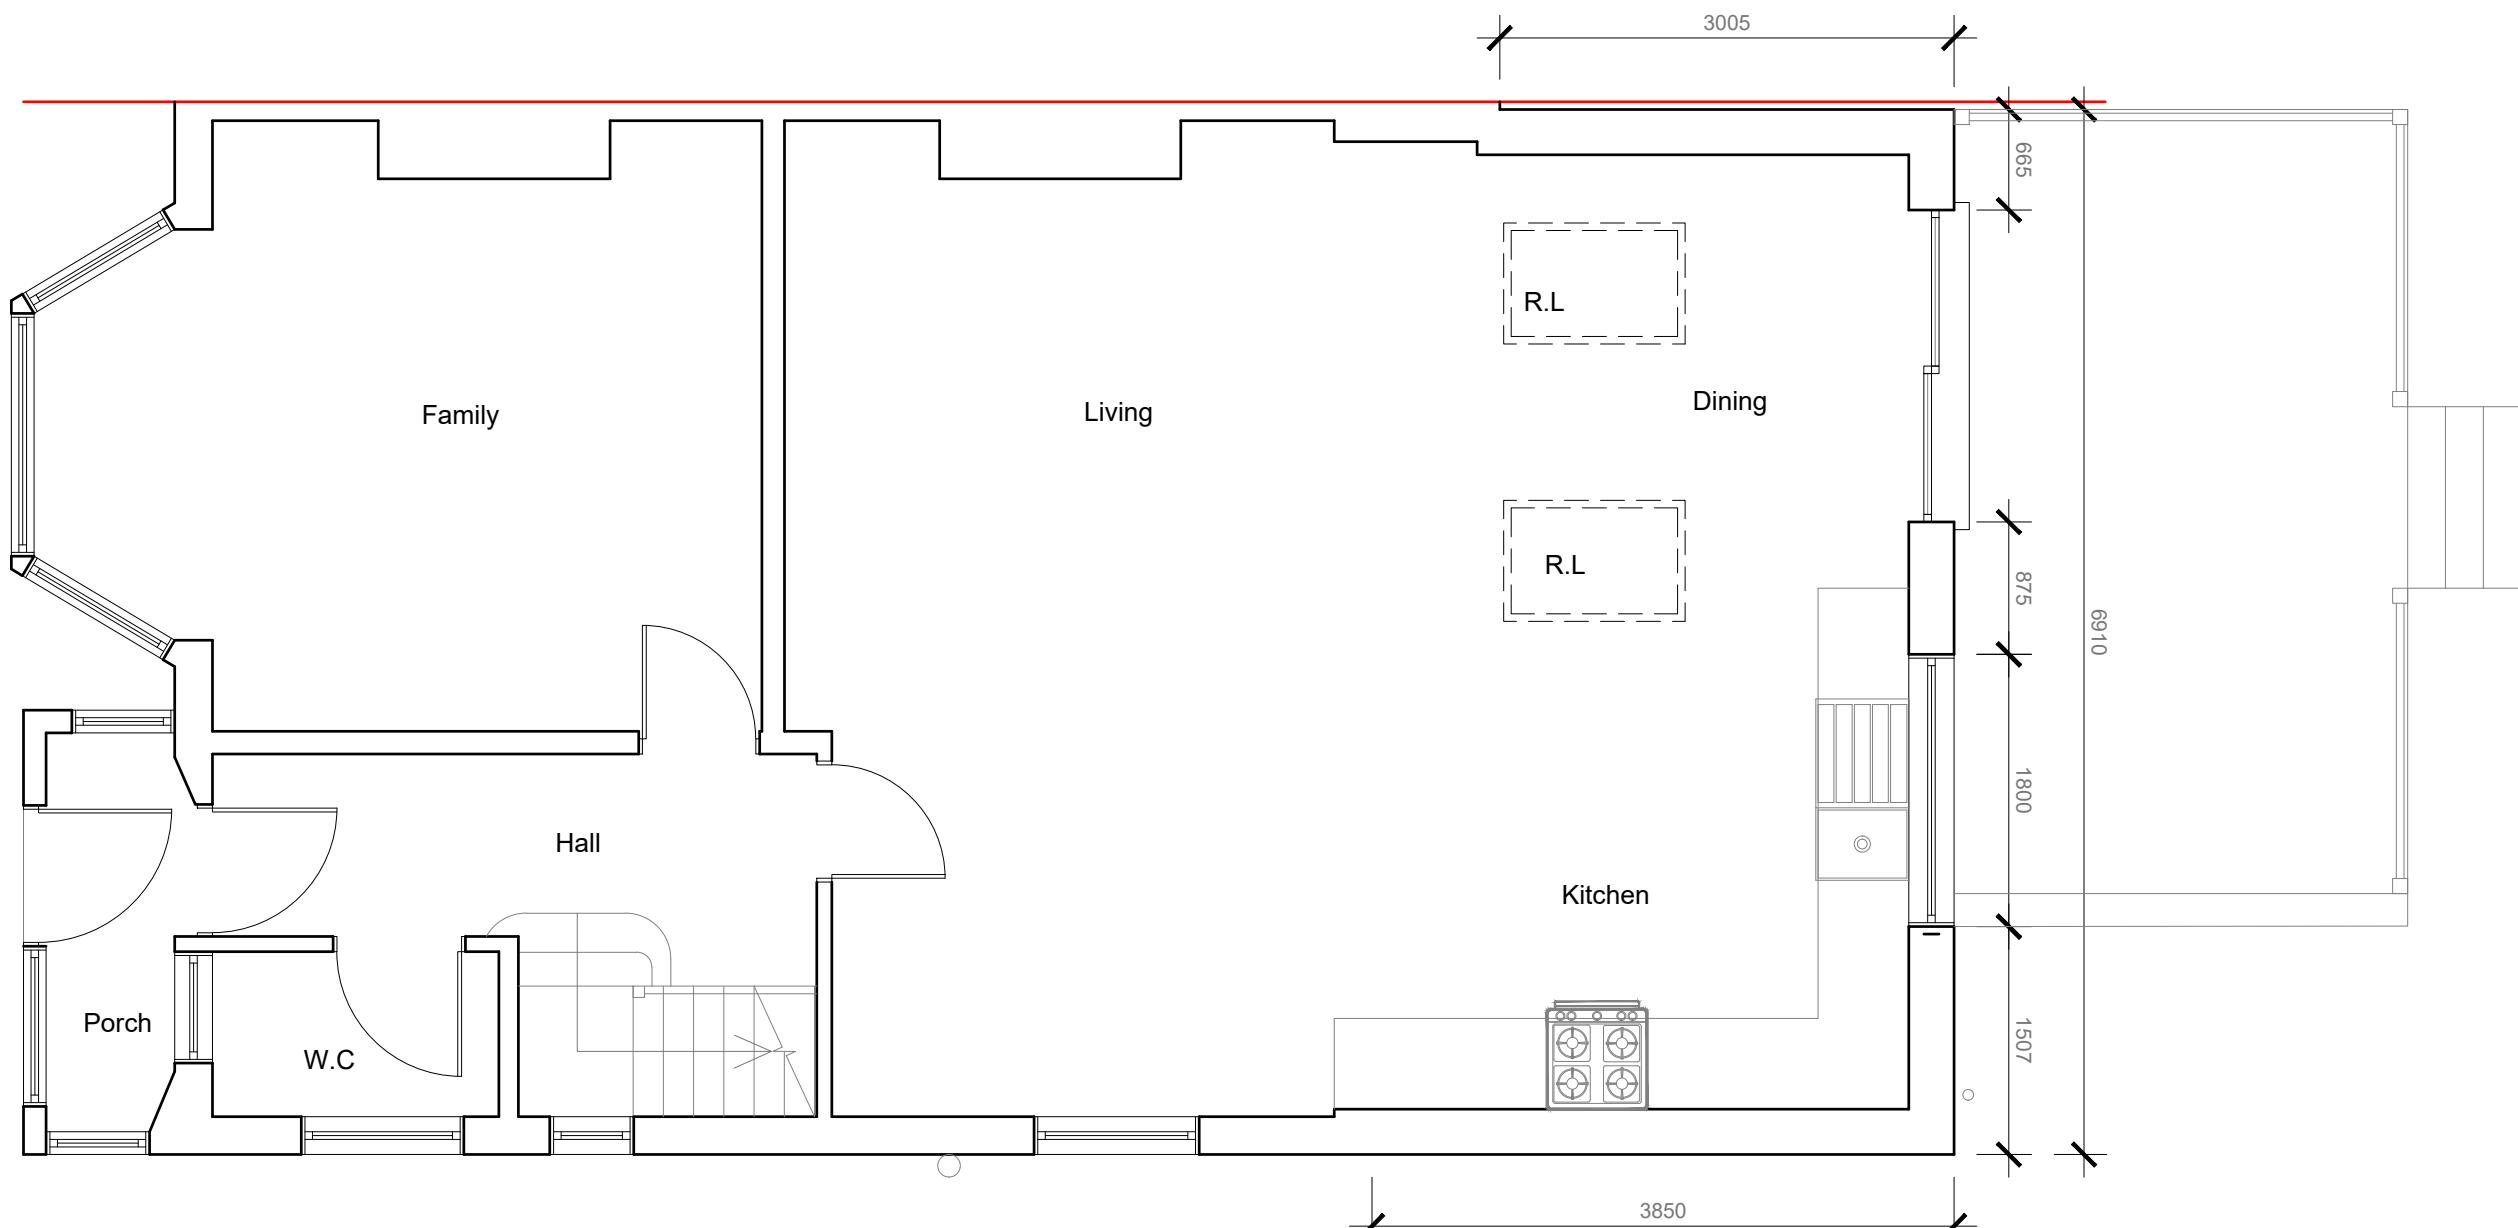

1:50 0 1 2 5 Meter

Modhwadia Design Services	Project: 51 York Road Northwood HA6 1JJ	Title: As Built Ground Floor Plan	Scale: 1:50 @ A3 Date: June 2022 Drawing No.: MD/6020 - 07/MT Revision
239 Western Road, Southall, Middlesex, UB2 5HS 020 8571 1369			

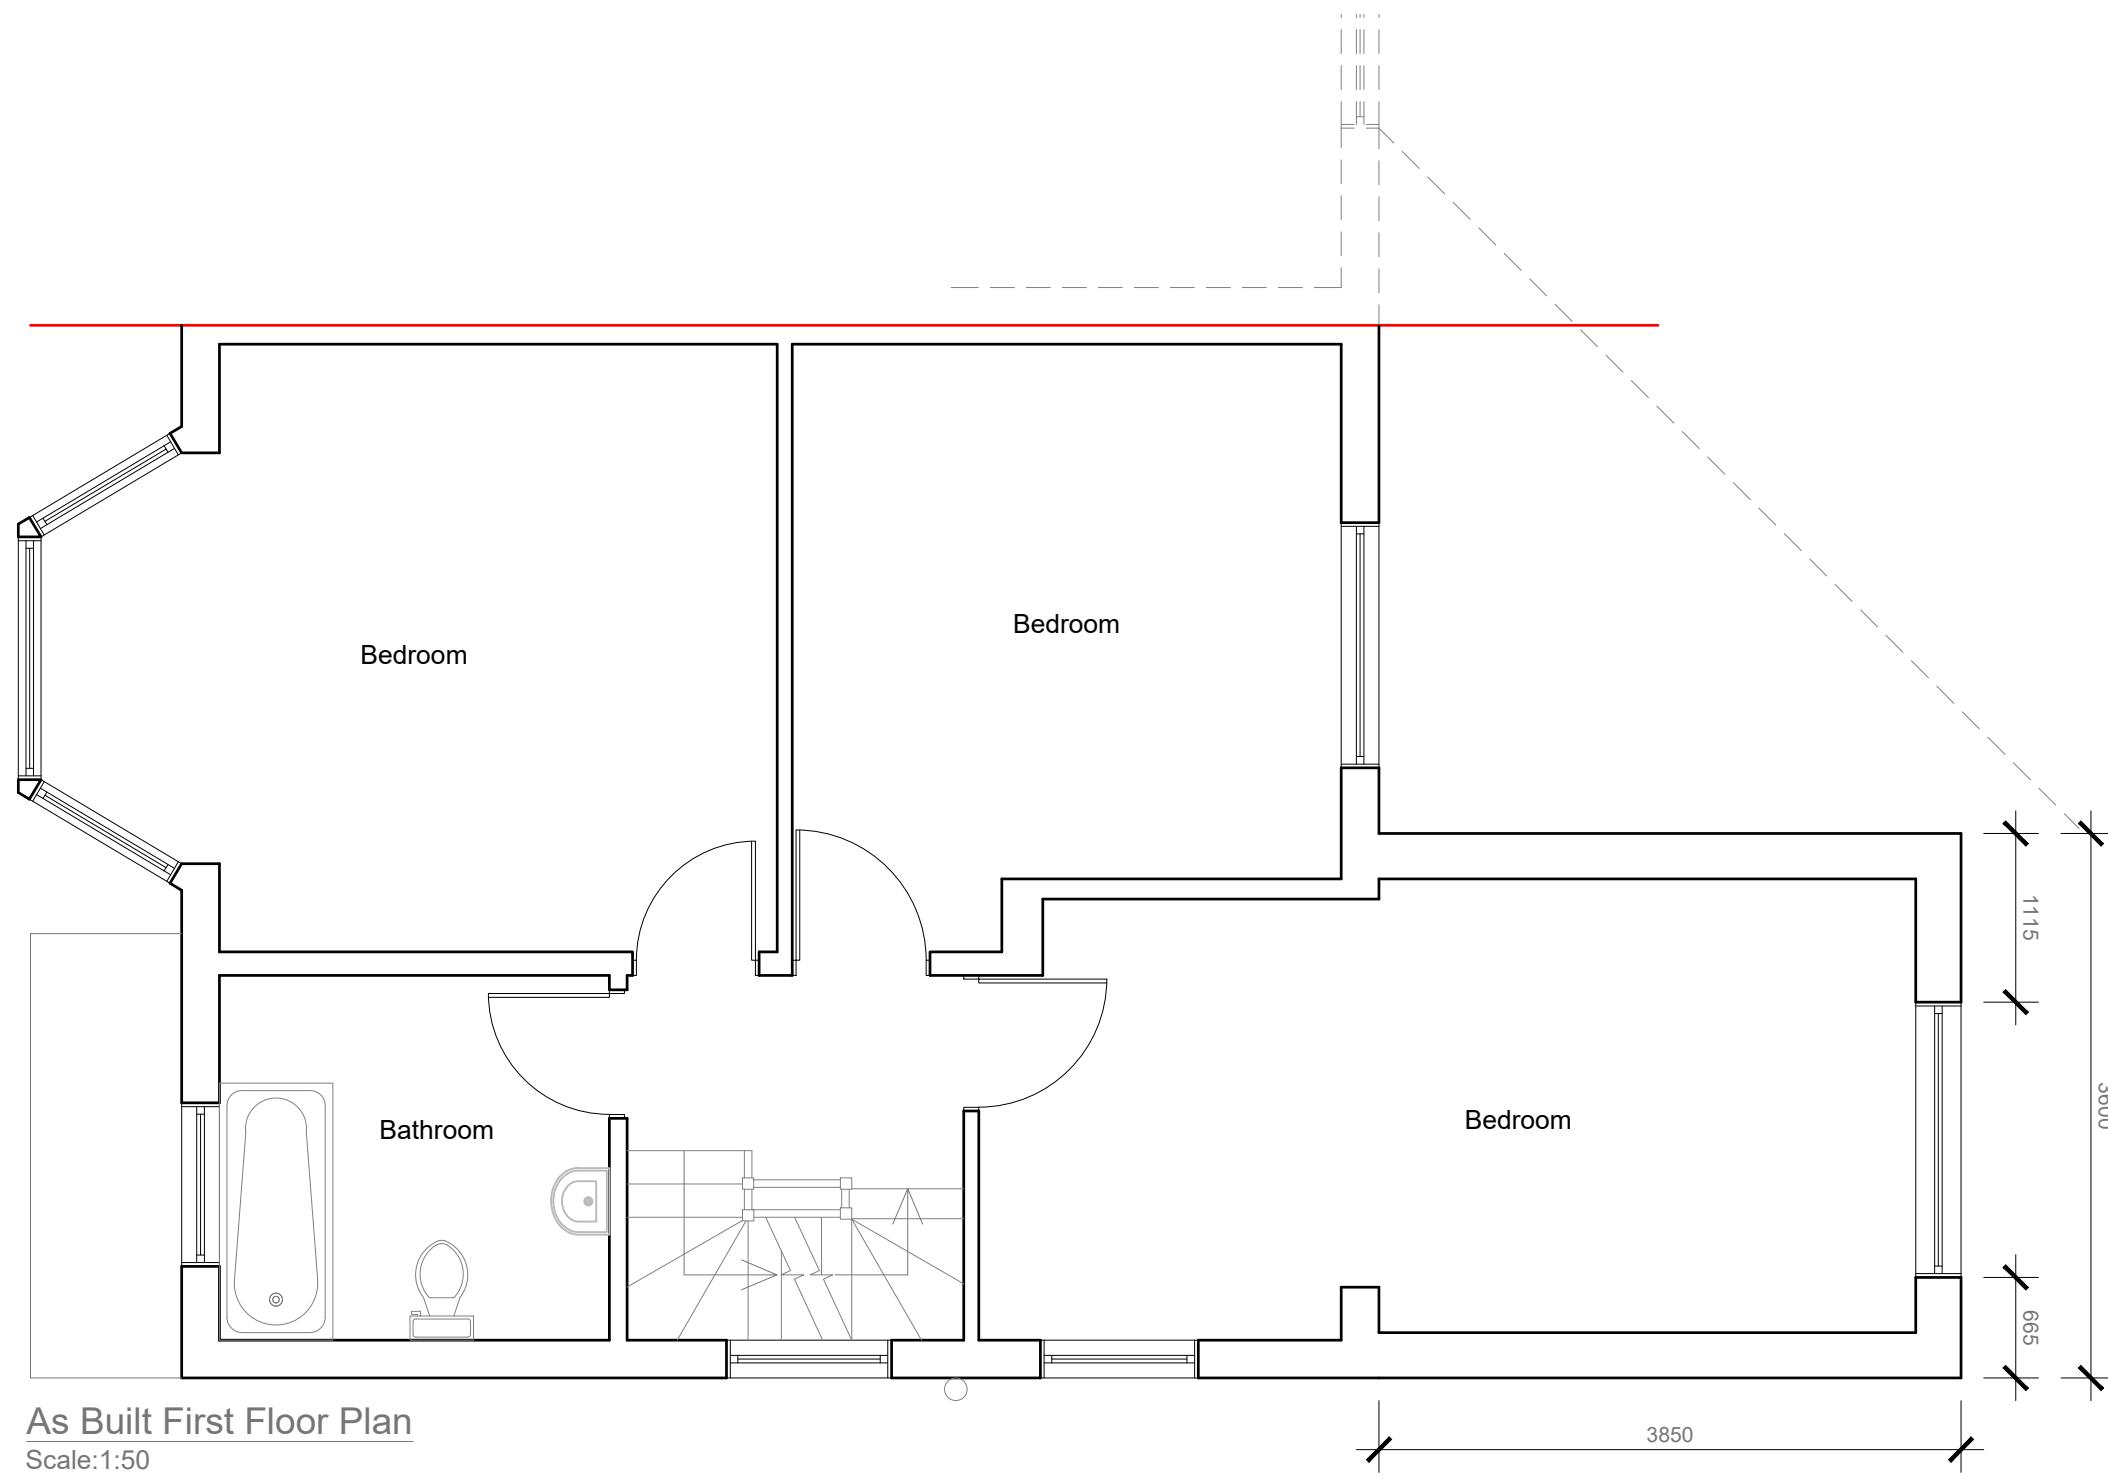

## As Built First Floor Plan


---

Scale:1:50

1:50

0 1 2 5 Meter

<p>Modhwadia Design Services</p>	<p>Project: 51 York Road Northwood HA6 1JJ</p>	<p>Title: As Built First Floor Plan</p>	<p>Scale: 1:50 @ A3 Date: June 2022 Drawing No.:</p>
			<p>MD/6020 - 08/MT</p>
<p>Revision</p>	<p> </p>	<p> </p>	<p> </p>
<p> </p>	<p> </p>	<p> </p>	<p> </p>
<p> </p>	<p> </p>	<p> </p>	<p> </p>
<p> </p>	<p> </p>	<p> </p>	

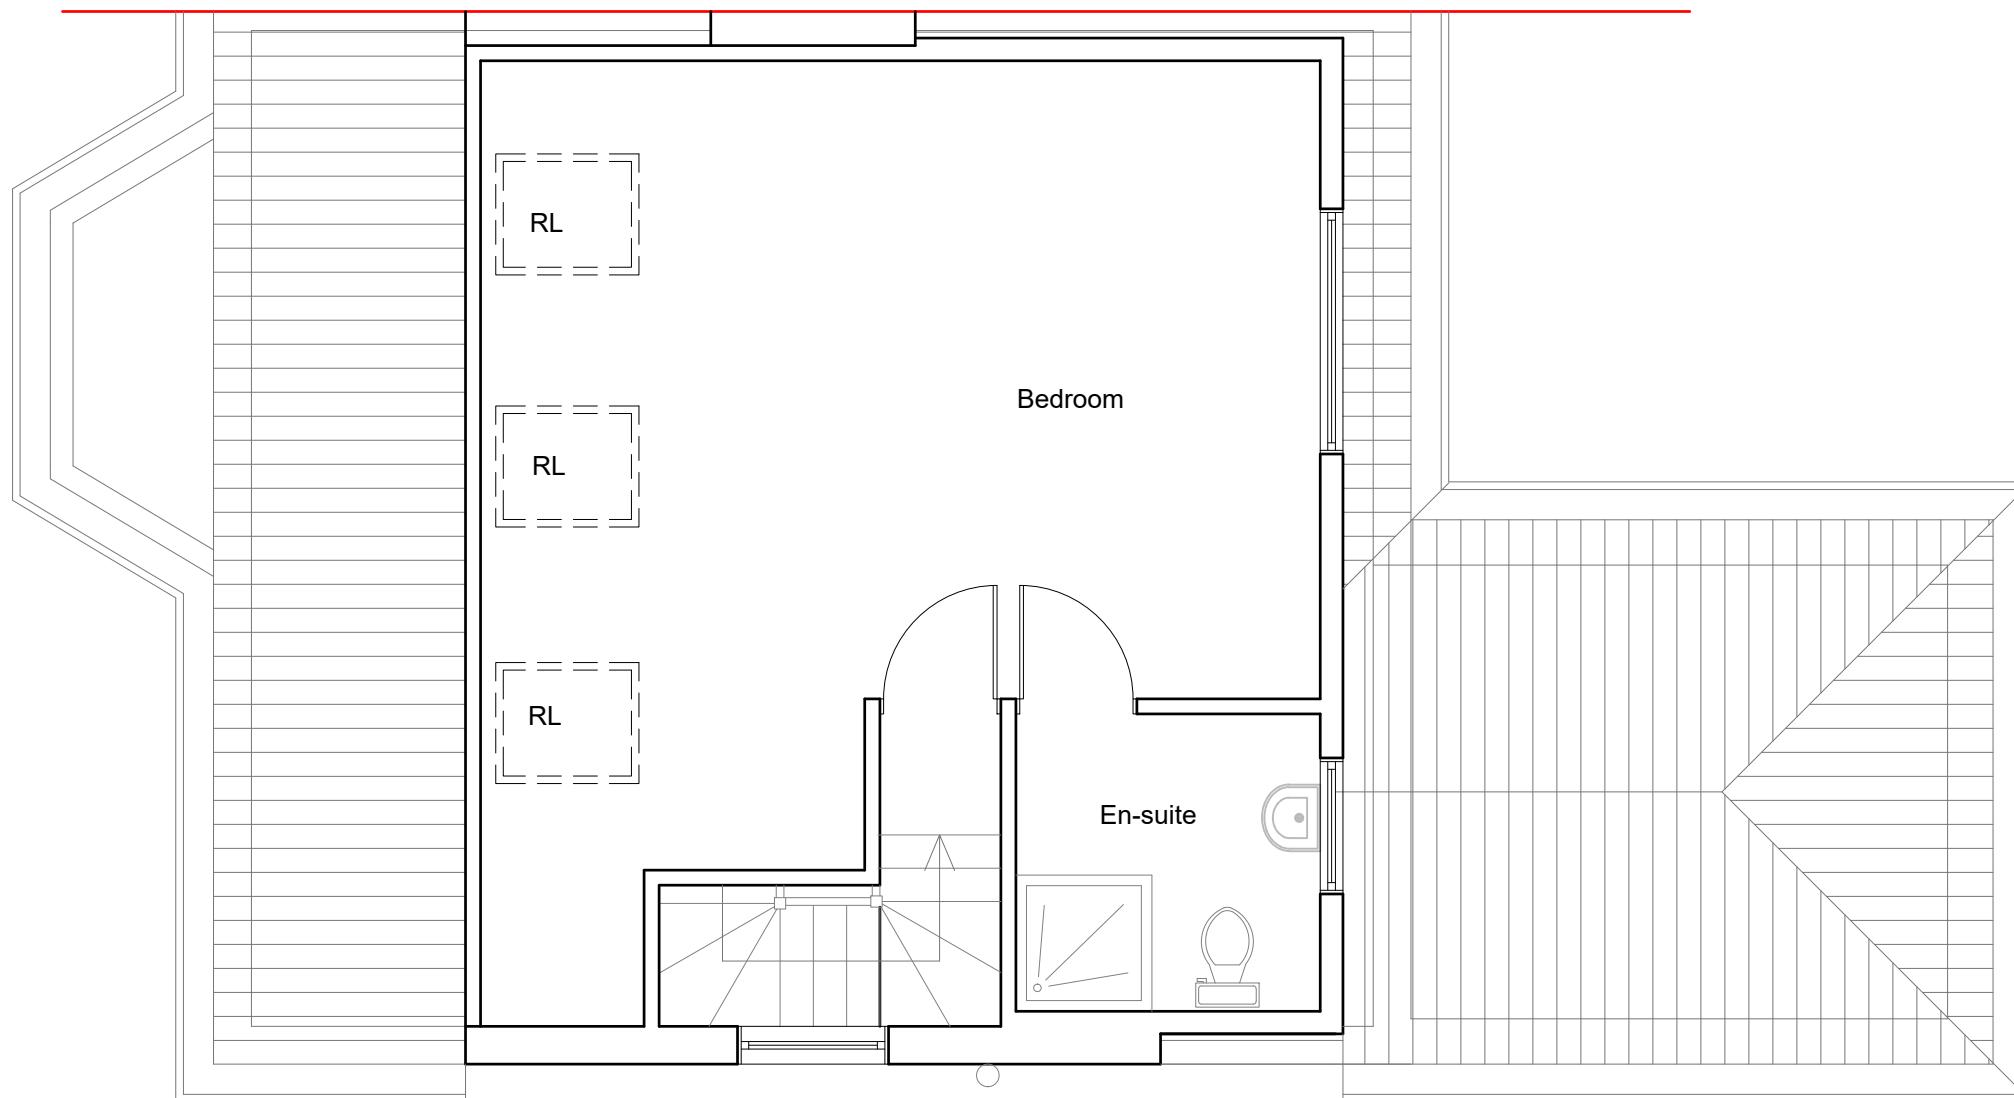

As Built Loft Plan

Scale: 1:50

1:50 5 Meter

Modhwadia Design Services	Project: 51 York Road Northwood HA6 1JJ	Title: As Built Loft Plan	Scale: 1:50 @ A3
	Date: June 2022		Date: June 2022
	Drawing No.: MD/6020 - 09/MT		Drawing No.: MD/6020 - 09/MT
	Revision		Revision
239 Western Road, Southall, Middlesex, UB2 5HS 020 8571 1369			



As Built Front Elevation

Scale: 1:100



As Built Side Elevation


Scale: 1:100

Proposed External Finish  
Materials to Match Existing  
External Finish Materials



As Built Rear Elevation

Scale: 1:100

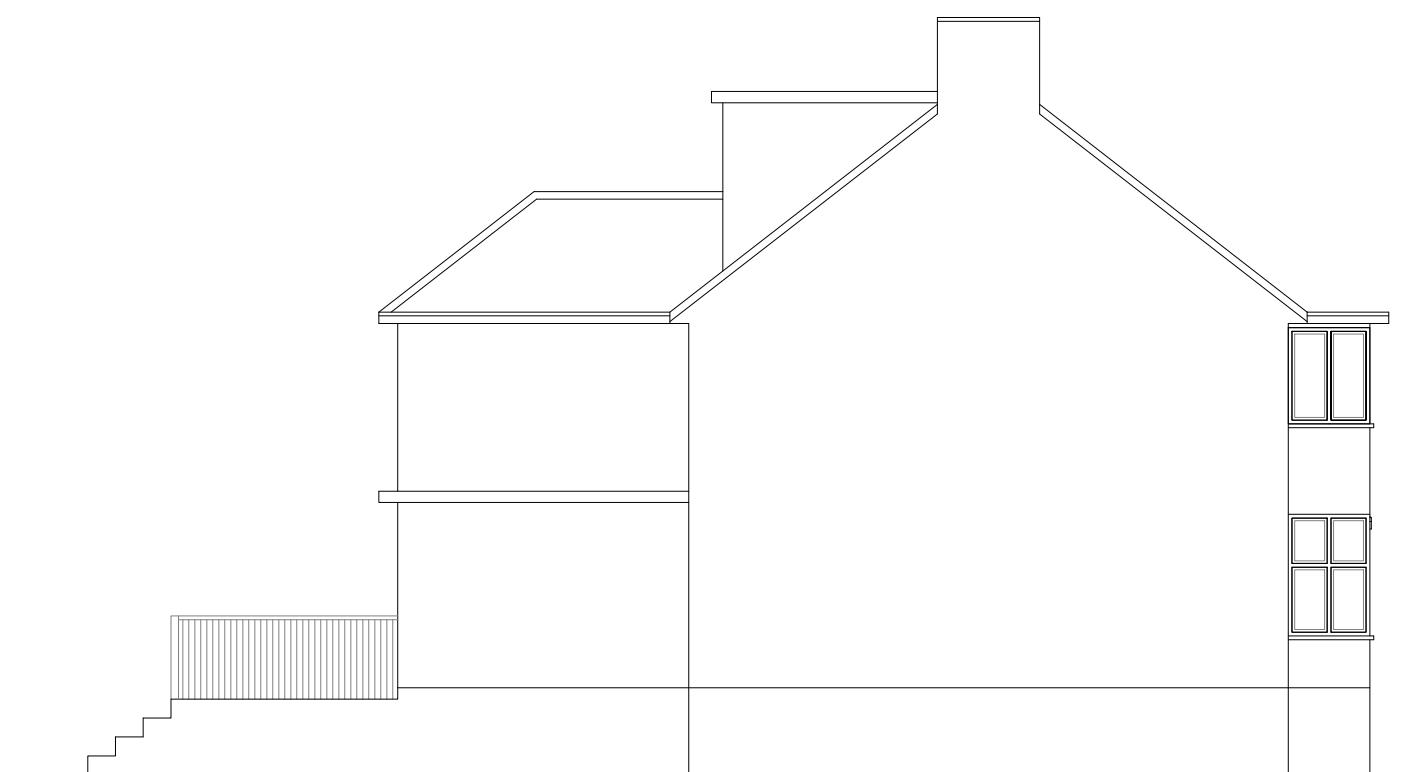

As Built Side Elevation

Scale: 1:100

1:100 0 1 2 5 10 Meter

Modhwadia Design Services	Project: 51 York Road Northwood HA6 1JJ	Title: As Built Elevations	Scale: 1:100 @ A3 Date: June 2022 Drawing No.: MD/6020 - 10/MT Revision
239 Western Road, Southall, Middlesex, UB2 5HS 020 8571 1369			