


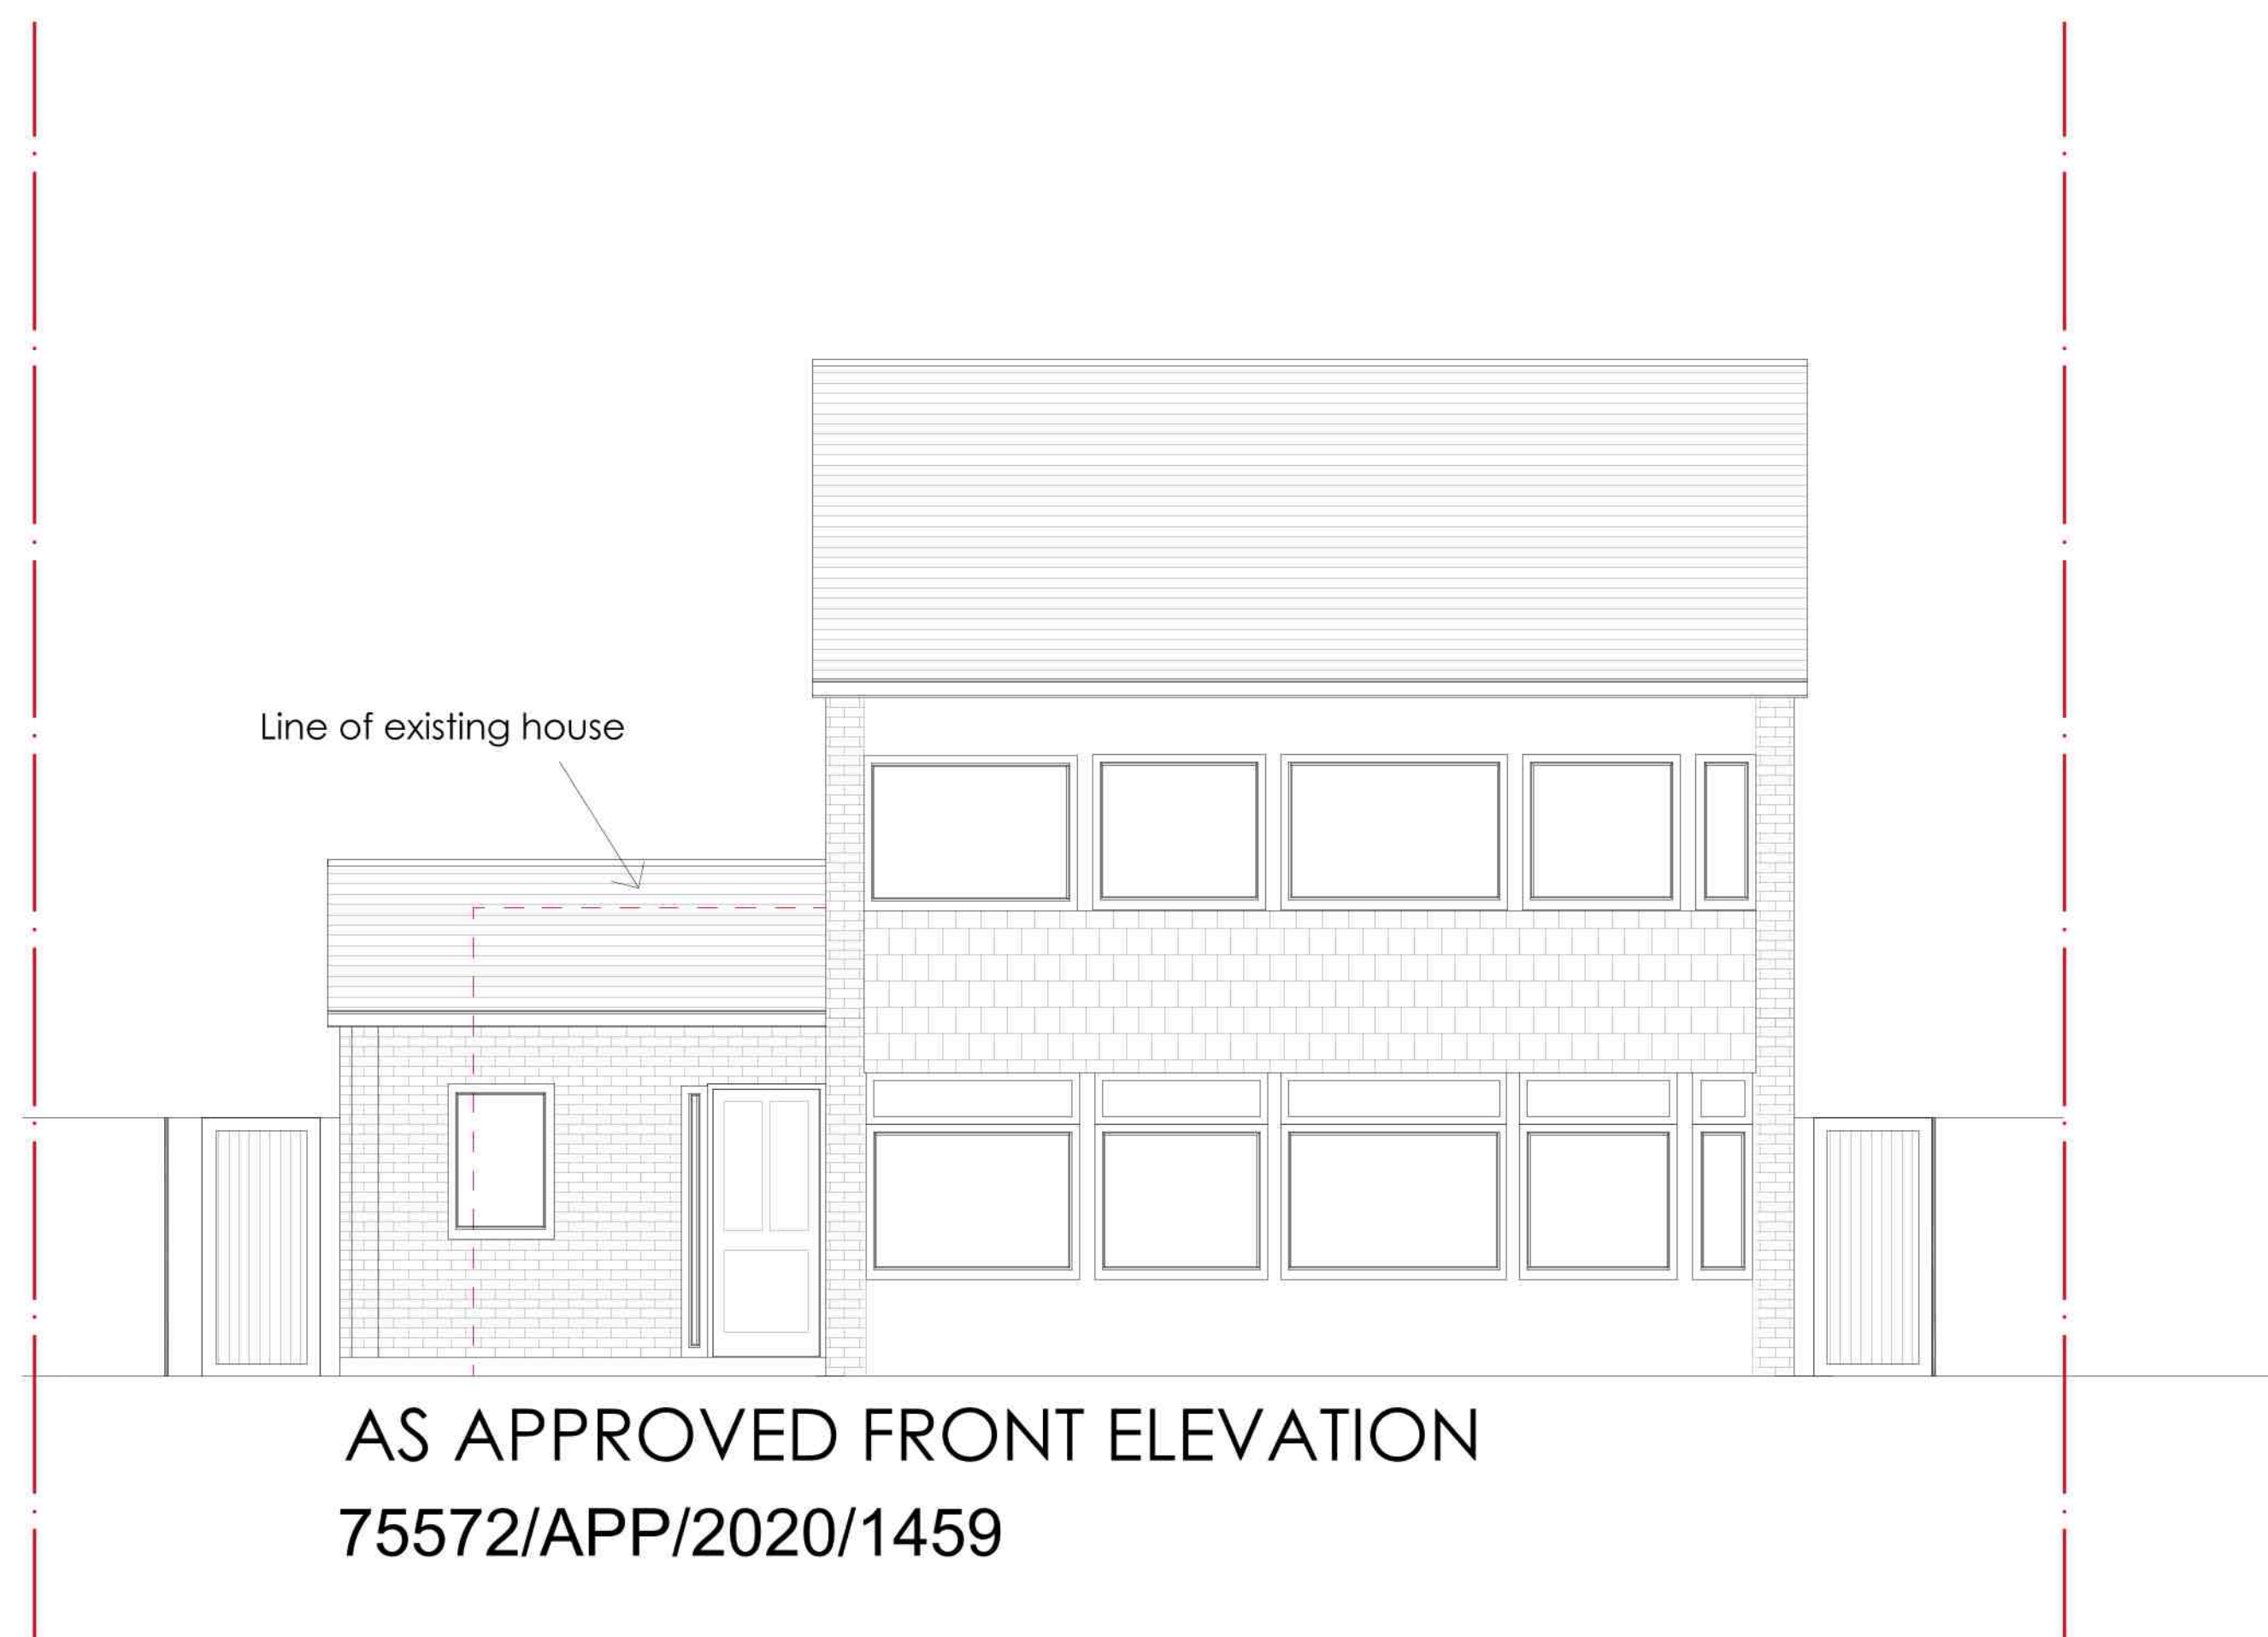

PROJECT	DWG NO.	SCALE	DETAIL	25.09.2020						PROJECT NO.	PR Architecture Ltd. Chartered Architect
1 WINDRUSH CLOSE, ICKENHAM UB10 8EJ	204	1:50 @ A1	APPROVED AND AS BUILT ELEVATIONS	SUBMITTED TO PLANNING DEPT.						20.10	
RETROSPECTIVE PLANNING											