
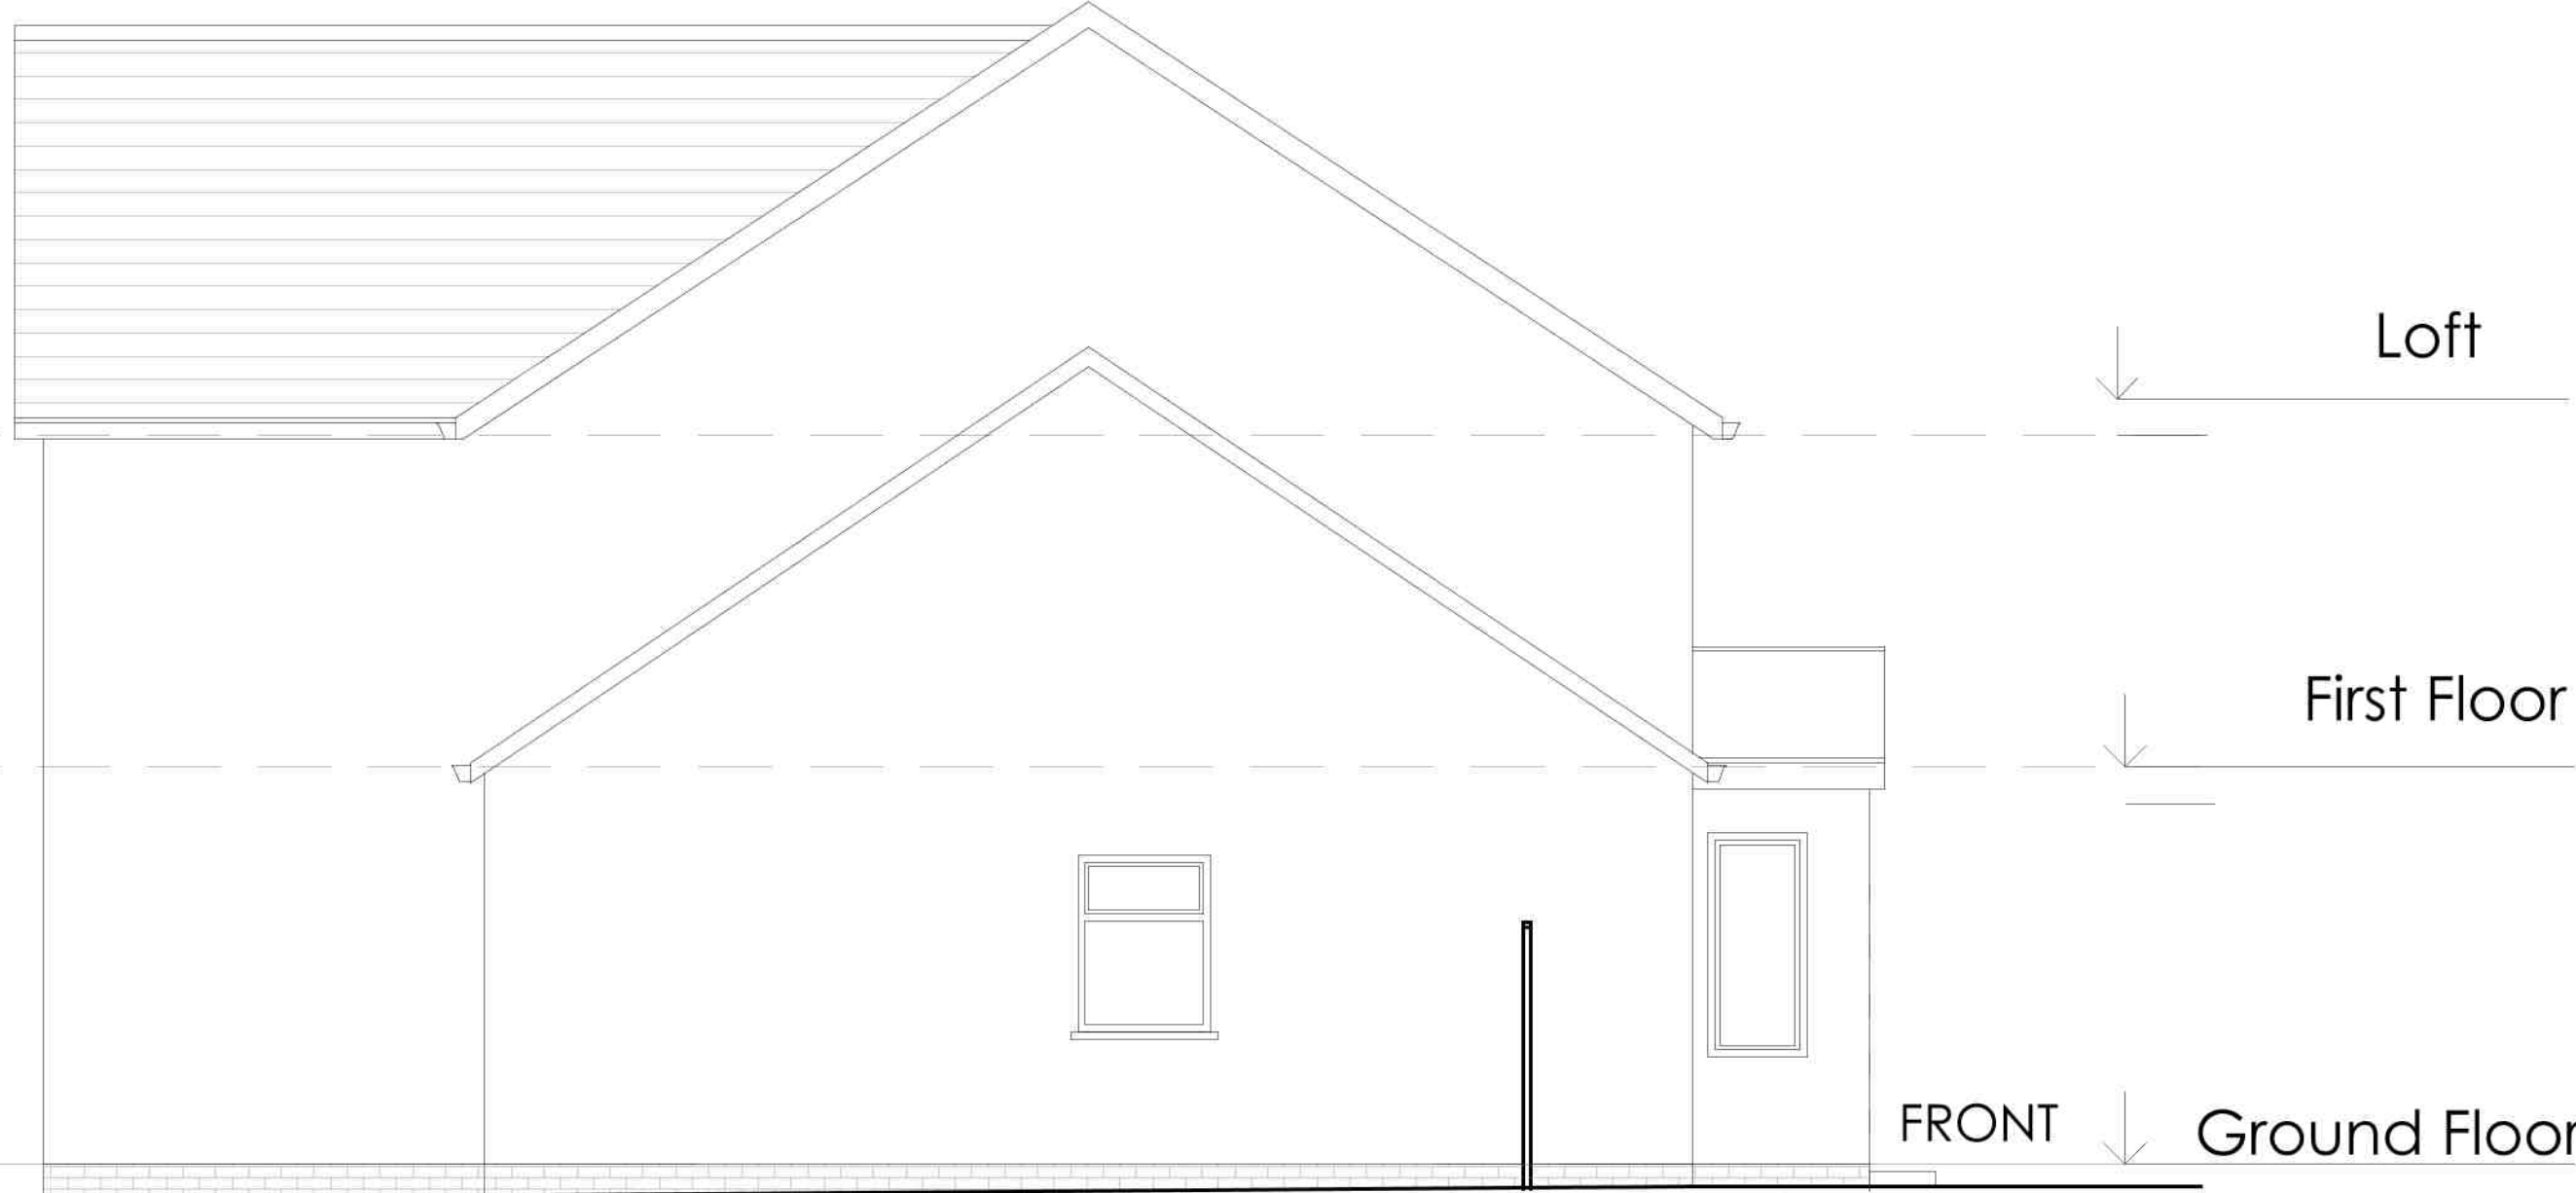


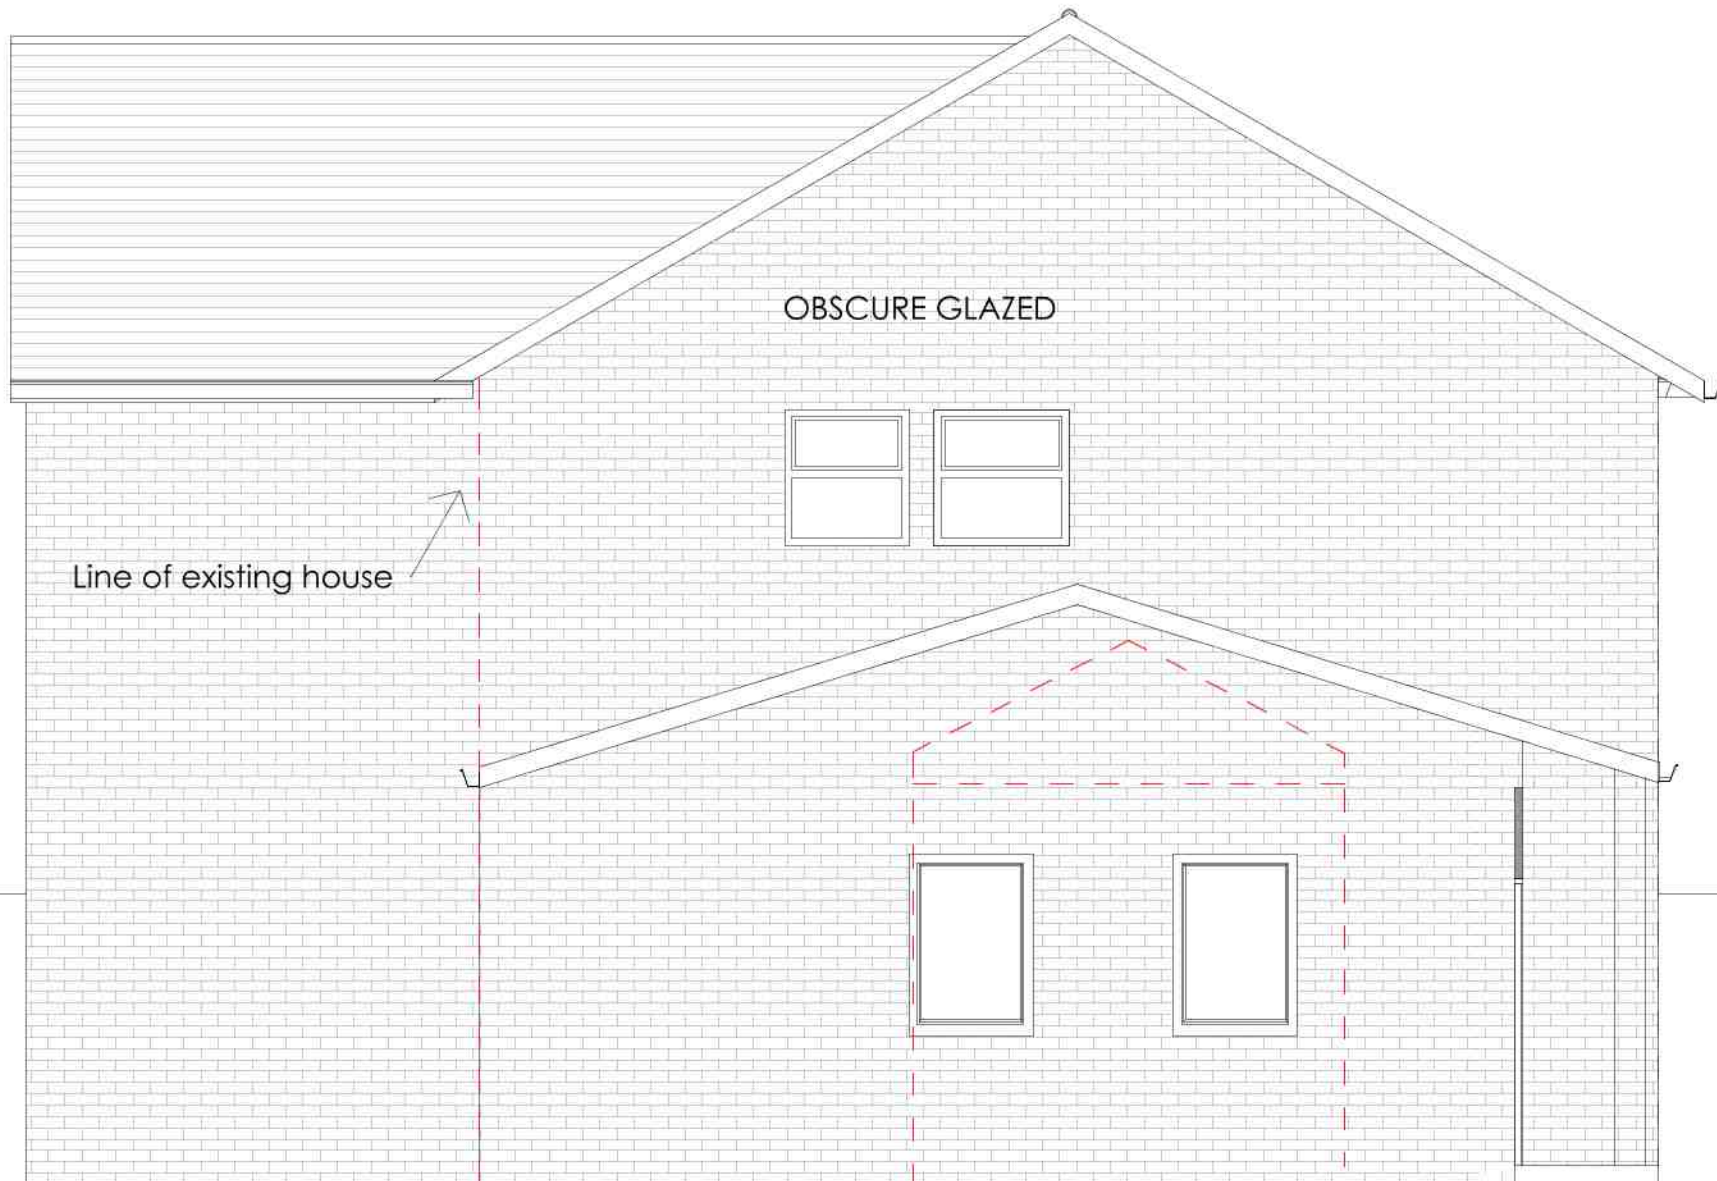

|                                     |         |              |                                     |                                   |  |  |  |  |  |             |                                                                |
|-------------------------------------|---------|--------------|-------------------------------------|-----------------------------------|--|--|--|--|--|-------------|----------------------------------------------------------------|
| PROJECT                             | DWG NO. | SCALE        | DETAIL                              | 25.09.2020                        |  |  |  |  |  | PROJECT NO. | <div>PR Architecture Ltd.</div> <div>Chartered Architect</div> |
| 1 WINDRUSH CLOSE, ICKENHAM UB10 8EJ | 205     | 1:50<br>@ A1 | APPROVED AND AS BUILT<br>ELEVATIONS | SUBMITTED TO<br>PLANNING<br>DEPT. |  |  |  |  |  | 20.10       |                                                                |
| RETROSPECTIVE PLANNING              |         |              |                                     |                                   |  |  |  |  |  |             |                                                                |