



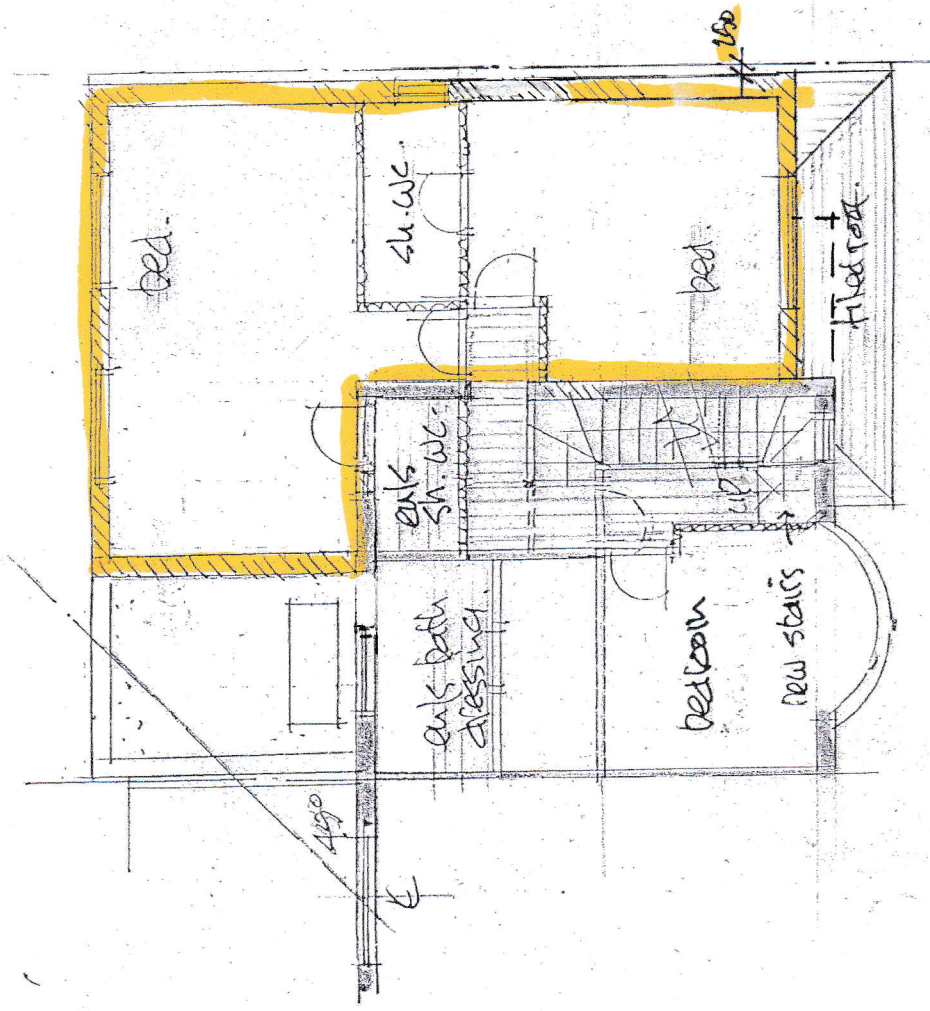

FIRST FLOOR PLAN
on

scale bar 1:100 @ A4

REVISIONS:
 A 9 May '22:
 first floor front set
 back extension depth
 reduced
 B 6 March '23:
 revised to as-built.

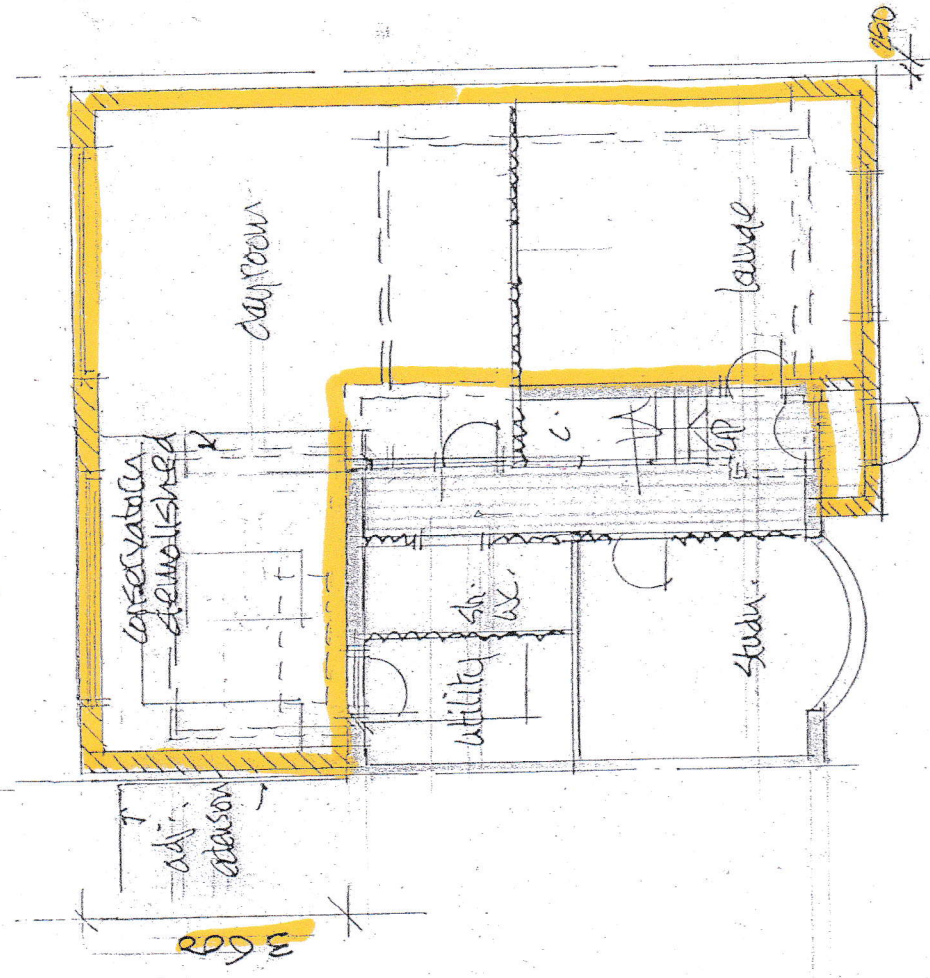

GROUND FLOOR PLAN

scale: 1:50 + 1:100		job: 33/13
date: Nov: 21		dwg. no. 10 B
drawn:		client:

DAVID BARNARD Town Planning Consultant + Building Designer 4 Barber Close, London, N21 1BE Tel: 020 8245 1583	
--	--

2 HATHERLEIGH ROAD
RUSLIP HA4 6AS

proposed extensions:
 ground + first floor
 plans