




SIDE ELEVATION to Vehicle Row.

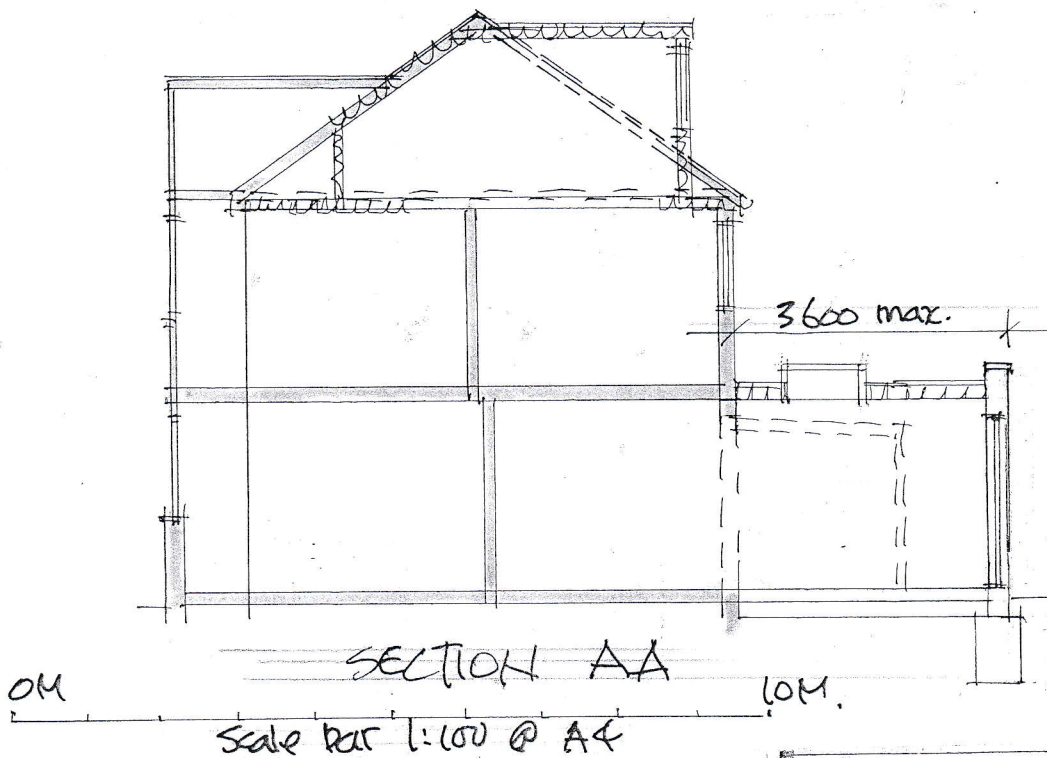

Revisions:
 A - 9 May '22
 front set back,
 extension
 depth reduced
 B - 6 March '23
 side elevation
 revised to
 as-built.

2 HATHERLEIGH ROAD
 RUISLIP HA4 6AS

proposed extensions:
 elevation + section:

scale: 1:50 + 1:100

date:

drawn:

client:

job:

3313

dwg. no:

13 B

DAVID BARNARD

Town Planning Consultant + Building Designer

4 Barber Close, London, N21 1BE

Tel: 020 8245 1583