


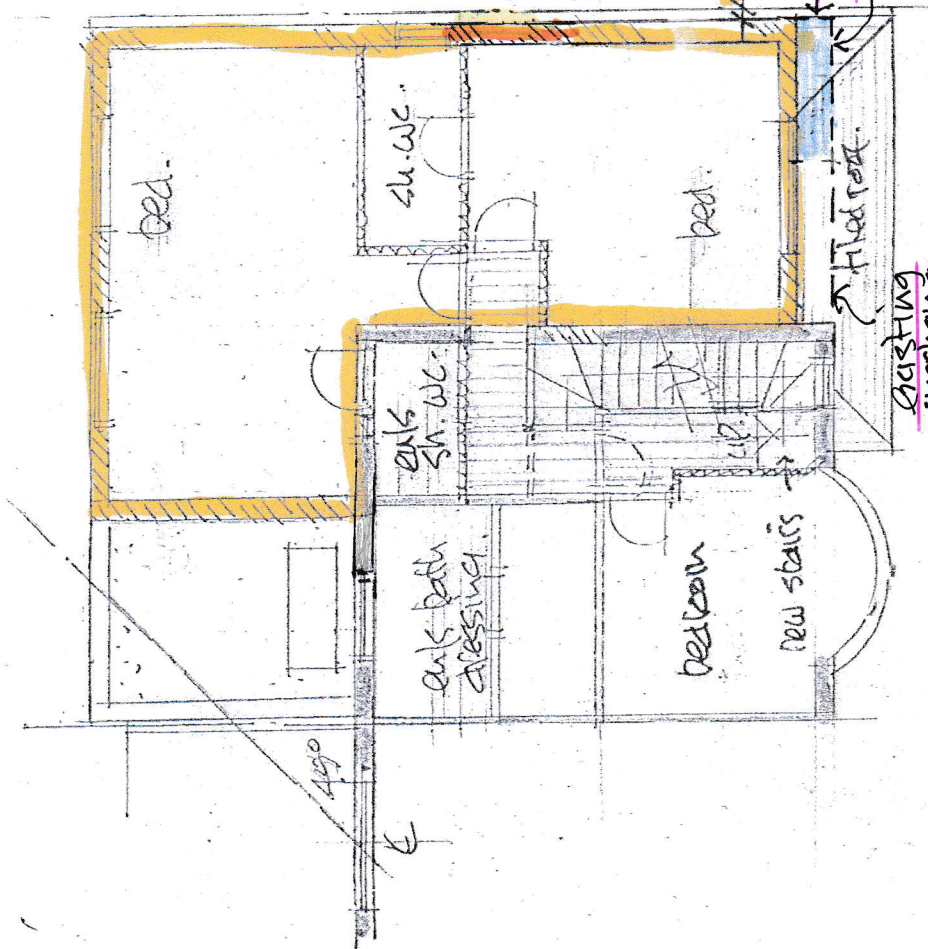


existing overhang

FIRST FLOOR PLAN

on

scale bar 1:100 @ A4

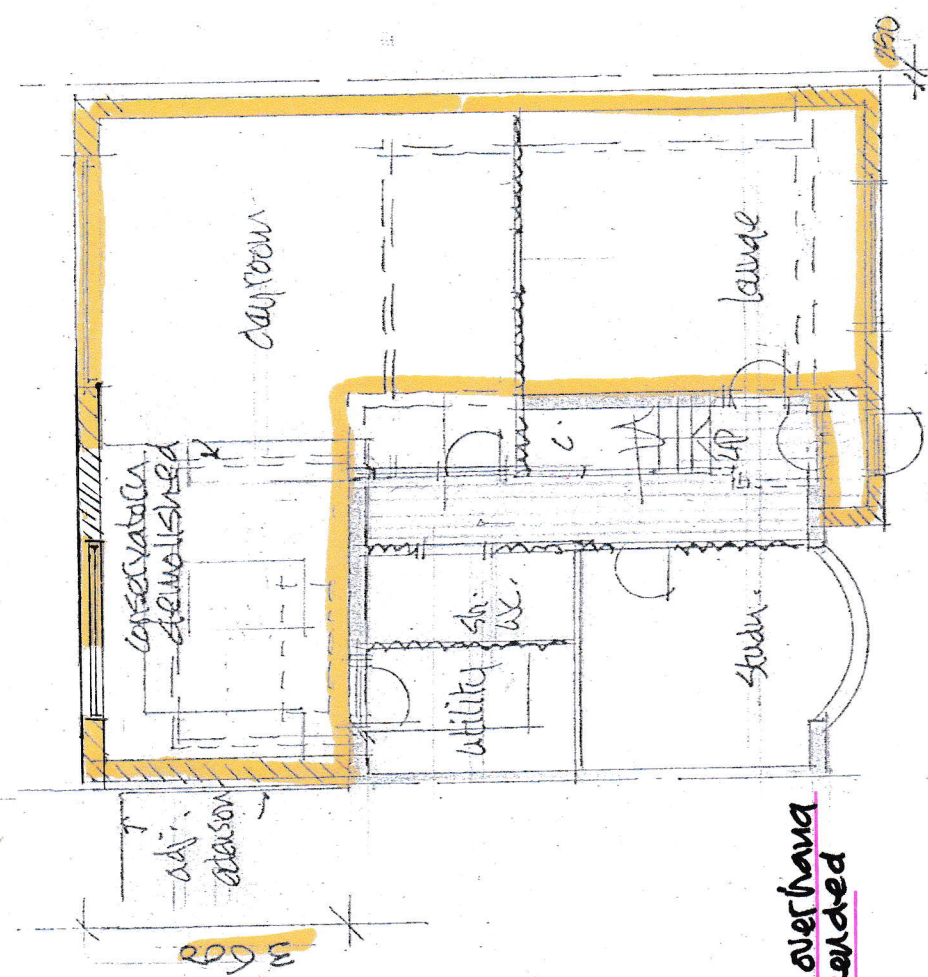

GROUND FLOOR PLAN

scale bar 1:100 @ A4

REVISIONS:

- A 9 May '22
- first floor front set back, extension depth reduced
- B 6 March '23 revised to as-built
- C 23 Oct '23 front roof pitch extended

2 HATHERLEIGH ROAD
RUISLIP HA4 6AS

proposed extensions:
ground + first floor
plans

scale: 1:50 & 1:100	loc: 33/13
date: Nov '21	
drawn:	dwg. no: 106
client:	

DAVID BARNARD
Town Planning Consultant + Building Designer
4 Barber Close, London, N21 1BE
Tel: 020 8245 1583