


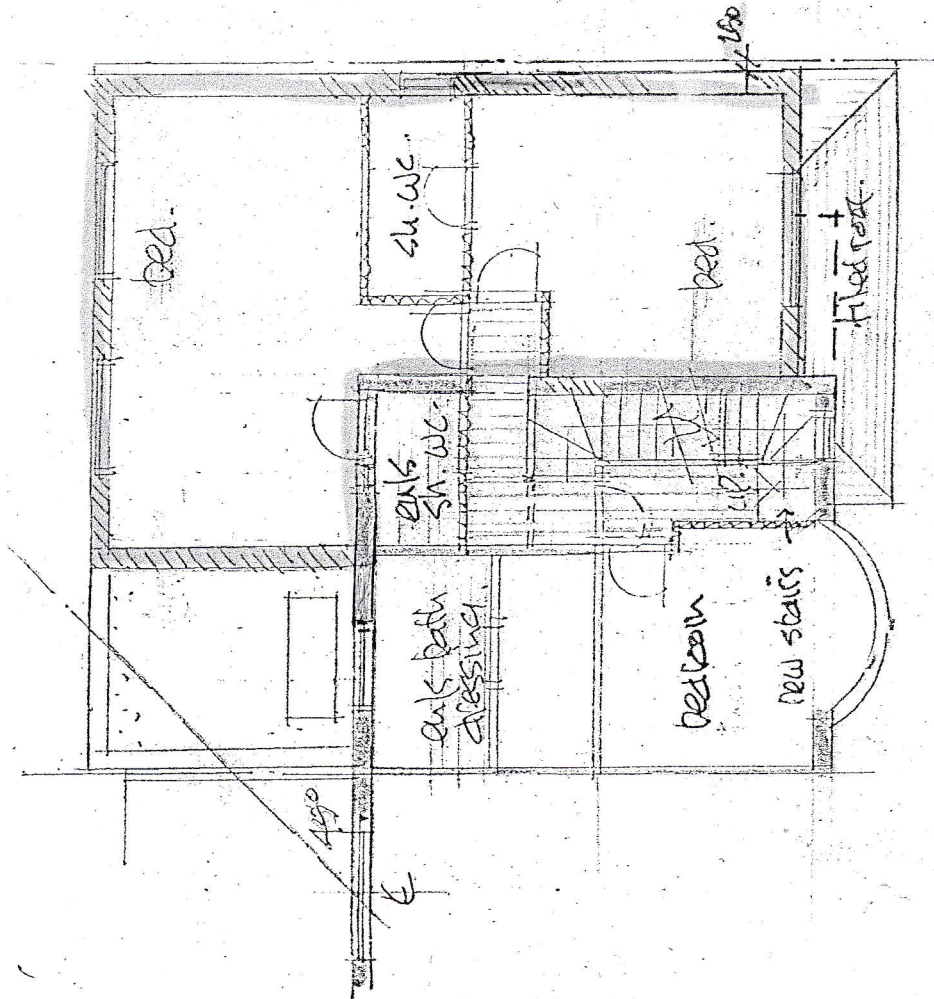


FIRST FLOOR PLAN
on

scale bar 1:100 @ A4

GROUND FLOOR PLAN

10M.

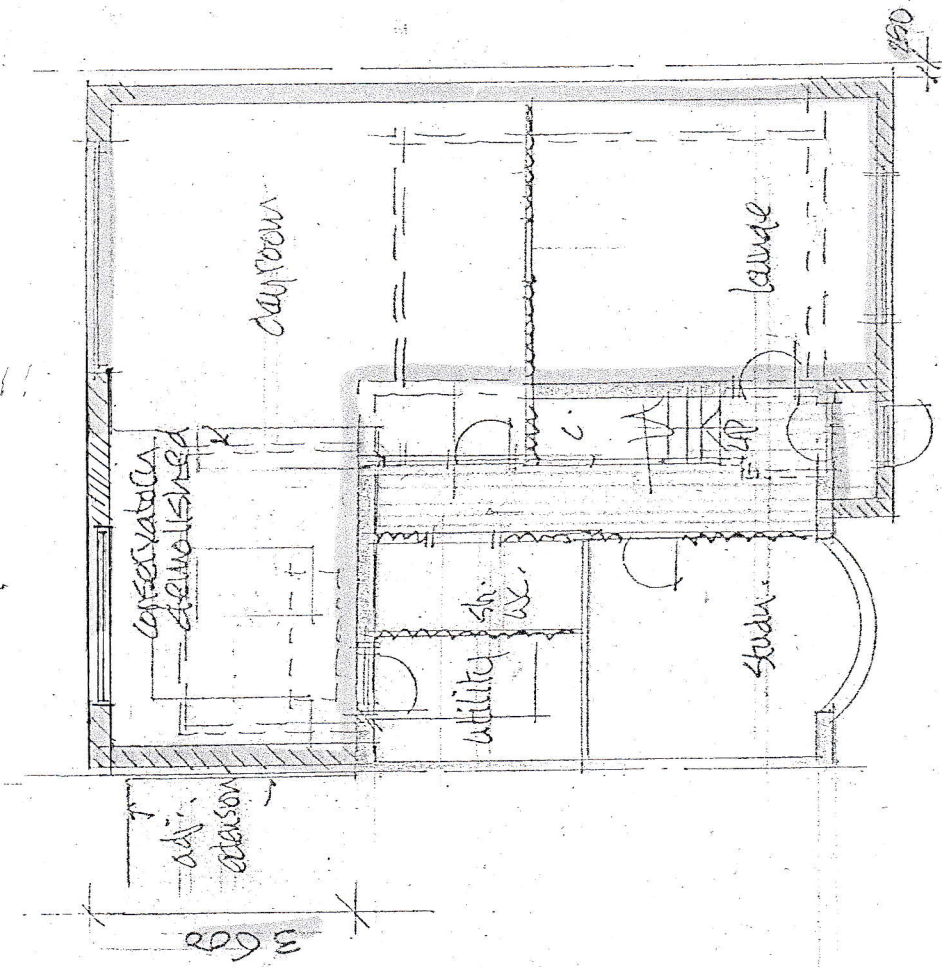

REVISIONS:

- A 9 May '22
first floor front set
back, extension depth
reduced
- B 6 March '23
revised to as-built.

scale: 1:50 + 1:100	job: 3313
date: rev: 21	
drawn:	dwg. no: 10B
client:	

DAVID BARNARD
Town Planning Consultant + Building Designer
4 Barber Close, London, N21 1BE
Tel: 020 8245 1383