


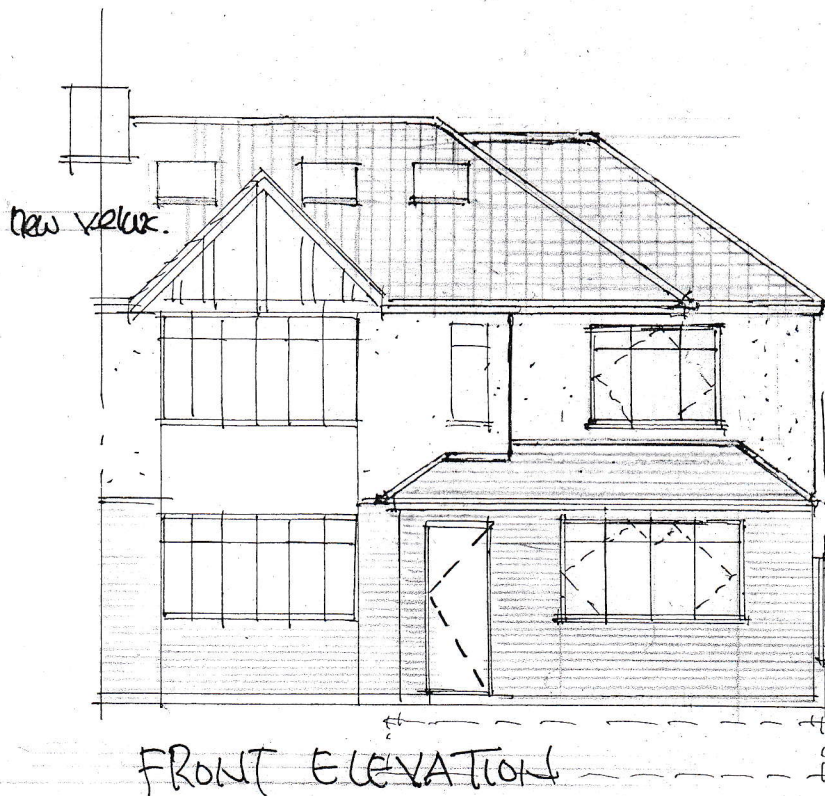

all new external
finishes to
match existing.

B 6 march '23.
elevations
revised to
as-built.

A 9 may '22
first floor set back,
dormer reduced
revisions:

OM

scale bar 1:100 @ A4

OM

2 HATHERLEIGH ROAD
RUISLIP HA4 6AS

proposed extensions:
elevations:

scale: 1:50 + 1:100

date: nov '21

drawn:

client:

job:

3313

dwg. no:

12B

DAVID BARNARD

Town Planning Consultant + Building Designer

4 Barber Close, London, N21 1BE

Tel: 020 8245 1563