



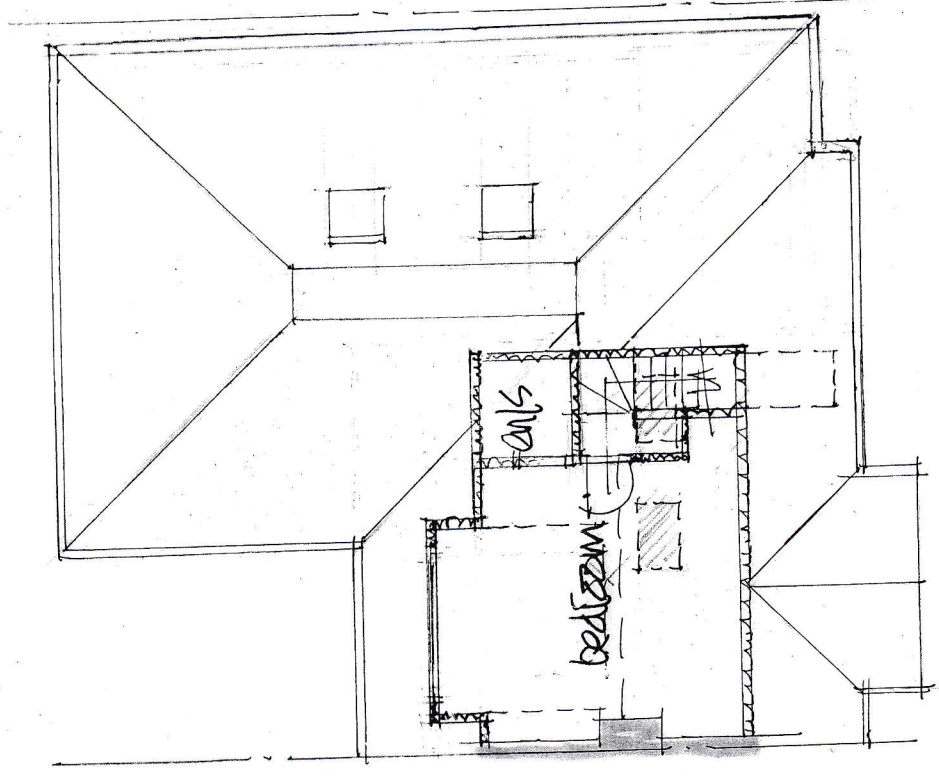

FIRST FLOOR PLAN

on scale bar 1:100 @ A4

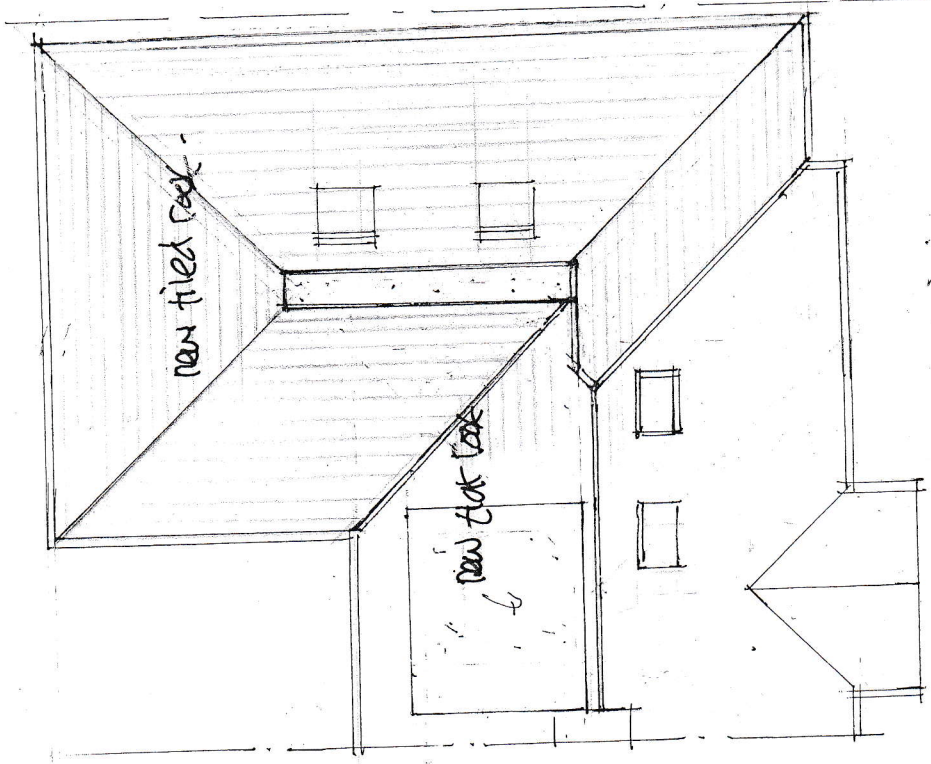

ROOF PLAN

revisions:
rev. A 9 May 22
Roof plan amended.
B 6 March 23
Roof plan
amended to as-built.

scale: 1:50 + 1:100	job: 3313
date: NOV 21	
drawn:	dwg. no: 11B
client:	

DAVID BARNARD
Town Planning Consultant + Building Designer
4 Barber Close, London, N21 1BE
Tel: 020 8245 1583

2 HATHERLEIGH ROAD
RUISLIP HA4 6AS

proposed extensions:
loft + roof plans: