


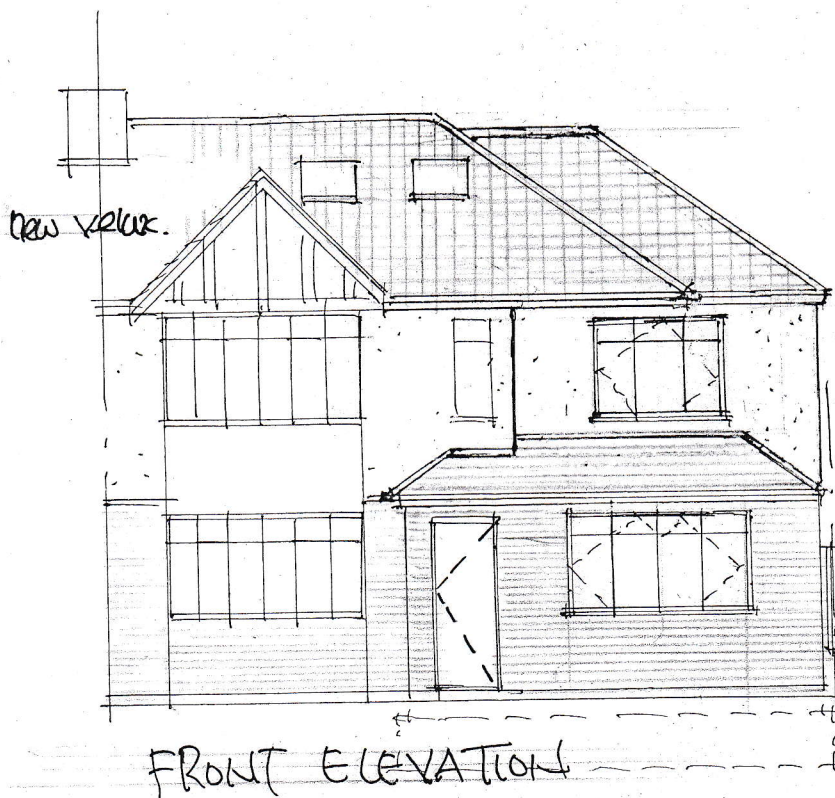

all new external  
finishes to  
match existing.

B 6 March '23  
elevations  
revised to  
as-built.

A 9 May '22  
first floor set back,  
dormer reduced  
revisions:

OM Scale bar 1:100 @ A4 10M

2 HATHERLEIGH ROAD  
RUSLIP HA4 6AS

proposed extensions:  
elevations:

scale: 1:50 + 1:100

date: Nov: 21

drawn:

client:

job:

3313

dwg. no:

12 B

DAVID BARNARD

Town Planning Consultant + Building Designer

4 Barber Close, London, N21 1BE

Tel: 020 8245 1583