





LD APPROVED SCHEME REF. 4516/APP/2021/3093  
Conversion of roof space to habitable use to include a rear dormer and  
conversion of roof from hip to gable end at both 104 and 106 Windsor Avenue  
(Application for a Certificate of Lawful Development for a Proposed  
Development)

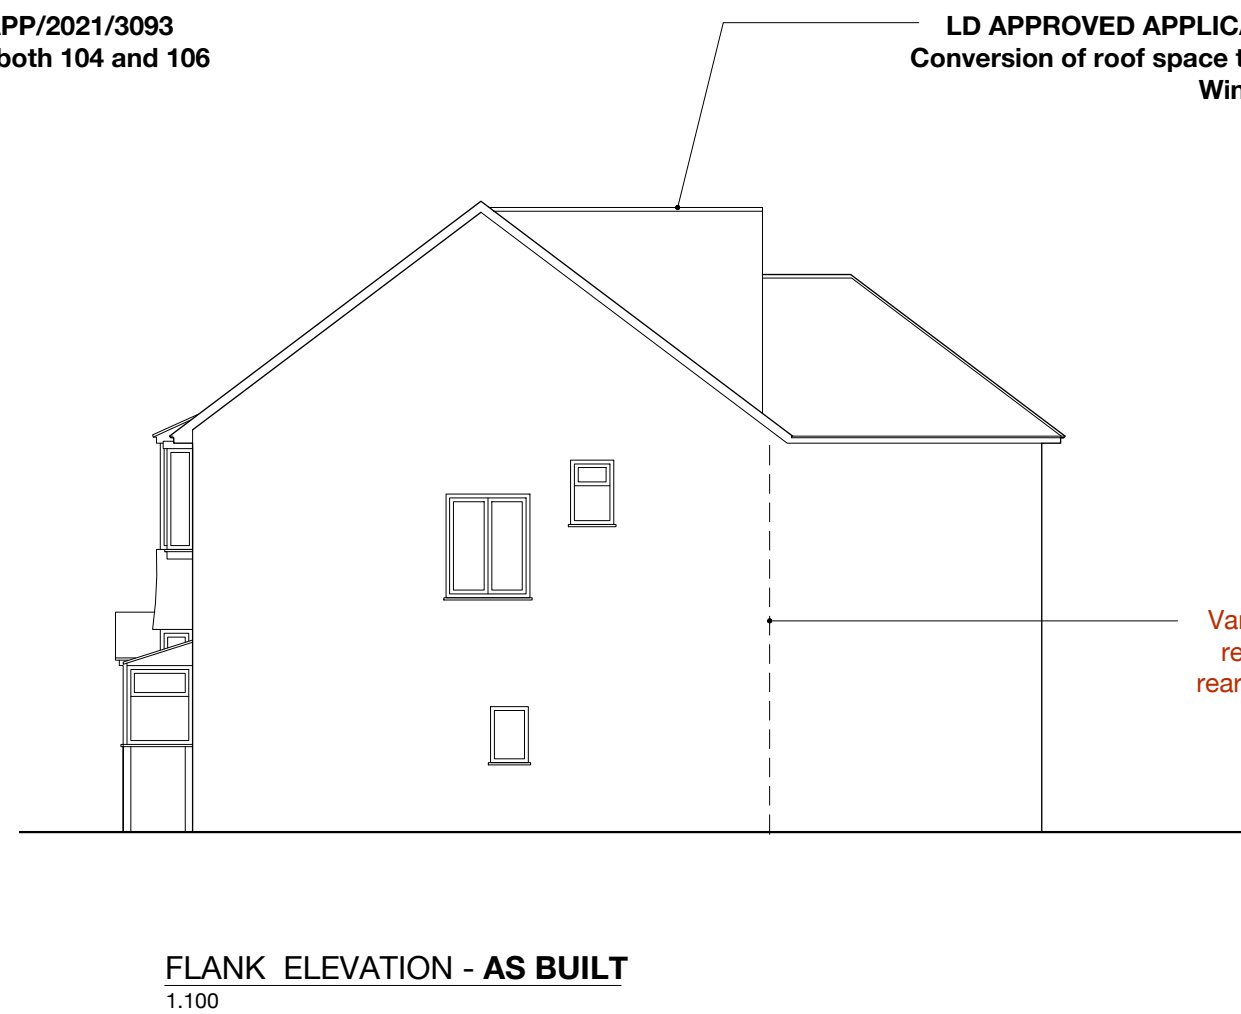

Variation to approved scheme  
ref.: 76665/APP/2021/3083  
rear extension flank wall aligned  
with main dwelling

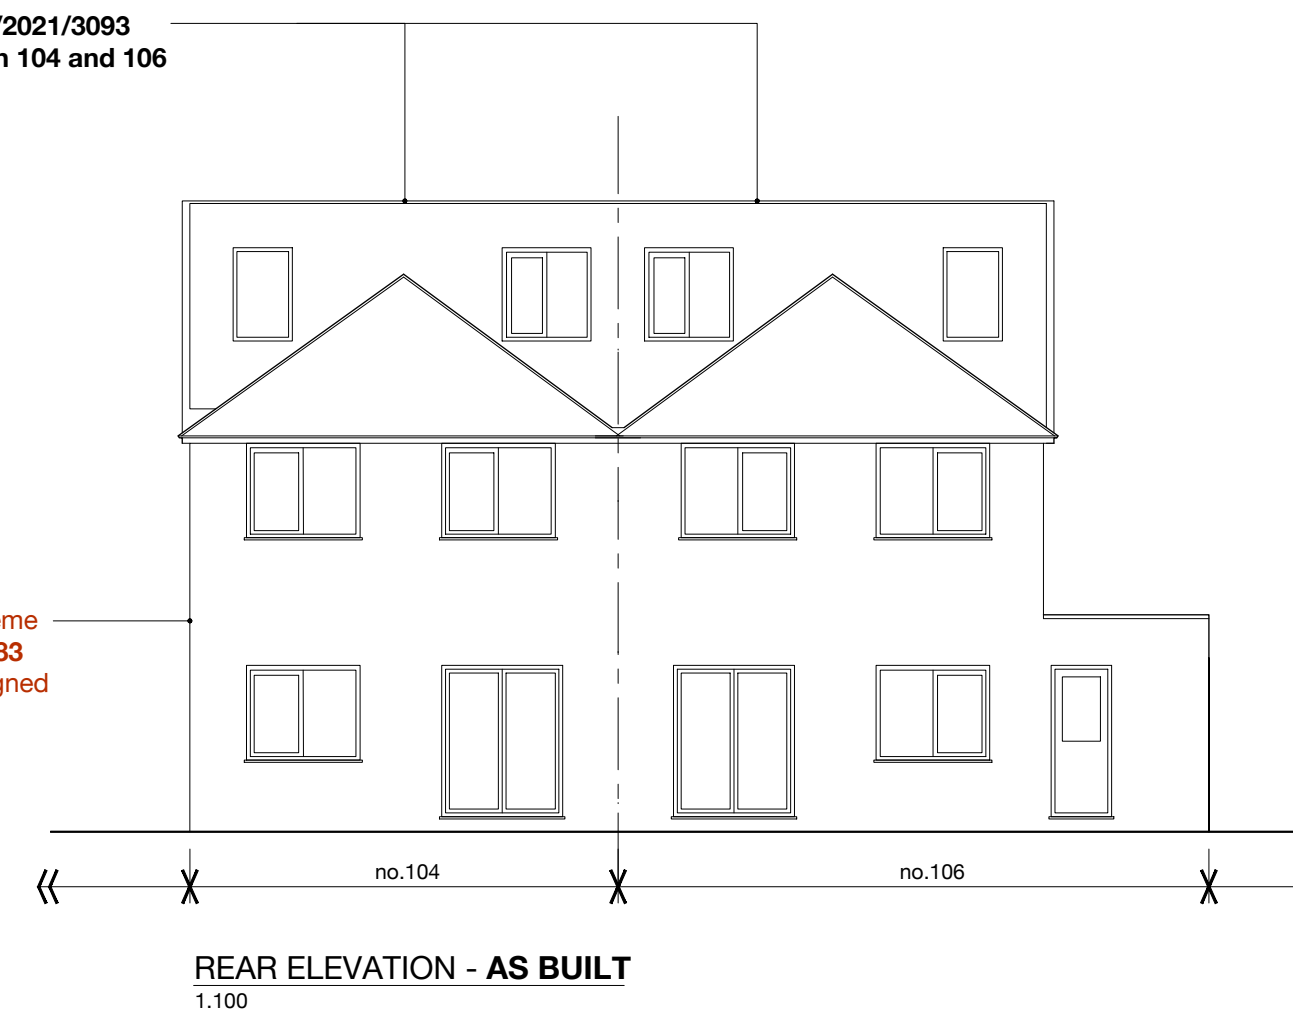

Revision			

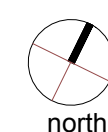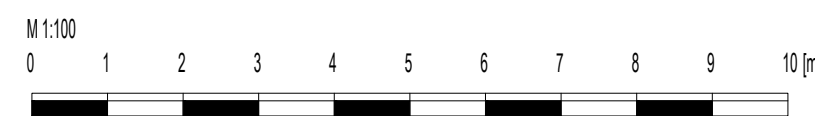

drawing notes		© KAA Architects Ltd 2021	
All rights described in chapter IV of the Copyright Designs & Patents Act 1988 have been generally asserted. This Drawing must not be scaled; only figured dimensions should be used. If there are any discrepancies, or contradictions between this and other information, it should be brought to the Architect's attention.			
client: Mr Lakhwinder Singh		project: 104 & 106 Windsor Avenue, Uxbridge U10	
drawing title: <b>AS BUILT - PLANS + ELEVATIONS</b>			
date: Dec. 2022	scale: 1:100 @A1 1:200 @A3	project no.: <b>2022.010</b>	drawing no.: <b>C02</b>