


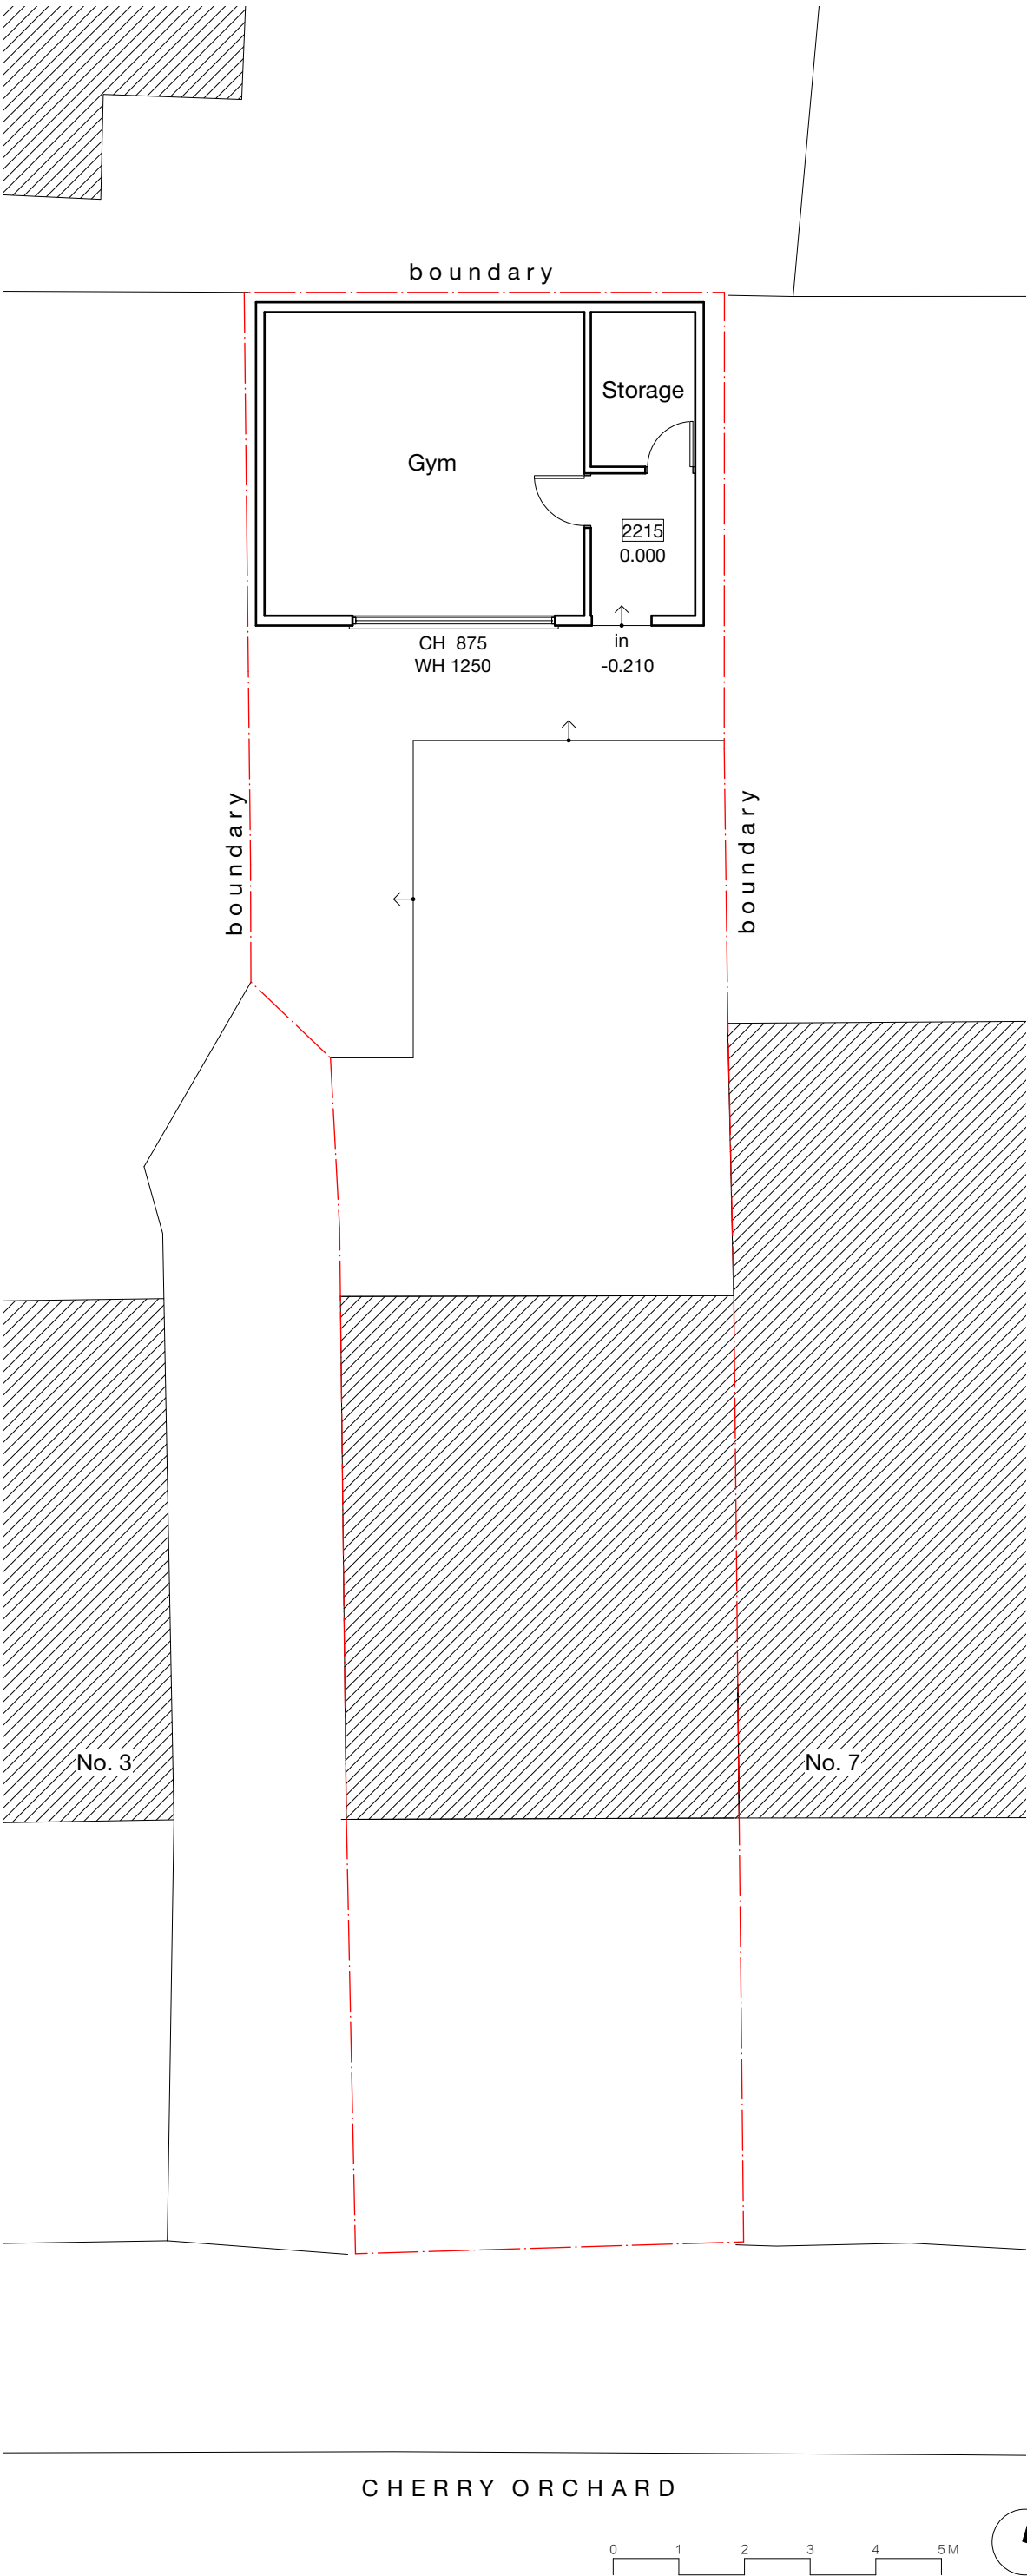


Notes

CH	cill height
WH	window height
3421	ceiling height

	client Shiv Aum Properties Ltd		
www.masonwoodgroup.co.uk gc@masonwoodgroup.co.uk +44 7498 589399	project 5 Cherry Orchard, West Drayton UB7 7JR		
	drawing EXISTING GROUND FLOOR PLAN		
	date Sep. 2021	scale 1:100 at A3	project no 2021.056
	work stage 1	drawing no S02	revision -

AS BUILT

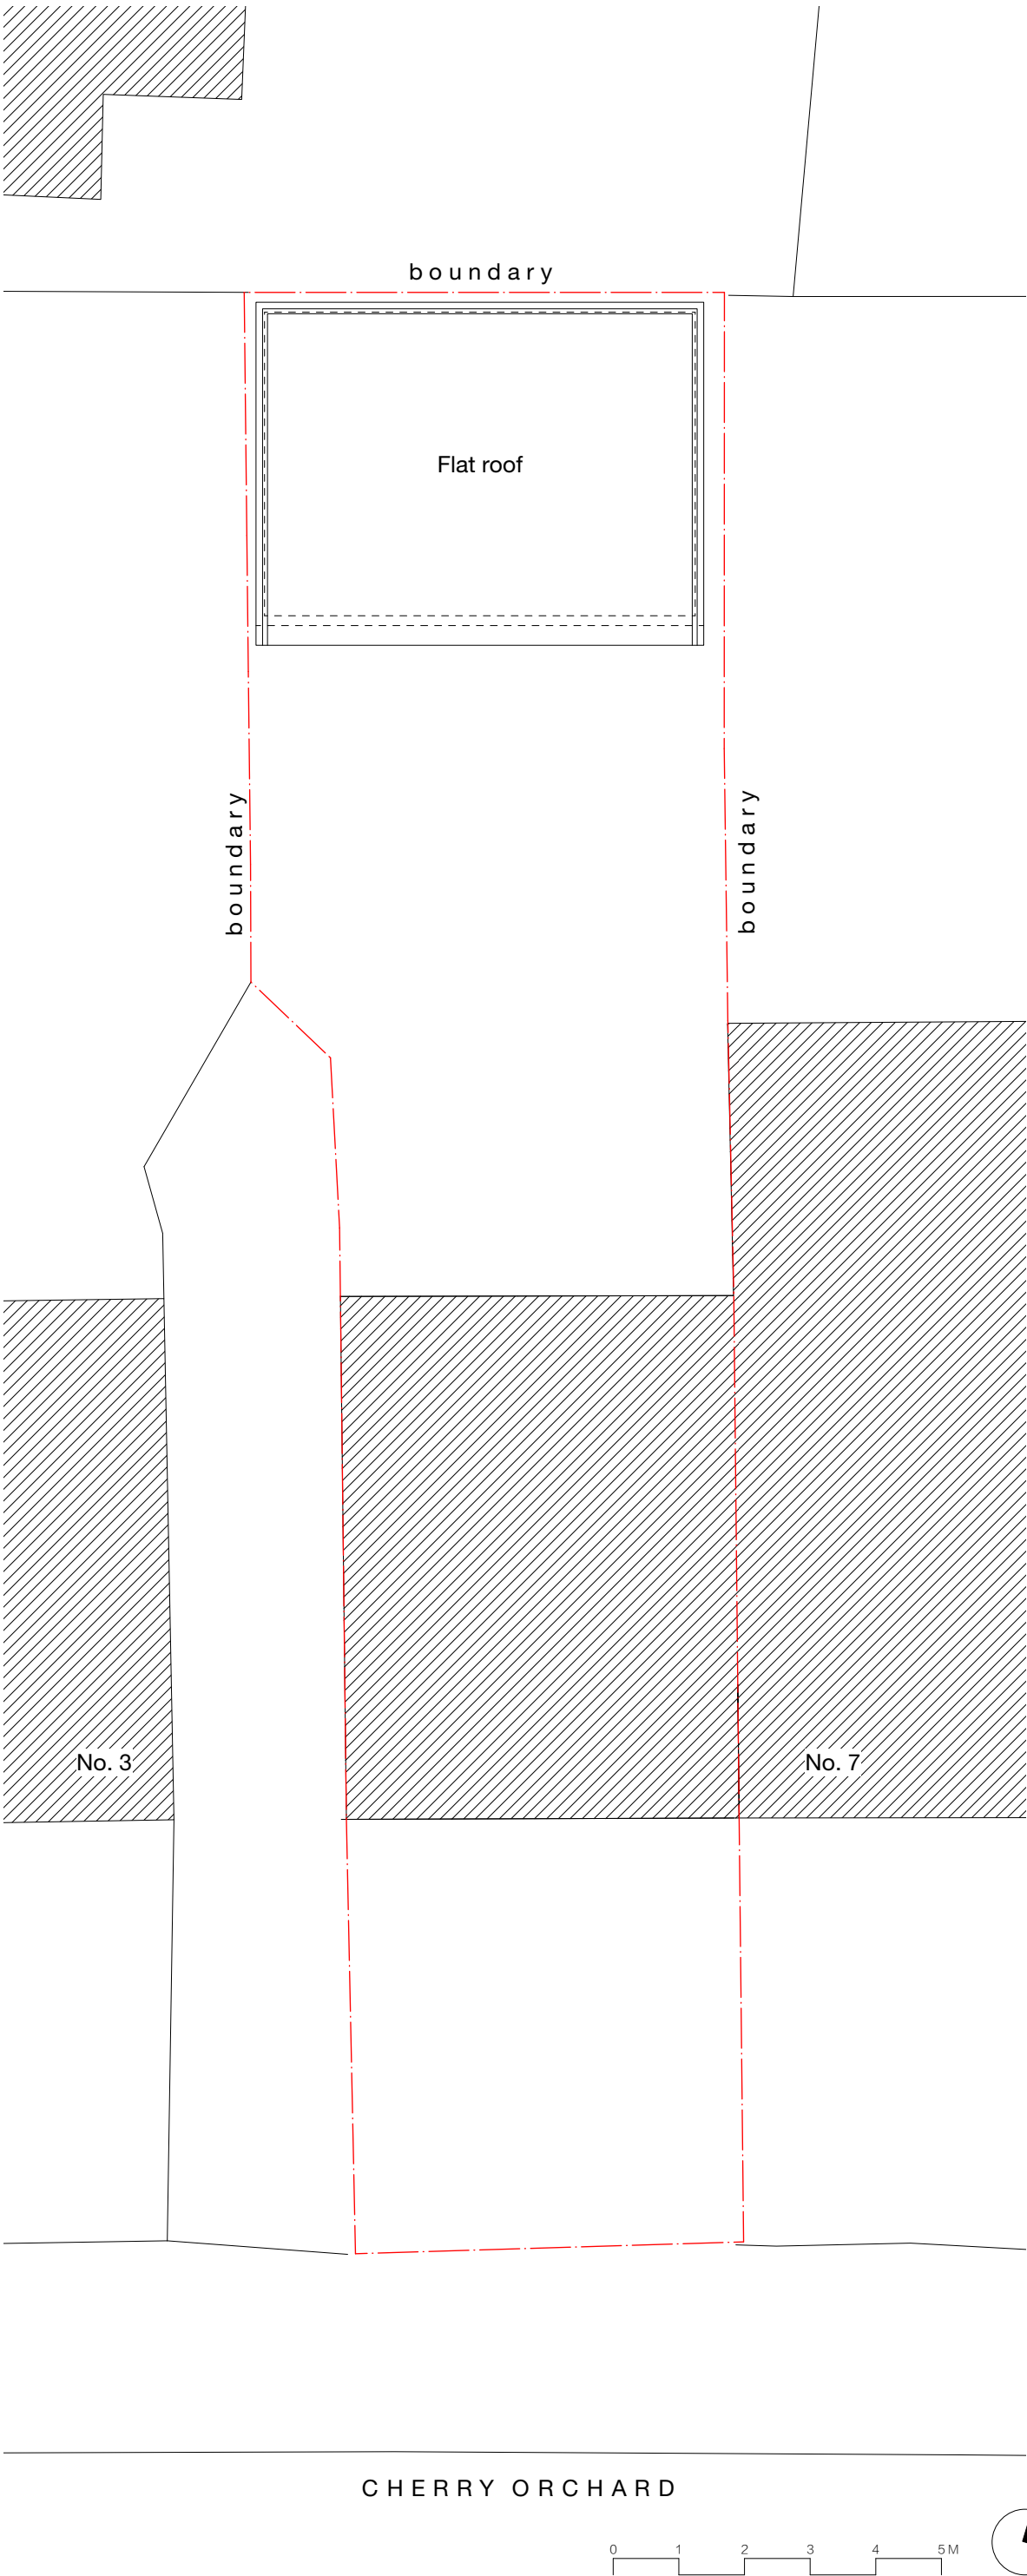

Notes

CH

WH

3421

cill height

window height

ceiling height

Revision notes

client

Shiv Aum Properties Ltd

project

5 Cherry Orchard, West Drayton UB7 7JR

drawing

EXISTING ROOF PLAN

date

Sep. 2021

work stage

1

scale

1:100 at A3

drawing no

S03

project no

2021.056

revision

-

MASONWOOD


DESIGN

www.masonwoodgroup.co.uk


gc@masonwoodgroup.co.uk

+44 7498 589399

AS BUILT

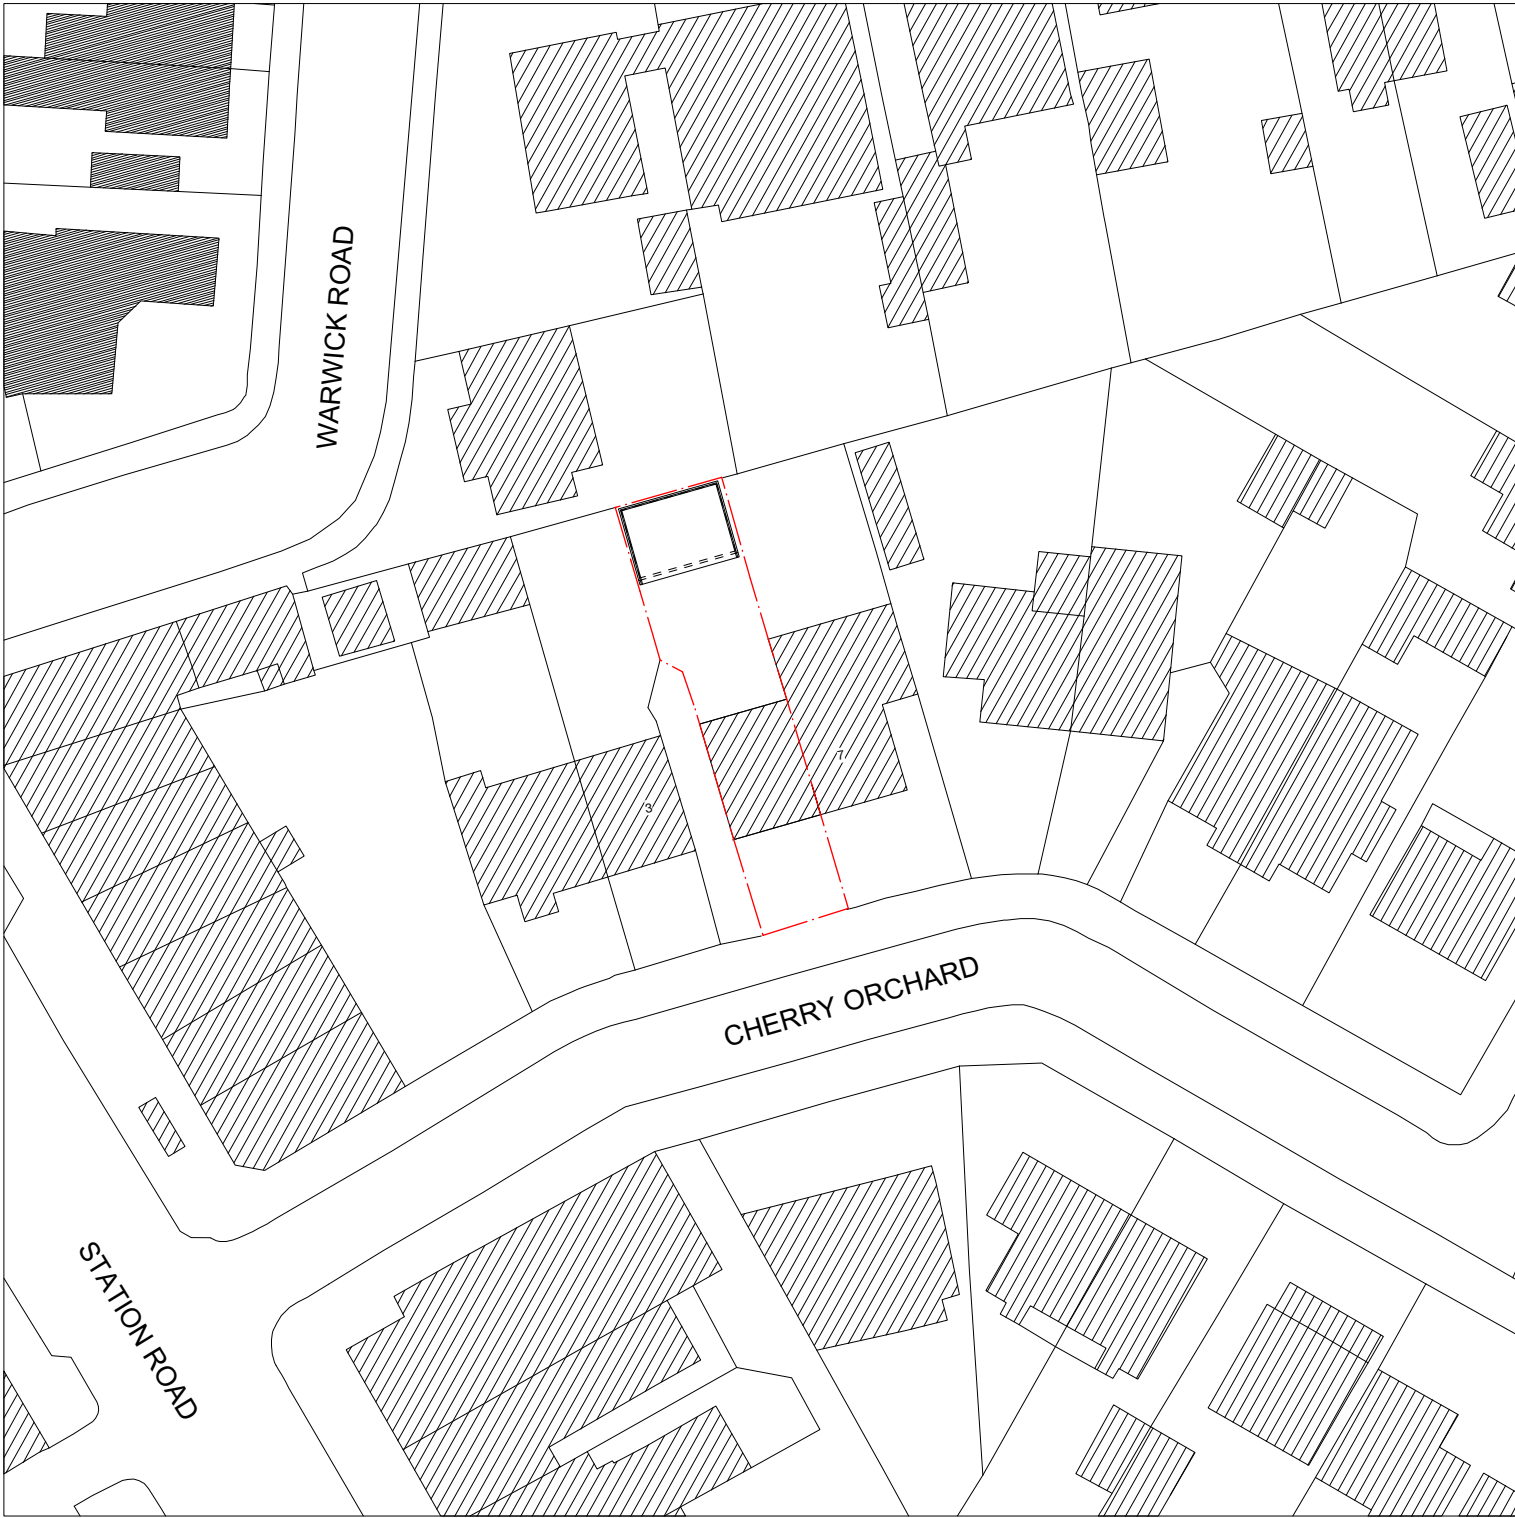

-	-	-	-	-
Revision notes				

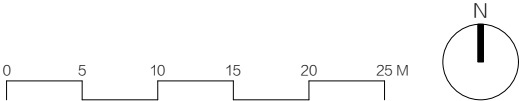



www.masonwoodgroup.co.uk
gc@masonwoodgroup.co.uk
+44 7498 589399

client
Shiv Aum Properties Ltd

project
5 Cherry Orchard, West Drayton UB7 7JR

drawing
EXISTING SITE PLAN

date Sep. 2021	scale 1:500 at A3	project no 2021.056
work stage 1	drawing no S04	revision -

Dotted line indicates 2.5m height permissible under lawful development

Dotted line indicates 2.5m height permissible under lawful development

Dotted line indicates 2.5m height permissible under lawful development

NORTH-WEST
Front

SOUTH-WEST
Side

SOUTH-EAST
Rear

NORTH-EAST
Side

-	-	-	-	-
Revision notes				





client
Shiv Aum Properties Ltd

project
5 Cherry Orchard, West Drayton UB7 7JR

drawing
EXISTING ELEVATIONS

date Sep. 2021	scale 1:100 at A3	project no 2021.056
work stage 1	drawing no S05	revision -

www.masonwoodgroup.co.uk
gc@masonwoodgroup.co.uk
+44 7498 589399

AS BUILT