




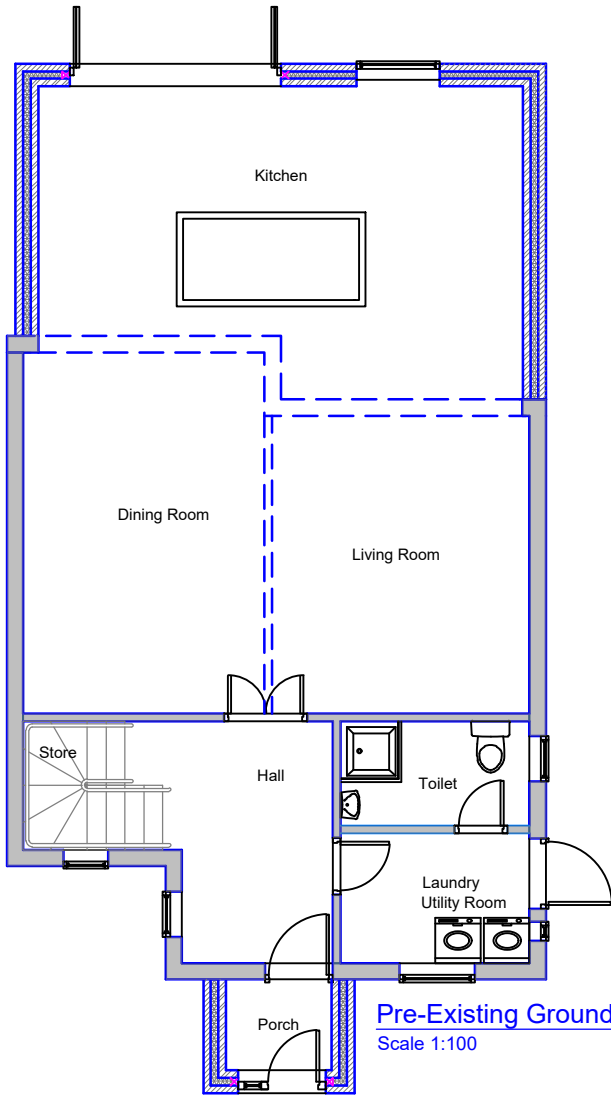


Pre-Existing Ground Floor Plan
Scale 1:100

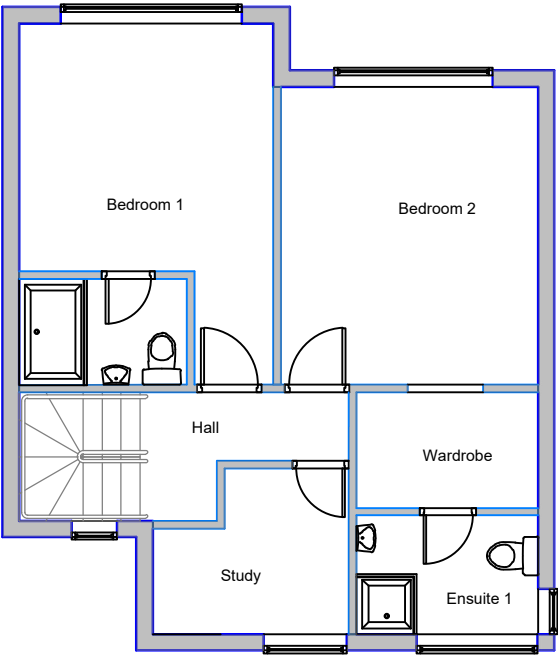


Pre-Existing First Floor Plan
Scale 1:100

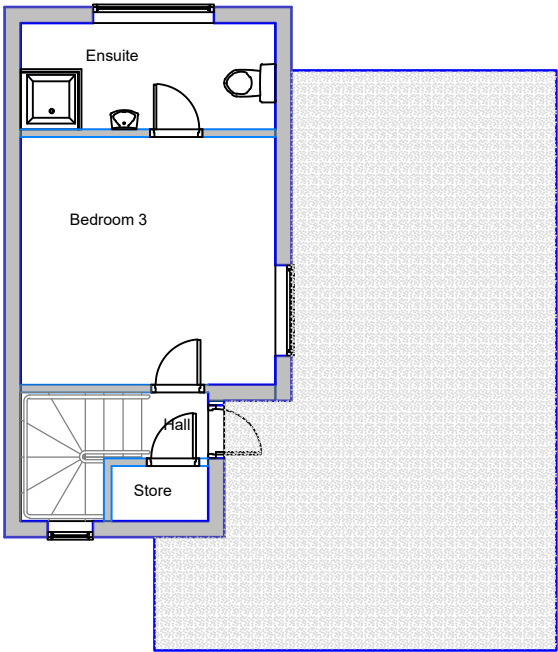


Pre-Existing Roof Plan
Scale 1:100

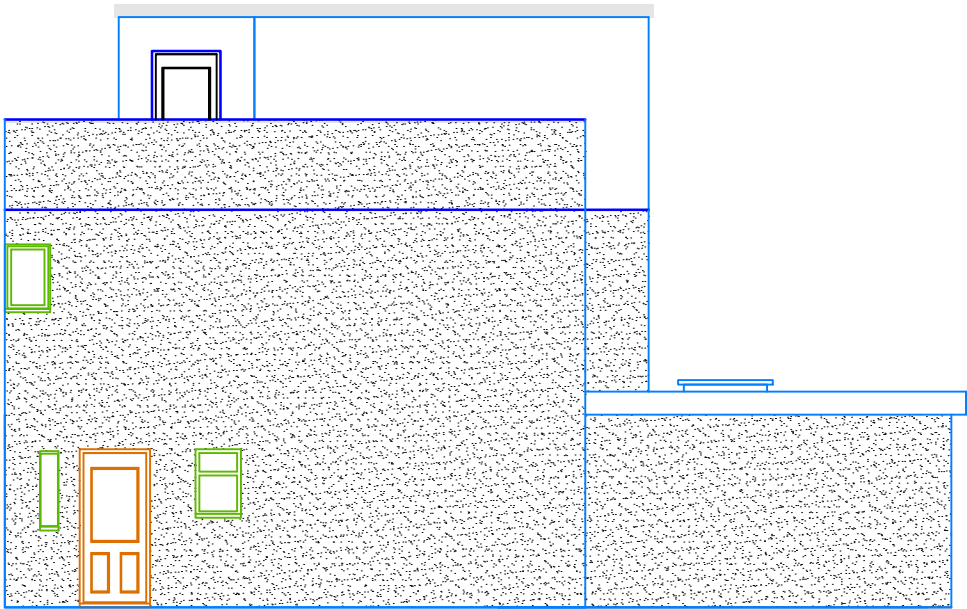


Pre-Existing Side Elevation
Scale 1:100

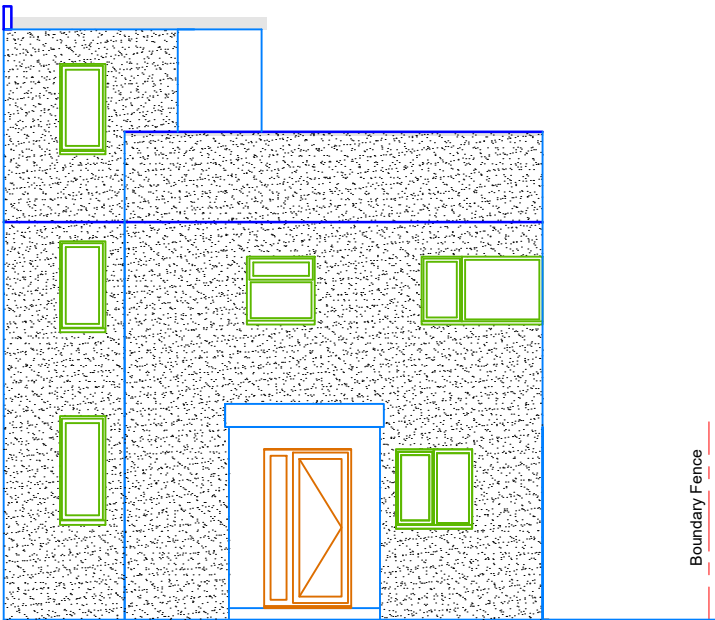

Pre-Existing Front Elevation
Scale 1:100

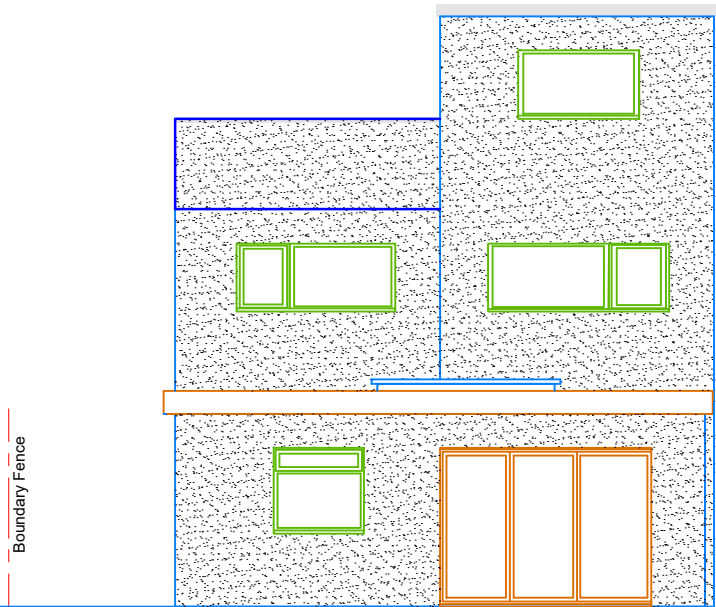




Pre-Existing Rear Elevation
Scale 1:100

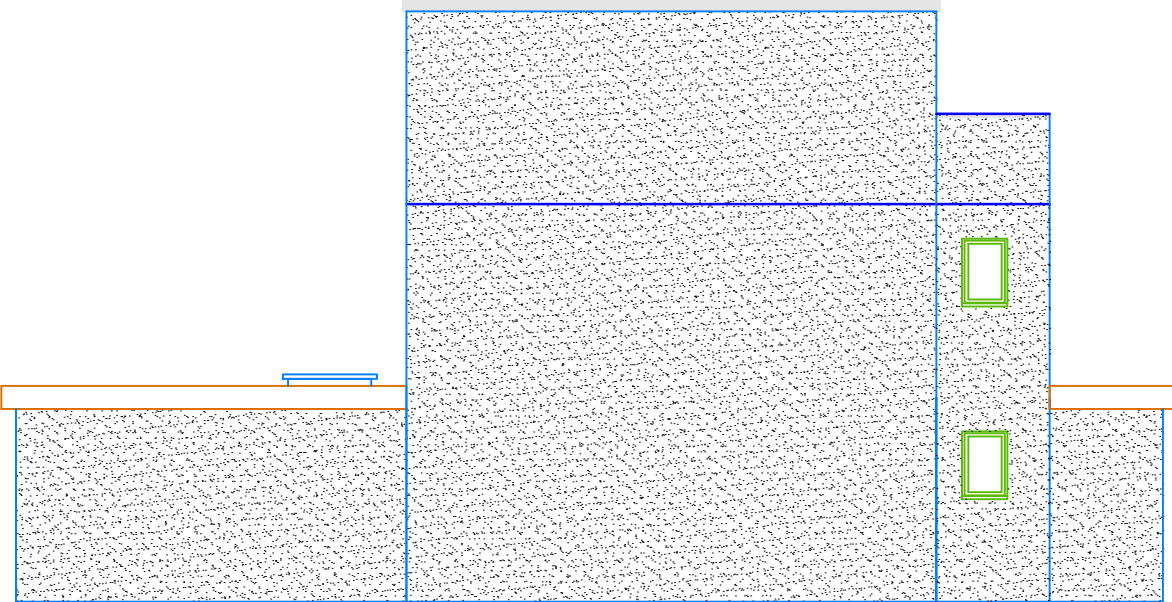

Pre-Existing Side Elevation
Scale 1:100

Pre-Existing Floor Plans & Elevations

Site Address 23 Norwich Road Northwood HA6 1ND	Scale: 1:100@A3		Revision Date:	
	Date: June. 2022		A	OCT. 2022
	Drawing No.: NB-02			
	Drawn By:			

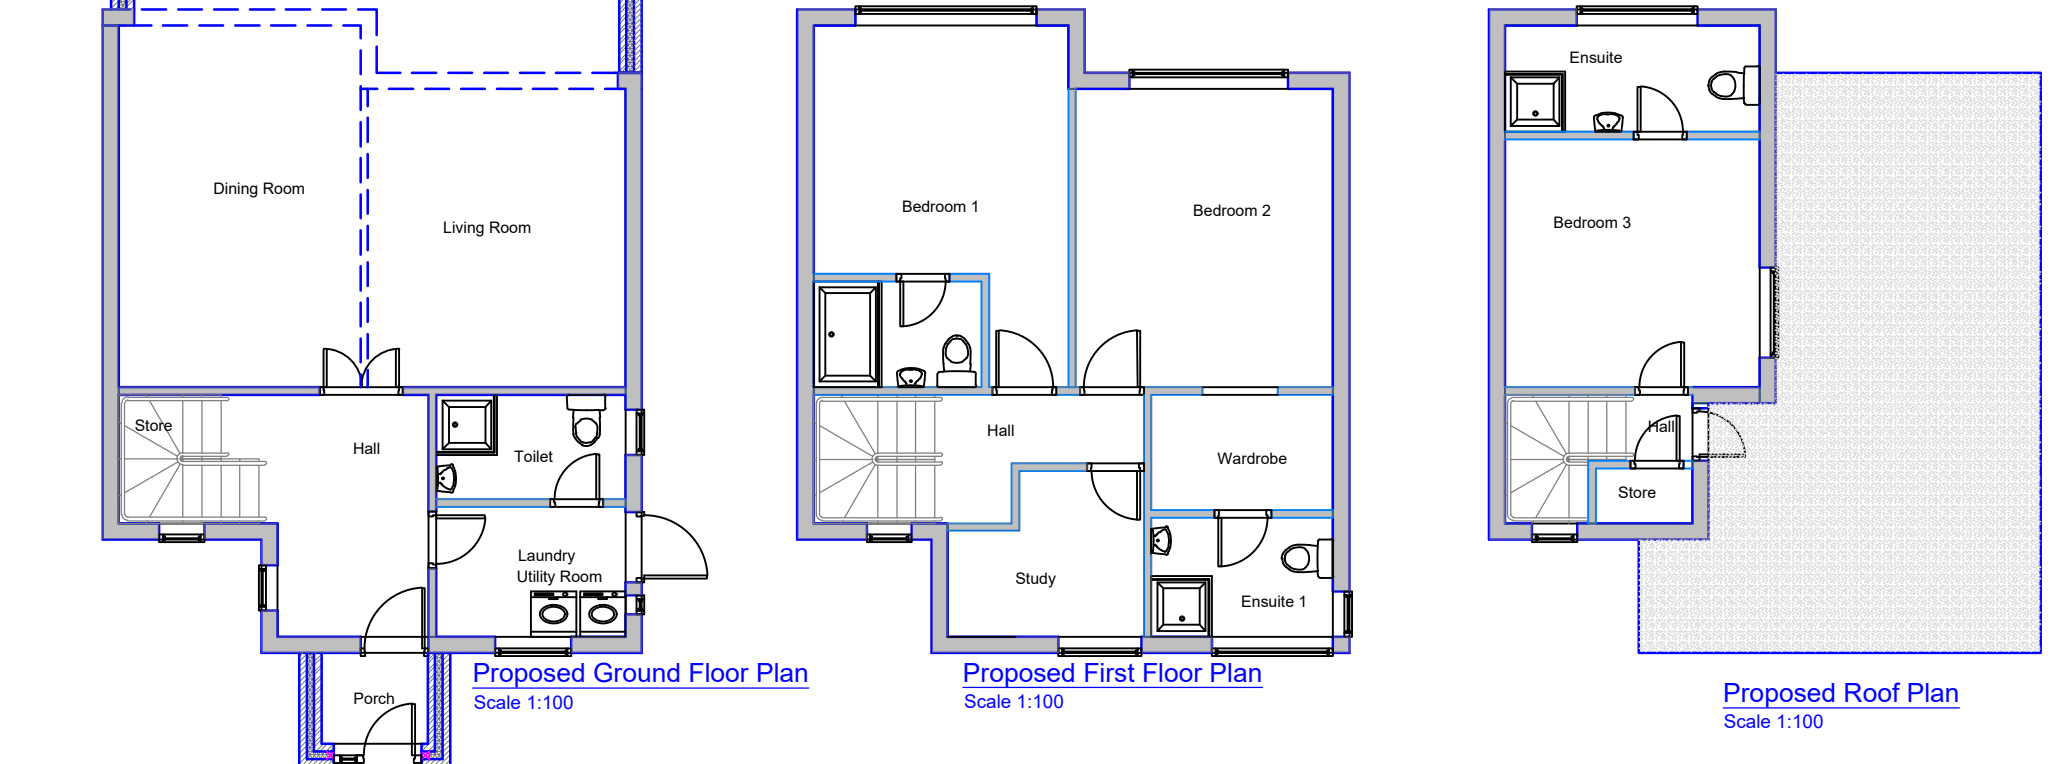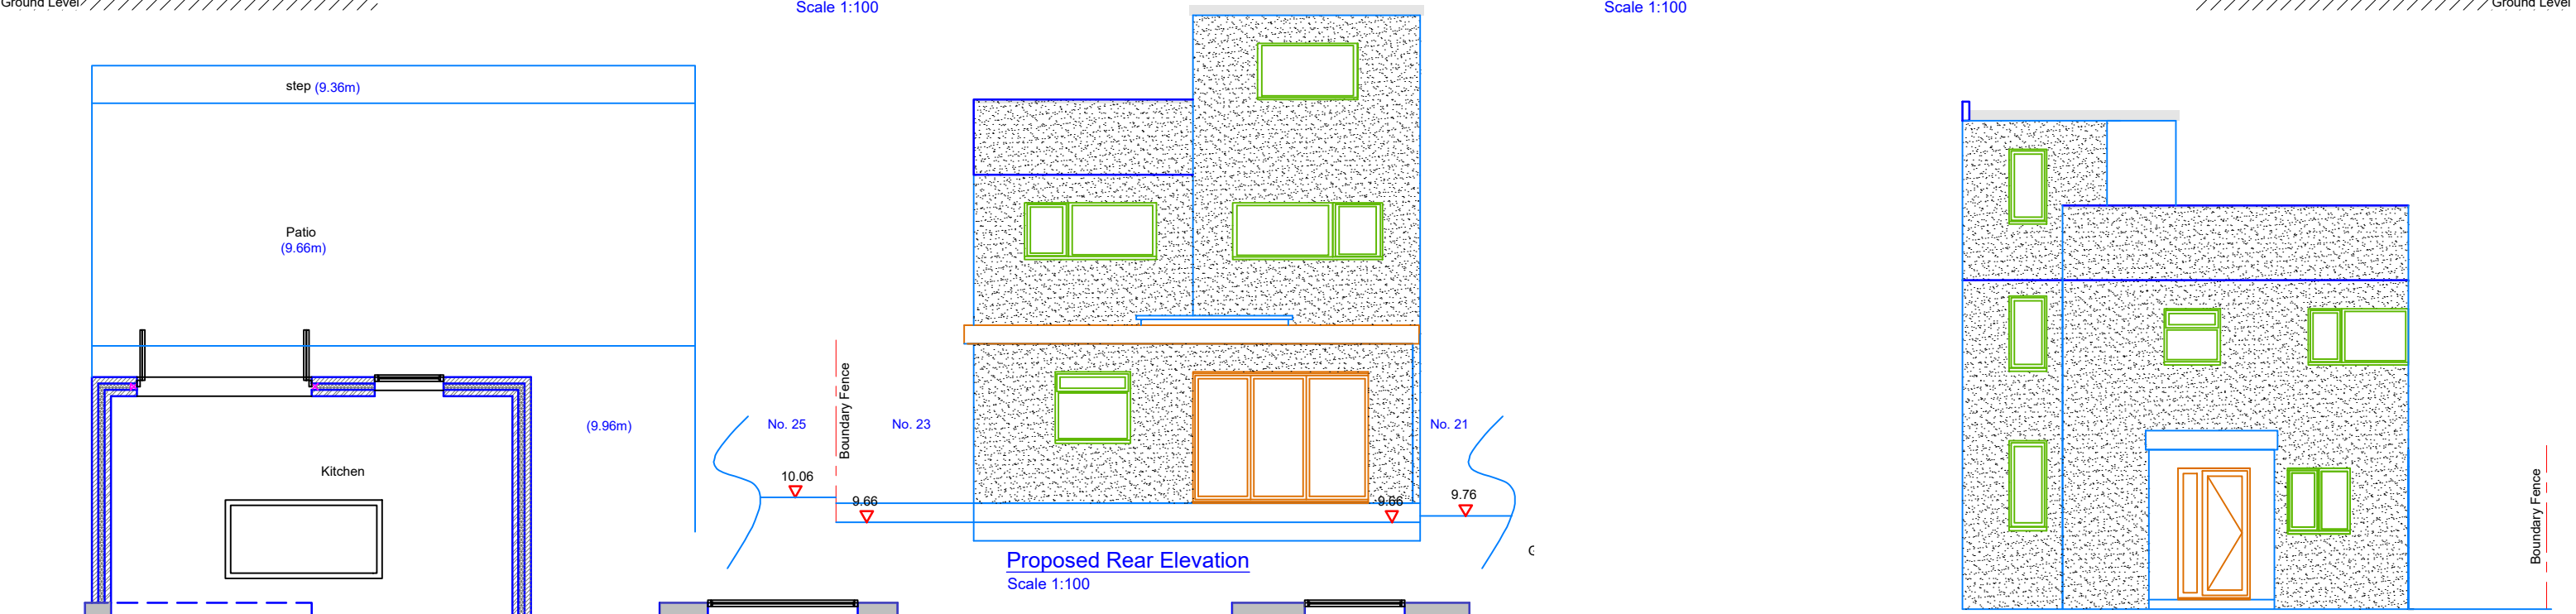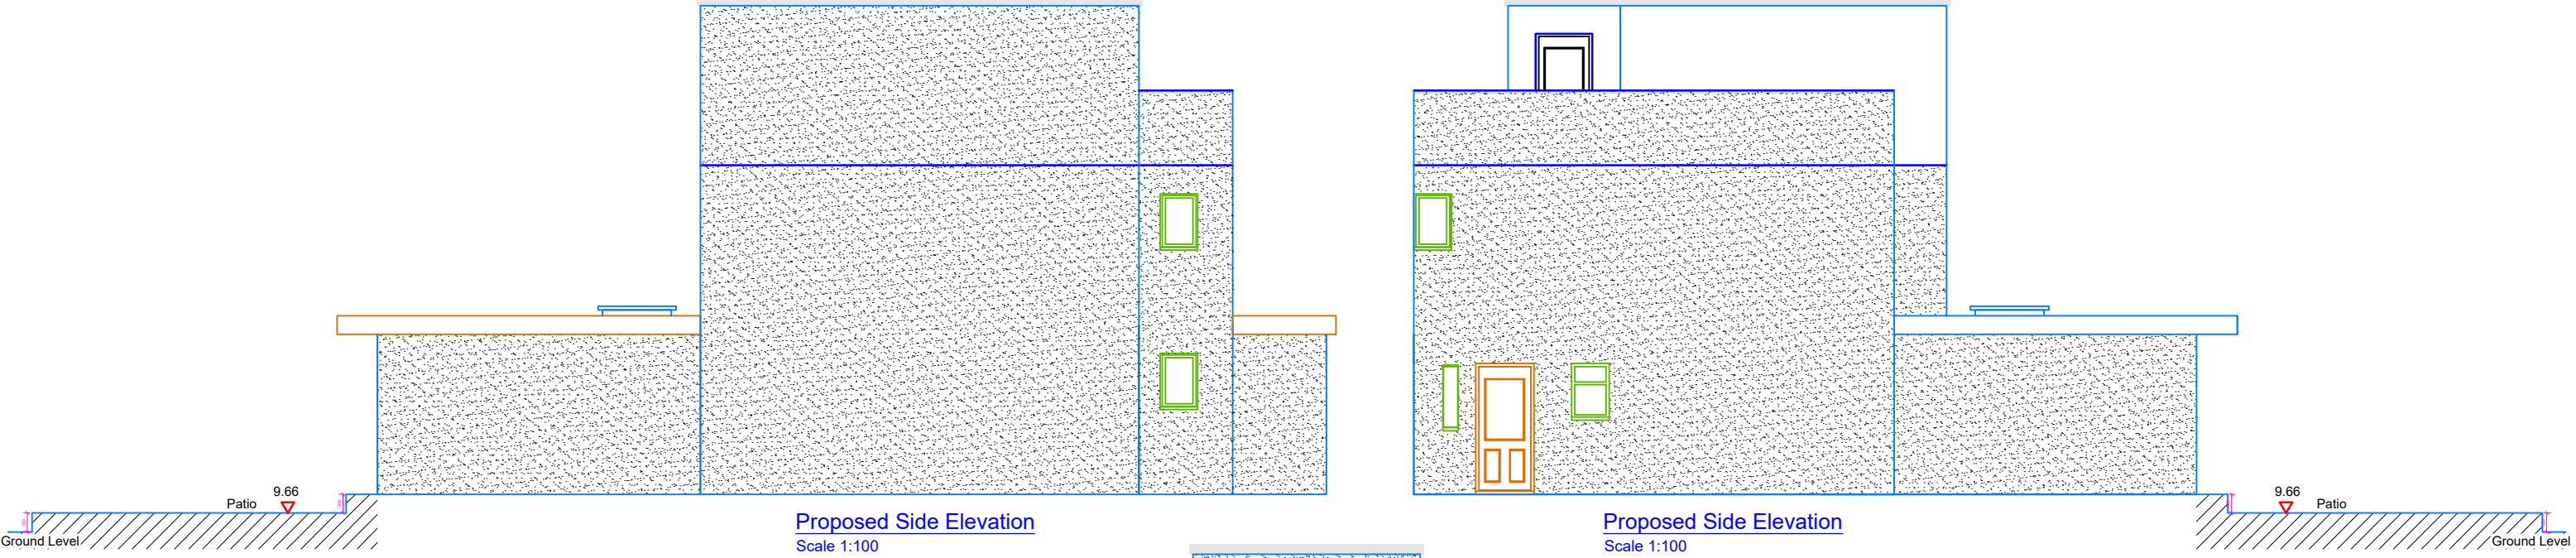

Proposed Front Elevation
Scale 1:100



As-Built Floor Plans & Elevations

Site Address 23 Norwich Road Northwood HA6 1ND	Scale: 1:100@A3		Revision Date:	
	Date: June. 2022		A	OCT. 2022
	Drawing No.: NB-03		B	OCT. 2022
	Drawn By:			