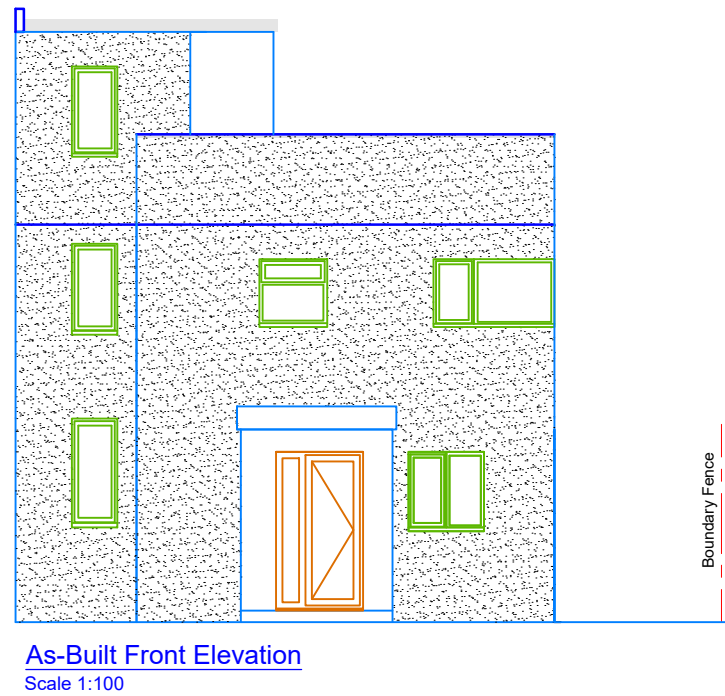
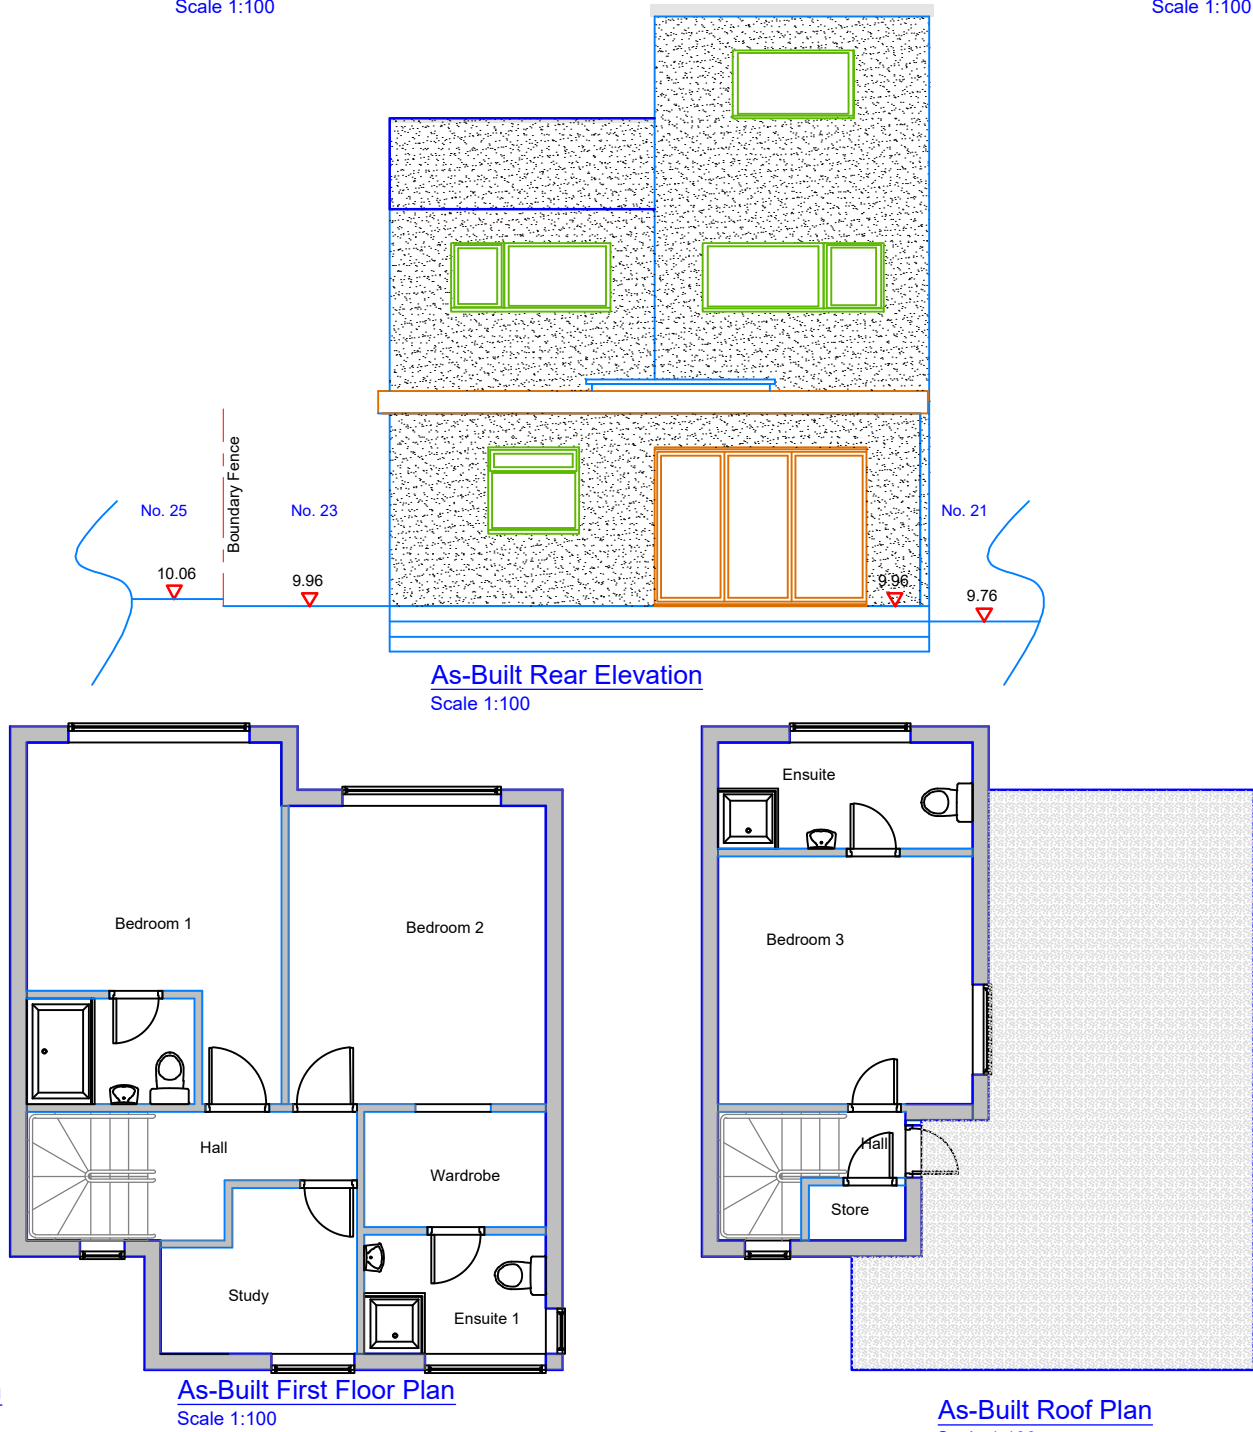
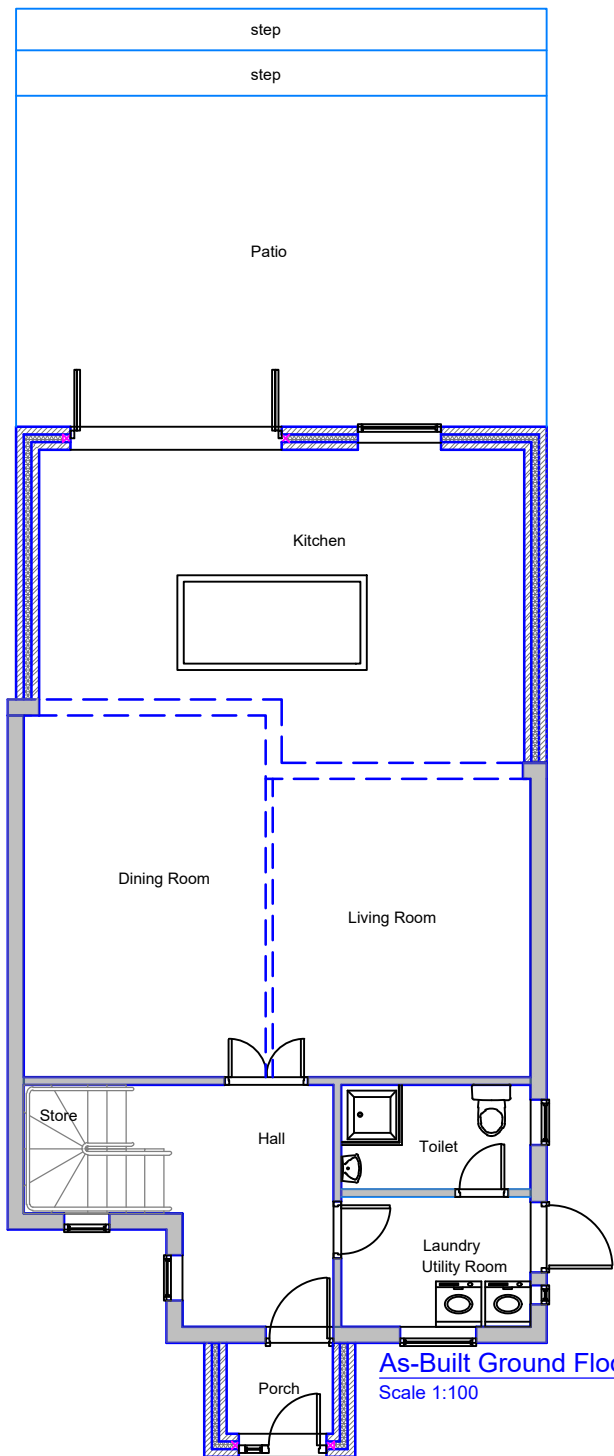
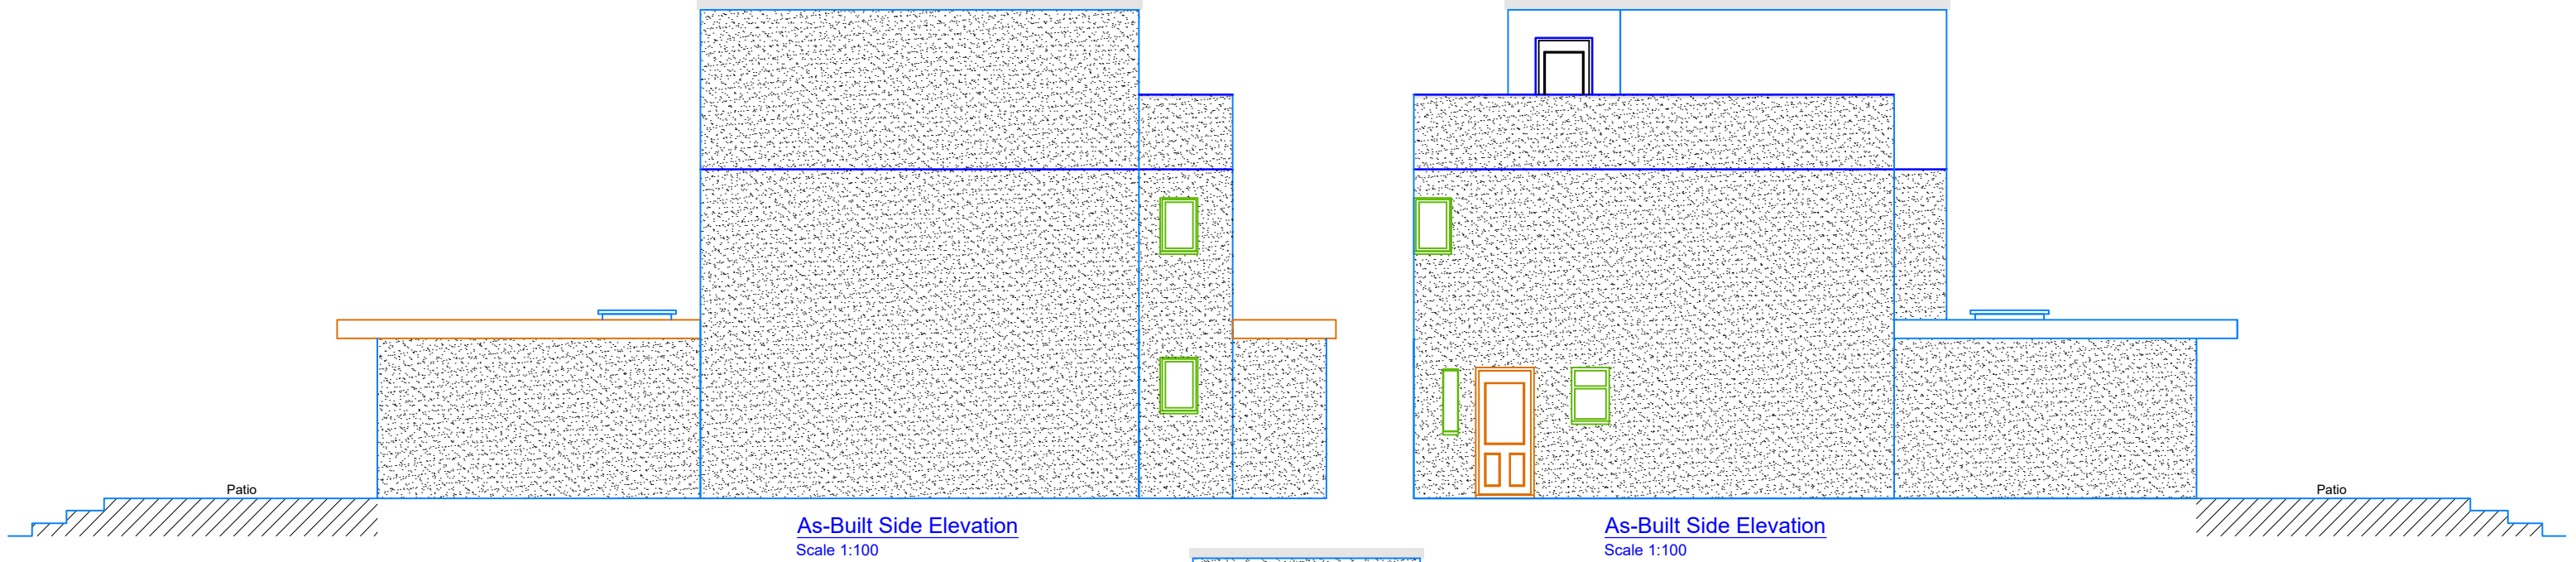


As-Built Floor Plans & Elevations

Site Address 23 Norwich Road Northwood HA6 1ND	Scale: 1:100@A3		Revision Date:	
	Date: June. 2022		A	Sep. 22
	Drawing No.: NB-03			
	Drawn By:			