




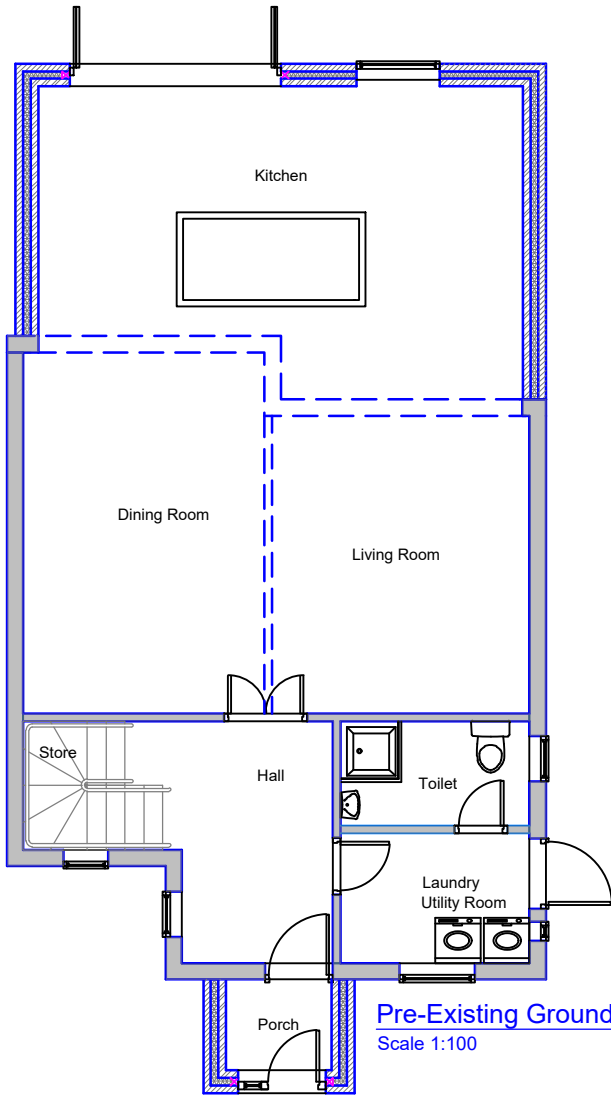


Pre-Existing Ground Floor Plan
Scale 1:100

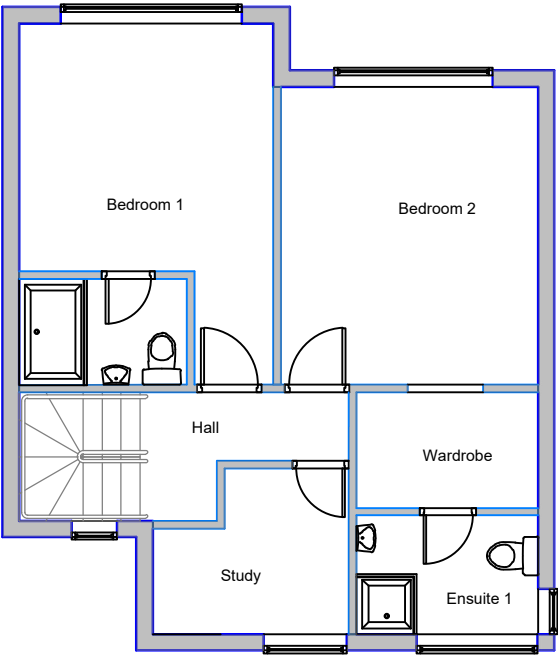


Pre-Existing First Floor Plan
Scale 1:100

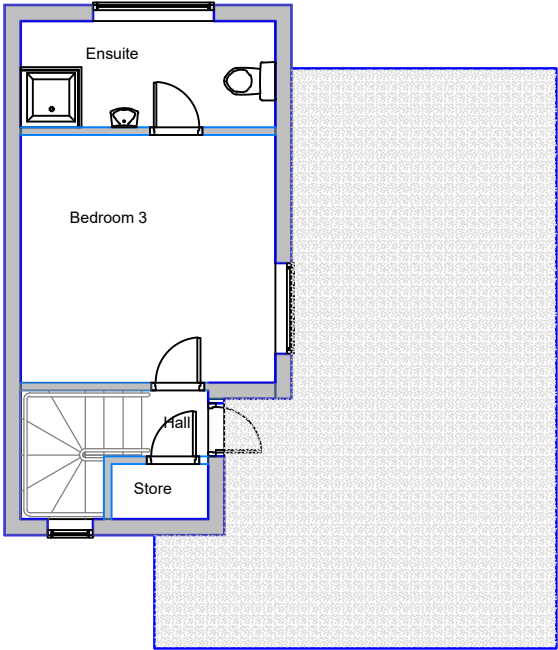


Pre-Existing Roof Plan
Scale 1:100

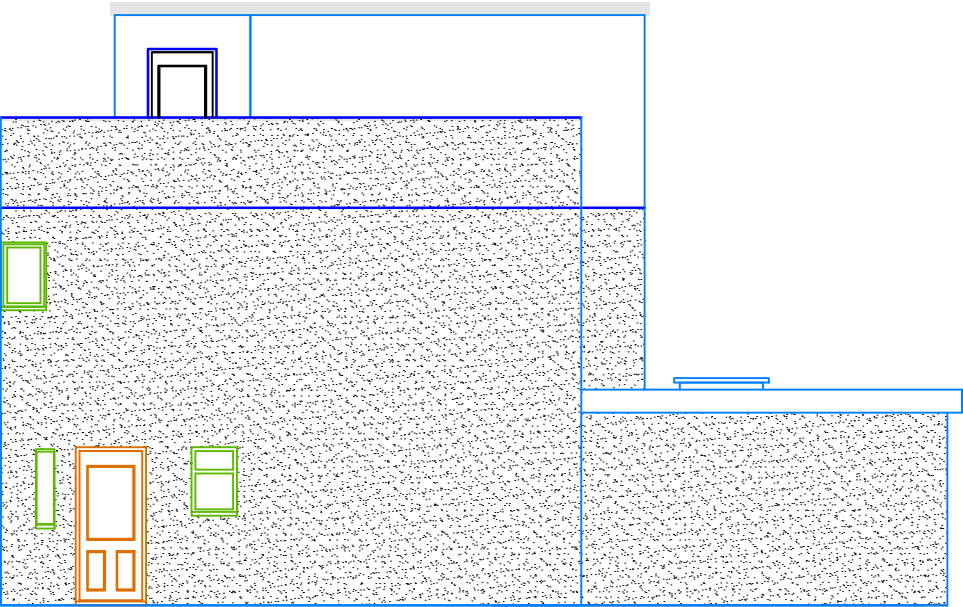


Pre-Existing Side Elevation
Scale 1:100

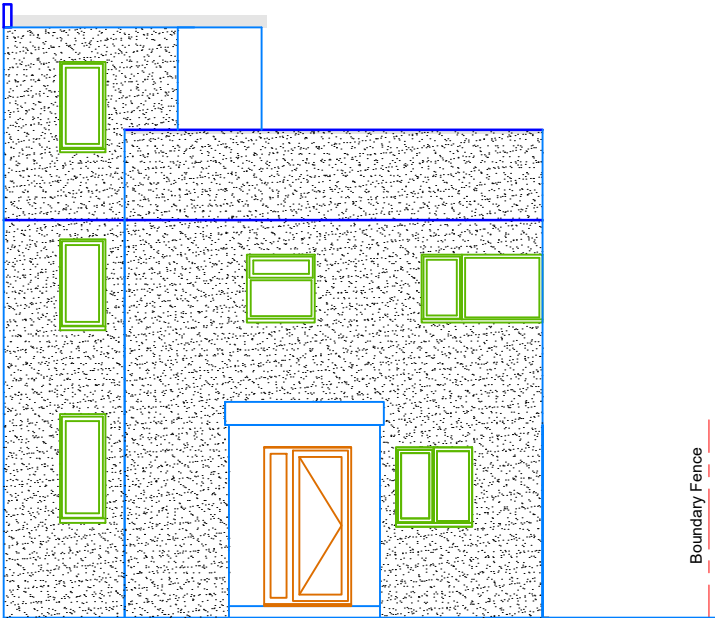

Pre-Existing Front Elevation
Scale 1:100

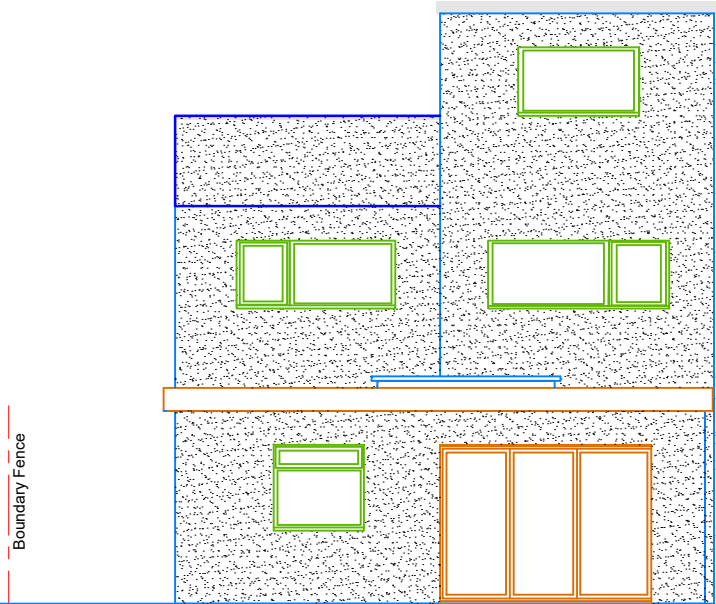


Pre-Existing Rear Elevation
Scale 1:100

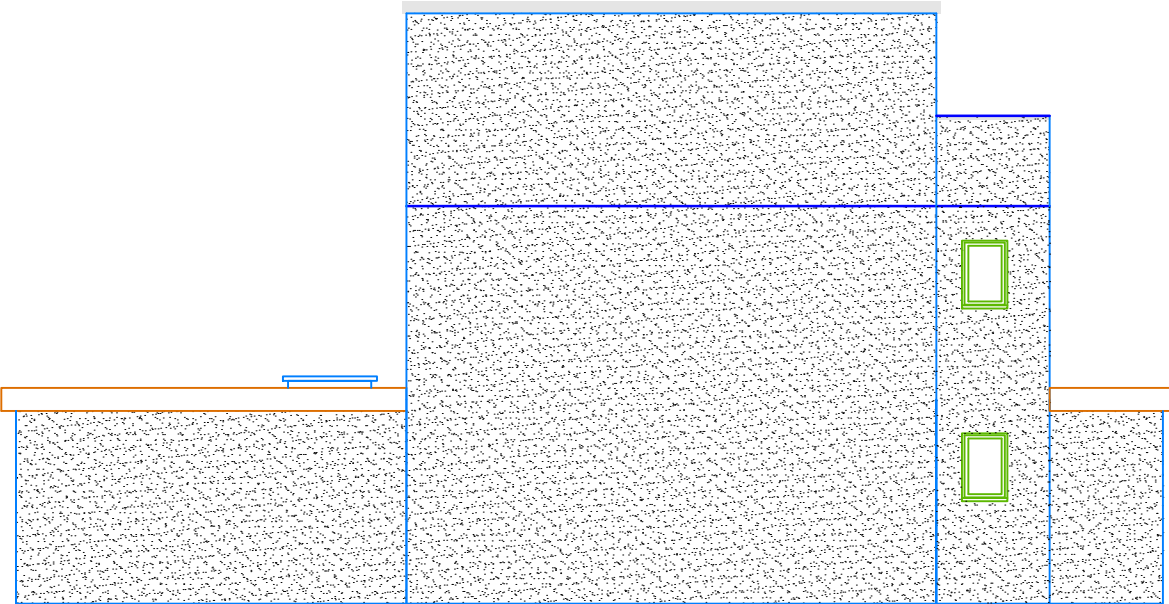


Pre-Existing Side Elevation
Scale 1:100

Pre-Existing Floor Plans & Elevations


Site Address	Scale: 1:100@A3	Revision Date:
23 Norwich Road	Date: June. 2022	
Northwood	Drawing No.: NB-02	
HA6 1ND	Drawn By:	

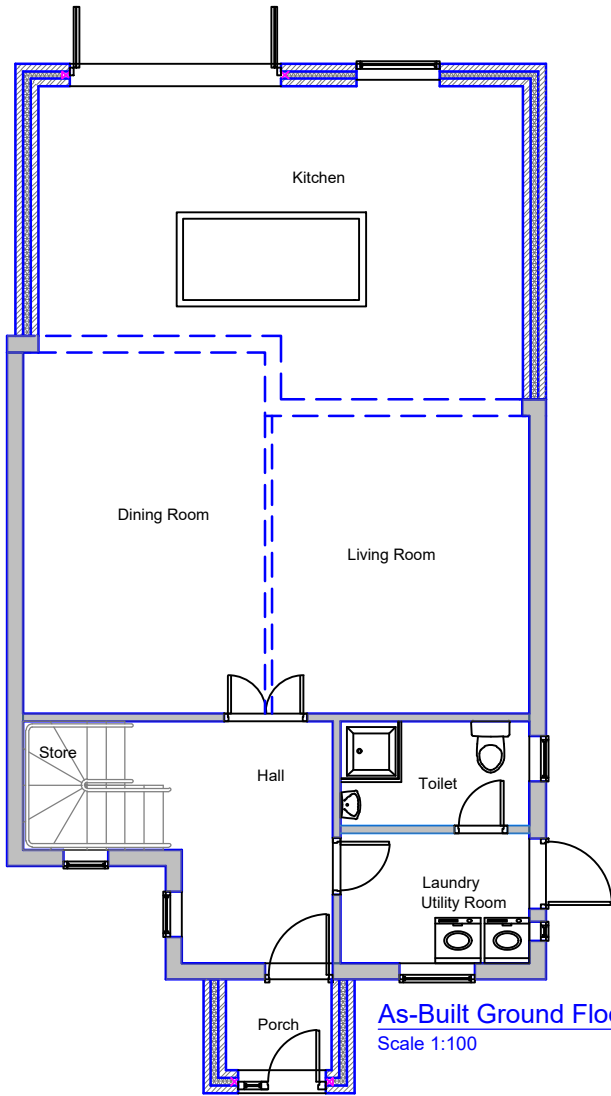


As-Built Ground Floor Plan
Scale 1:100

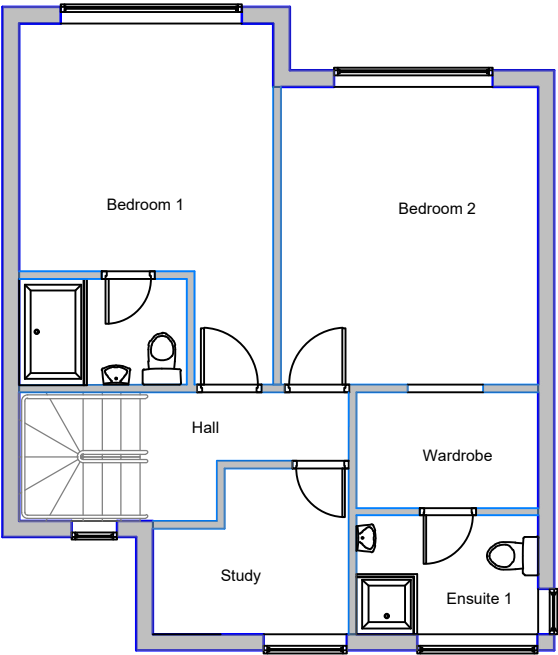


As-Built First Floor Plan
Scale 1:100

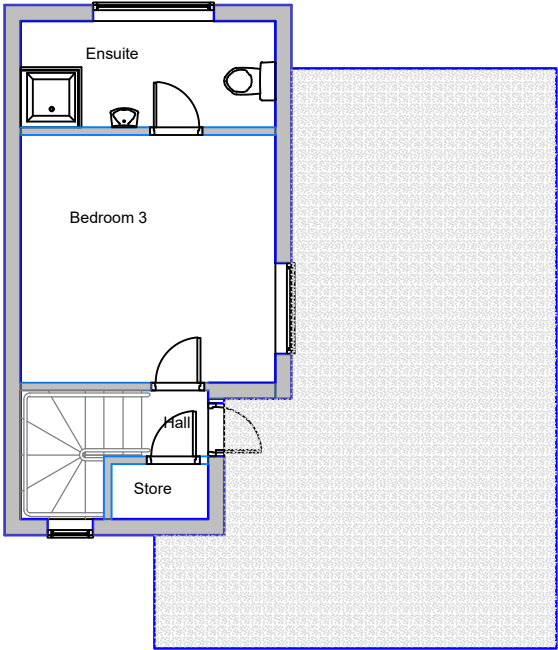


As-Built Roof Plan
Scale 1:100

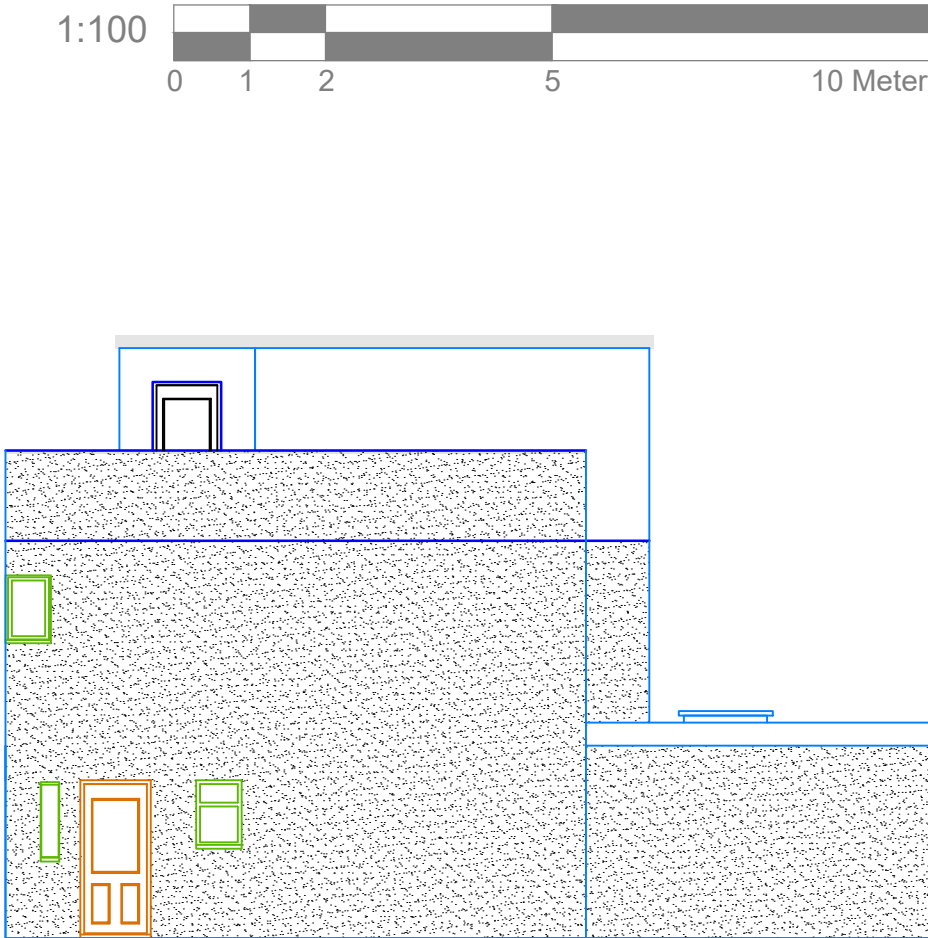


As-Built Side Elevation
Scale 1:100

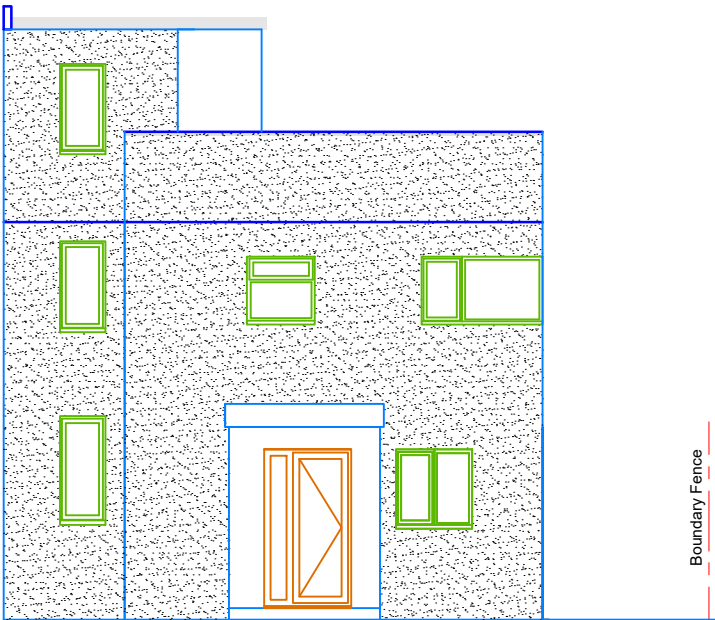

As-Built Front Elevation
Scale 1:100

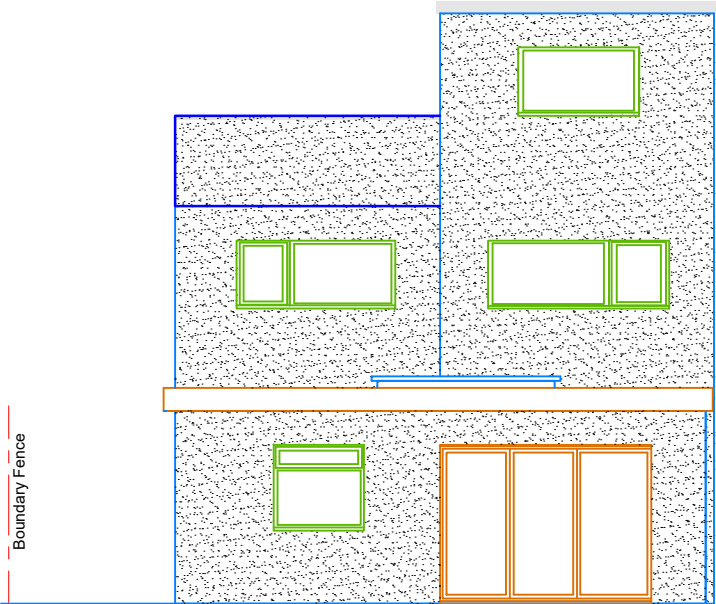

As-Built Rear Elevation
Scale 1:100

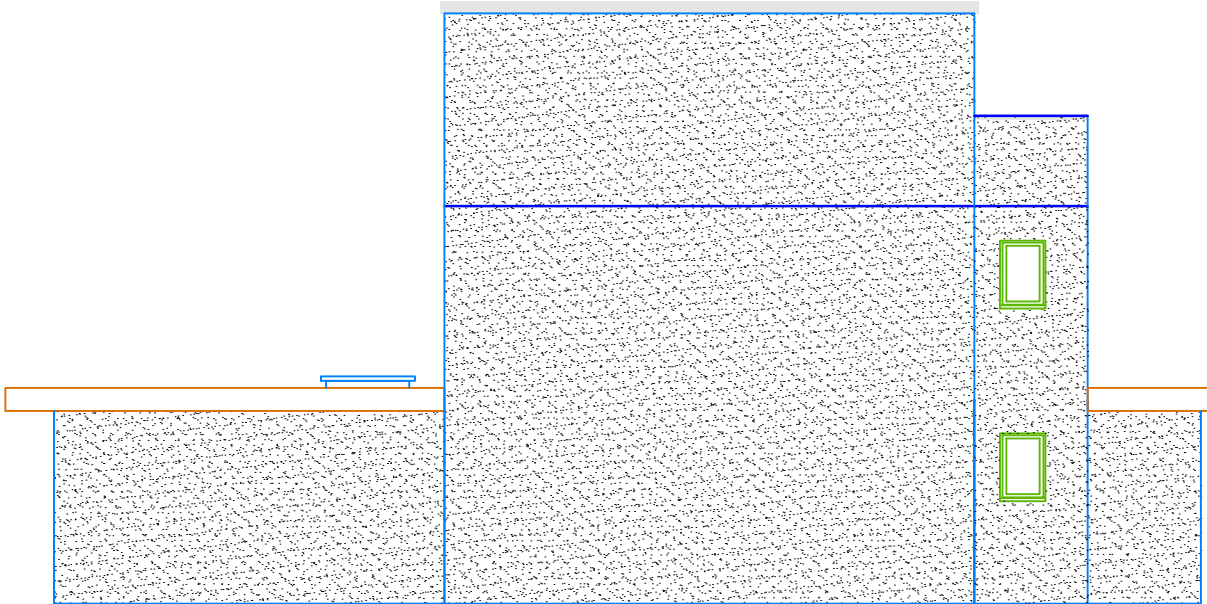

As-Built Side Elevation
Scale 1:100

As-Built Floor Plans & Elevations

Site Address	Scale: 1:100@A3	Revision Date:
23 Norwich Road	Date: June. 2022	
Northwood	Drawing No.: NB-03	
HA6 1ND	Drawn By:	