


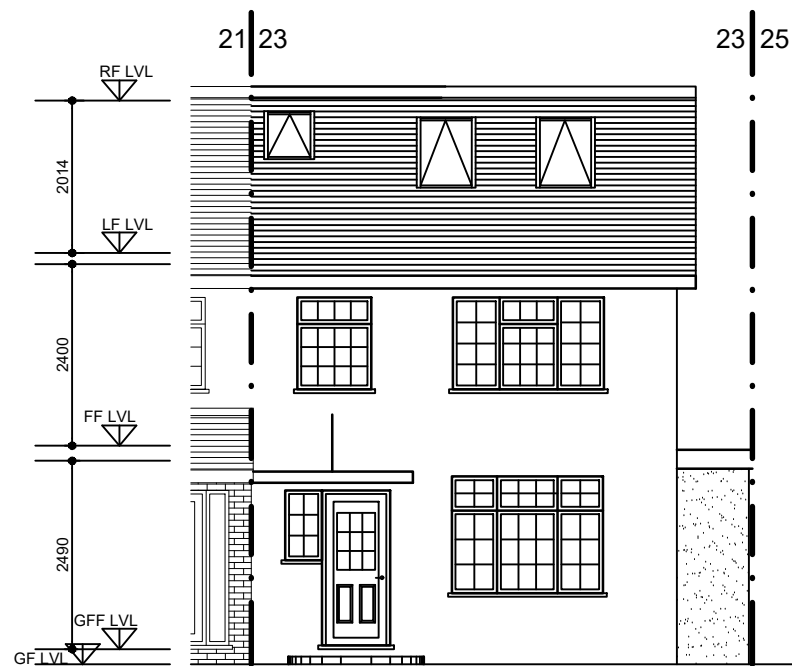


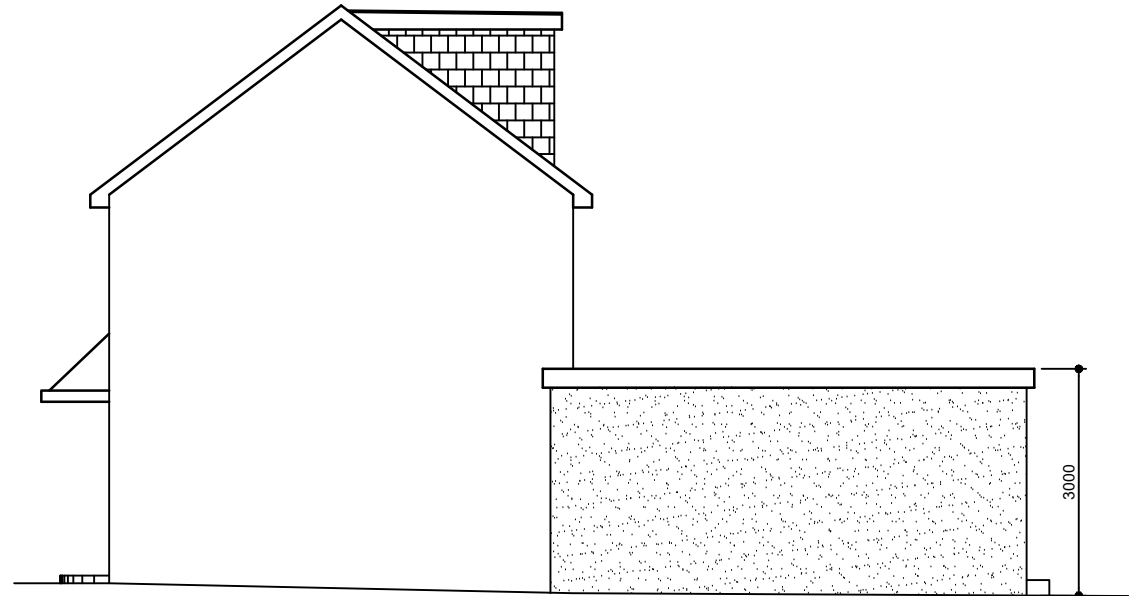


FRONT ELEVATION  
PROPOSED ( As-Built)

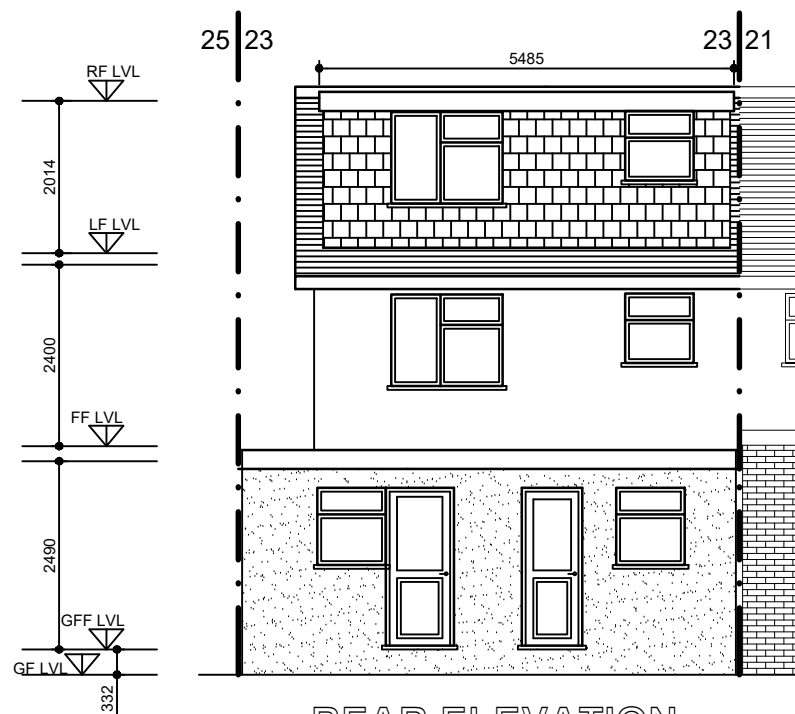

SIDE ELEVATION PROPOSED ( As-Built)  
(AS VIEWED FROM NO.25)

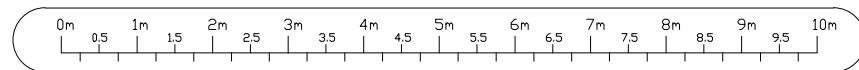

REAR ELEVATION  
PROPOSED ( As-Built)

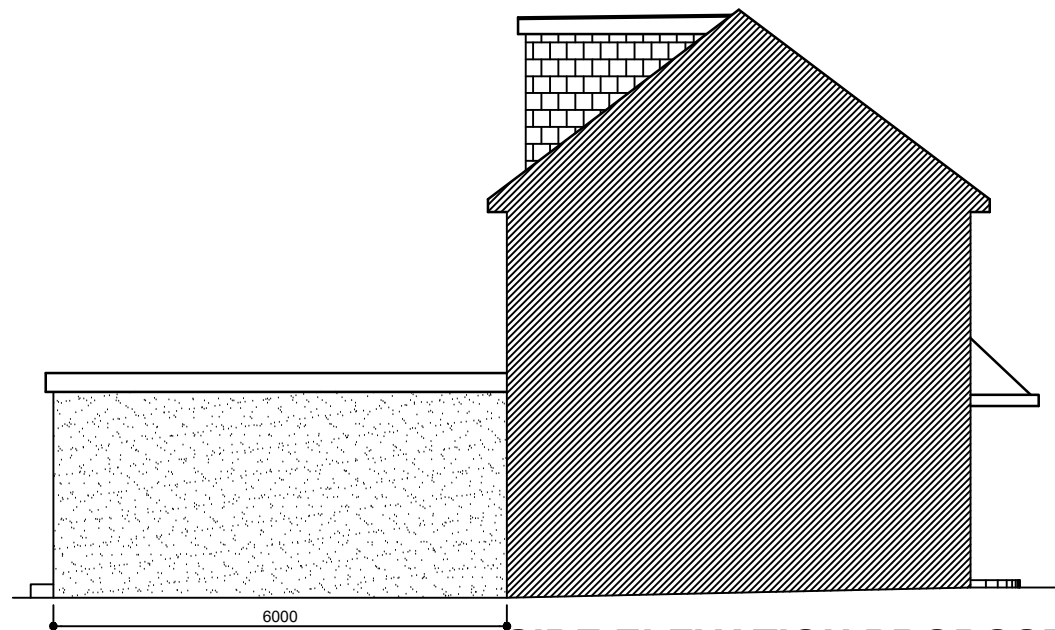

SIDE ELEVATION PROPOSED ( As-Built)  
(AS VIEWED FROM NO.21)

**ICREATE** ©  
DESIGN LIMITED

Planning & Designing of All Types of Building Works  
1CRABTREE CLOSE, BUSHEY, WD23 3BJ  
Tel: 07886759400 ; EM: ikreated@gmail.com

| REV | DATES      | COMMENTS                 |
|-----|------------|--------------------------|
|     | 07.01.2025 | FOR PLANNING APPLICATION |

CLIENT  
MR. A GILL  
23 MINTERN WAY  
HAYES  
UB4 0PD

PROJECT/TITLE  
RETENTION OF AS-BUILT SINGLE  
STOREY SIDE TO REAR EXTENSION.

SCALE:  
1:100@A3

DRG NO :  
23MINTERNWAY-004