


SOAKWAYS attenuated crates


To be designed for 1m3 for every 16m2 of roof serving it.
Not less than 5 m. from buildings. Depth 600 mm below invertlevel of drains.
Use modular attenuation cells of lightweight plastic structure with a high void ratio.
Beneath the unit & on all sides provide 100mm of gravel and on top 500mm cover including 100mm gravel layer.
Size of the hole to be 1600mm deep and 1200mm sq.

Pipe to 100mm dia. and 1: 40 fall.
Where the pipe enters the soakaway it should be surrounded by gravel.

All to meet building inspectors approval on site.

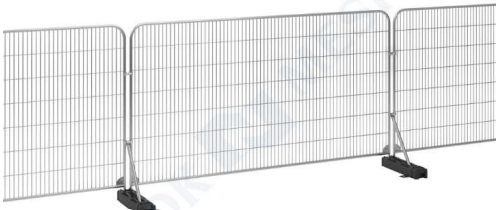


SITE FENCING

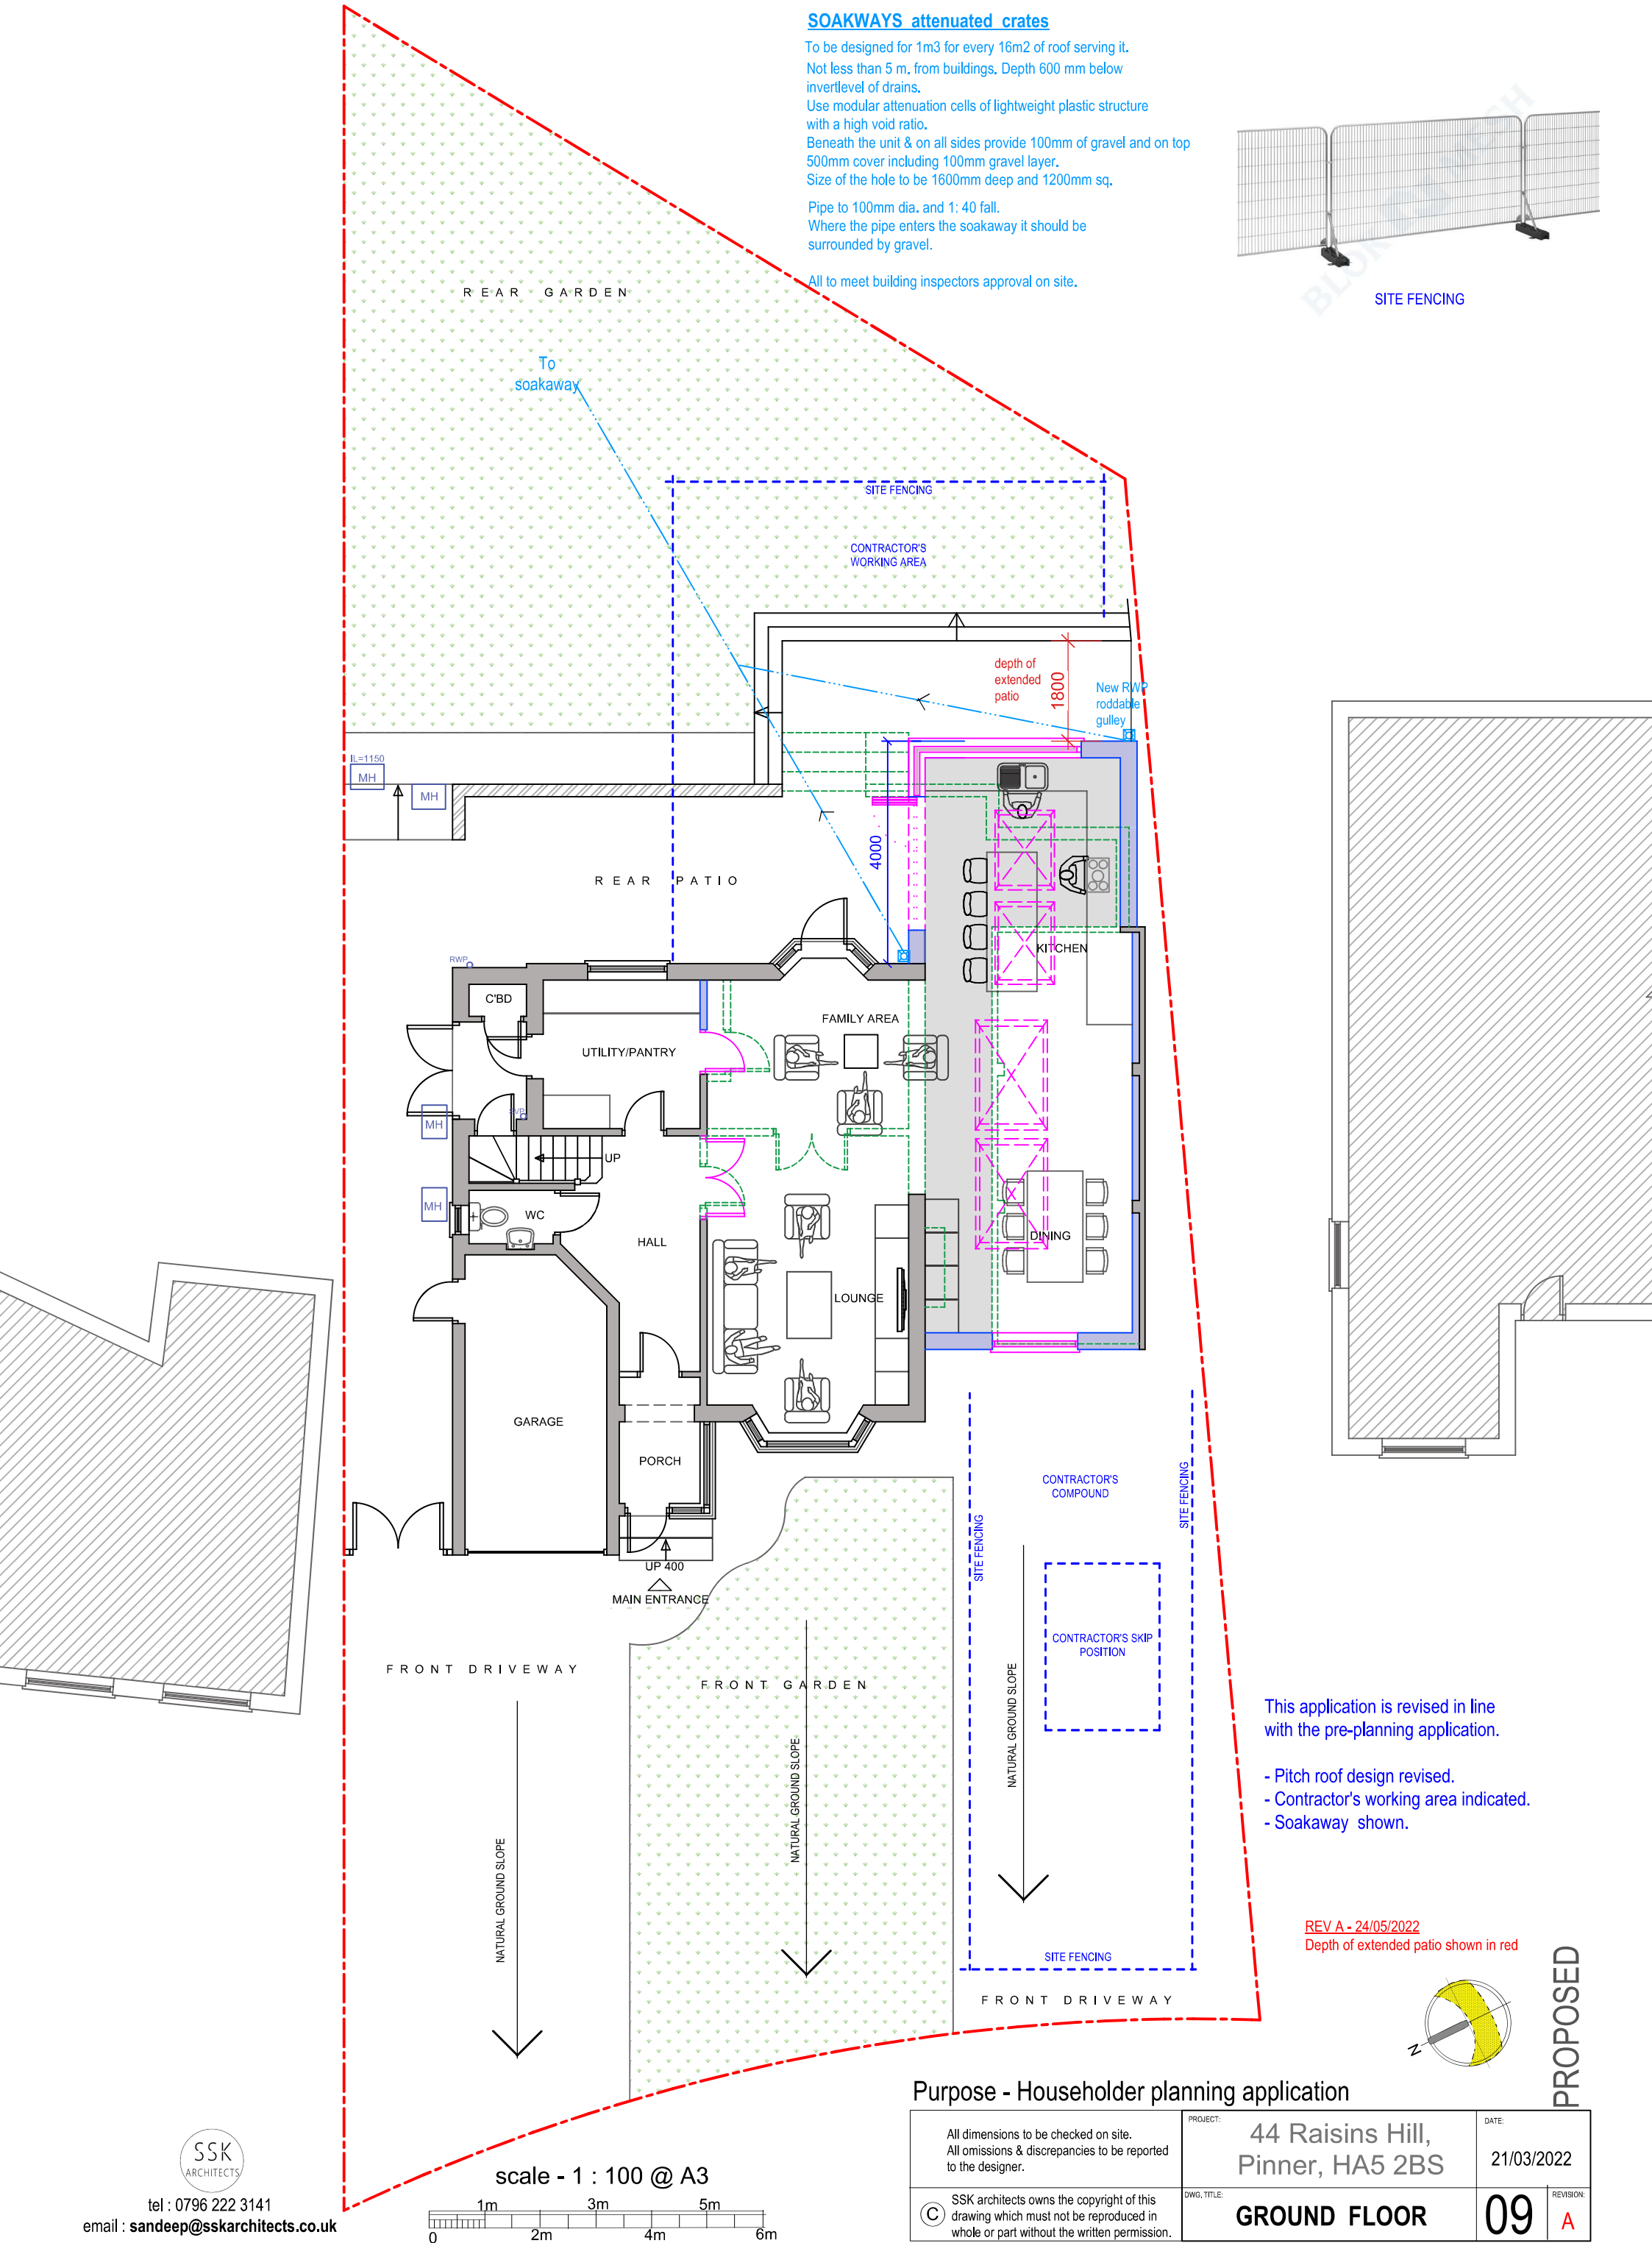

This application is revised in line with the pre-planning application.

- Pitch roof design revised.
- Contractor's working area indicated.
- Soakaway shown.

REV A - 24/05/2022
Depth of extended patio shown in red

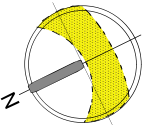

PROPOSED

Purpose - Householder planning application

All dimensions to be checked on site. All omissions & discrepancies to be reported to the designer.	PROJECT: 44 Raisins Hill, Pinner, HA5 2BS	DATE: 21/03/2022
	DWG. TITLE: GROUND FLOOR	REVISION: 09 A



tel : 0796 222 3141
email : sandeep@sskarchitects.co.uk

