



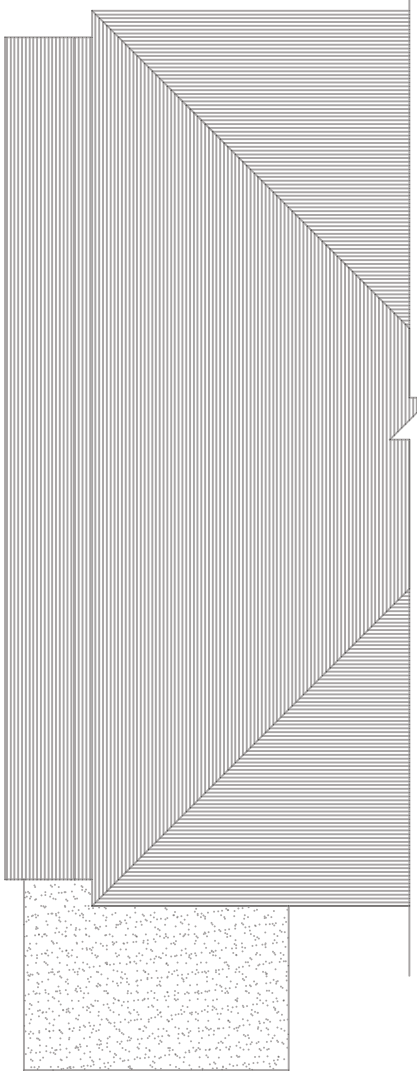


Conservation type
slim eco + reset rooflight to
pitch roof

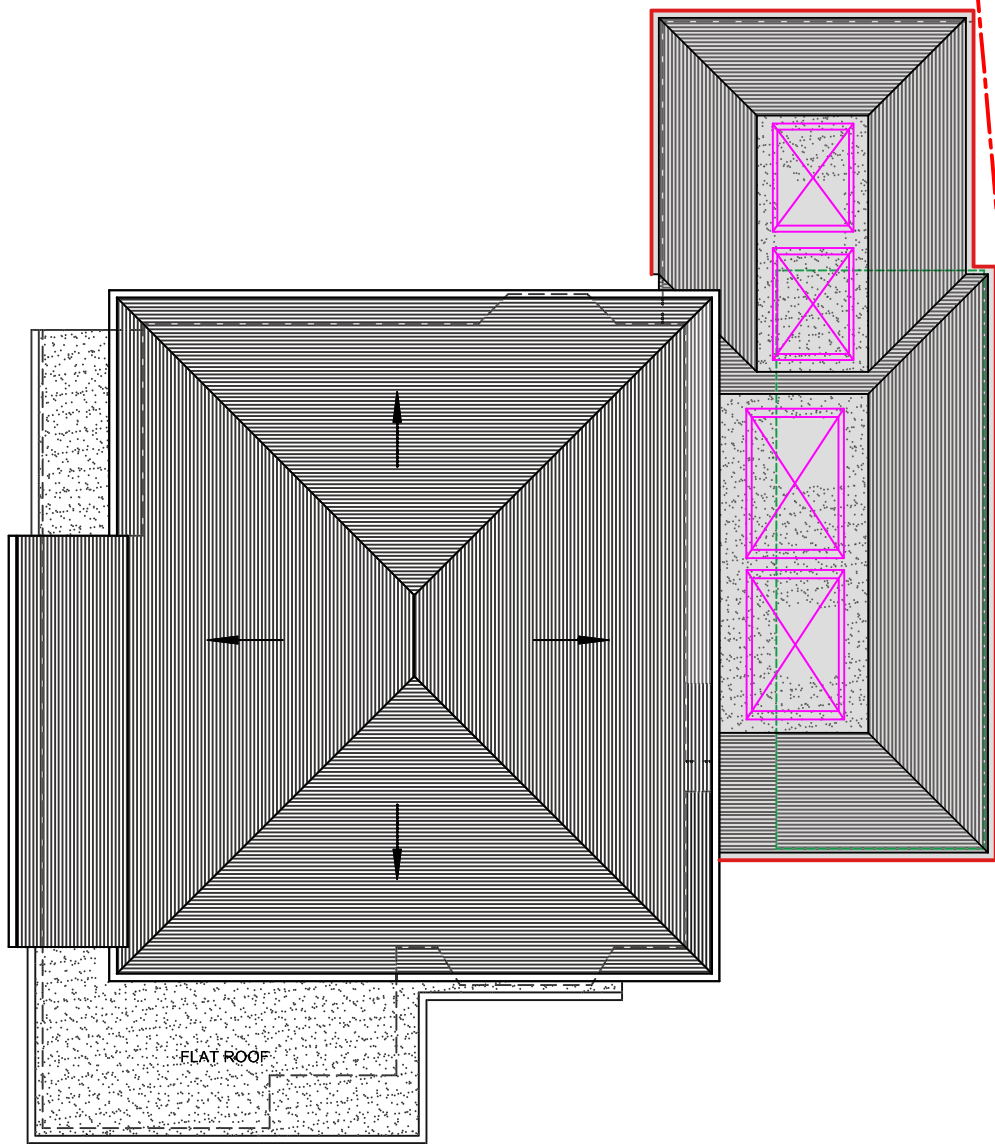

This application is revised in line with the pre-planning application.

- Pitch roof design revised.
- Contractor's working area indicated.
- Soakaway shown.

REV A - 24/05/2022
Original roof style used in pre planning reinstated shown in red outline

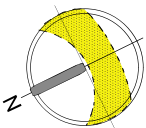

PROPOSED

Purpose - Householder planning application

All dimensions to be checked on site. All omissions & discrepancies to be reported to the designer.	PROJECT:	44 Raisins Hill, Pinner, HA5 2BS		DATE:	21/03/2022
	DWG. TITLE:	ROOF PLAN		REVISION:	10 A

© SSK architects owns the copyright of this drawing which must not be reproduced in whole or part without the written permission.



tel : 0796 222 3141
email : sandeep@sskarchitects.co.uk

scale - 1 : 100 @ A3

