


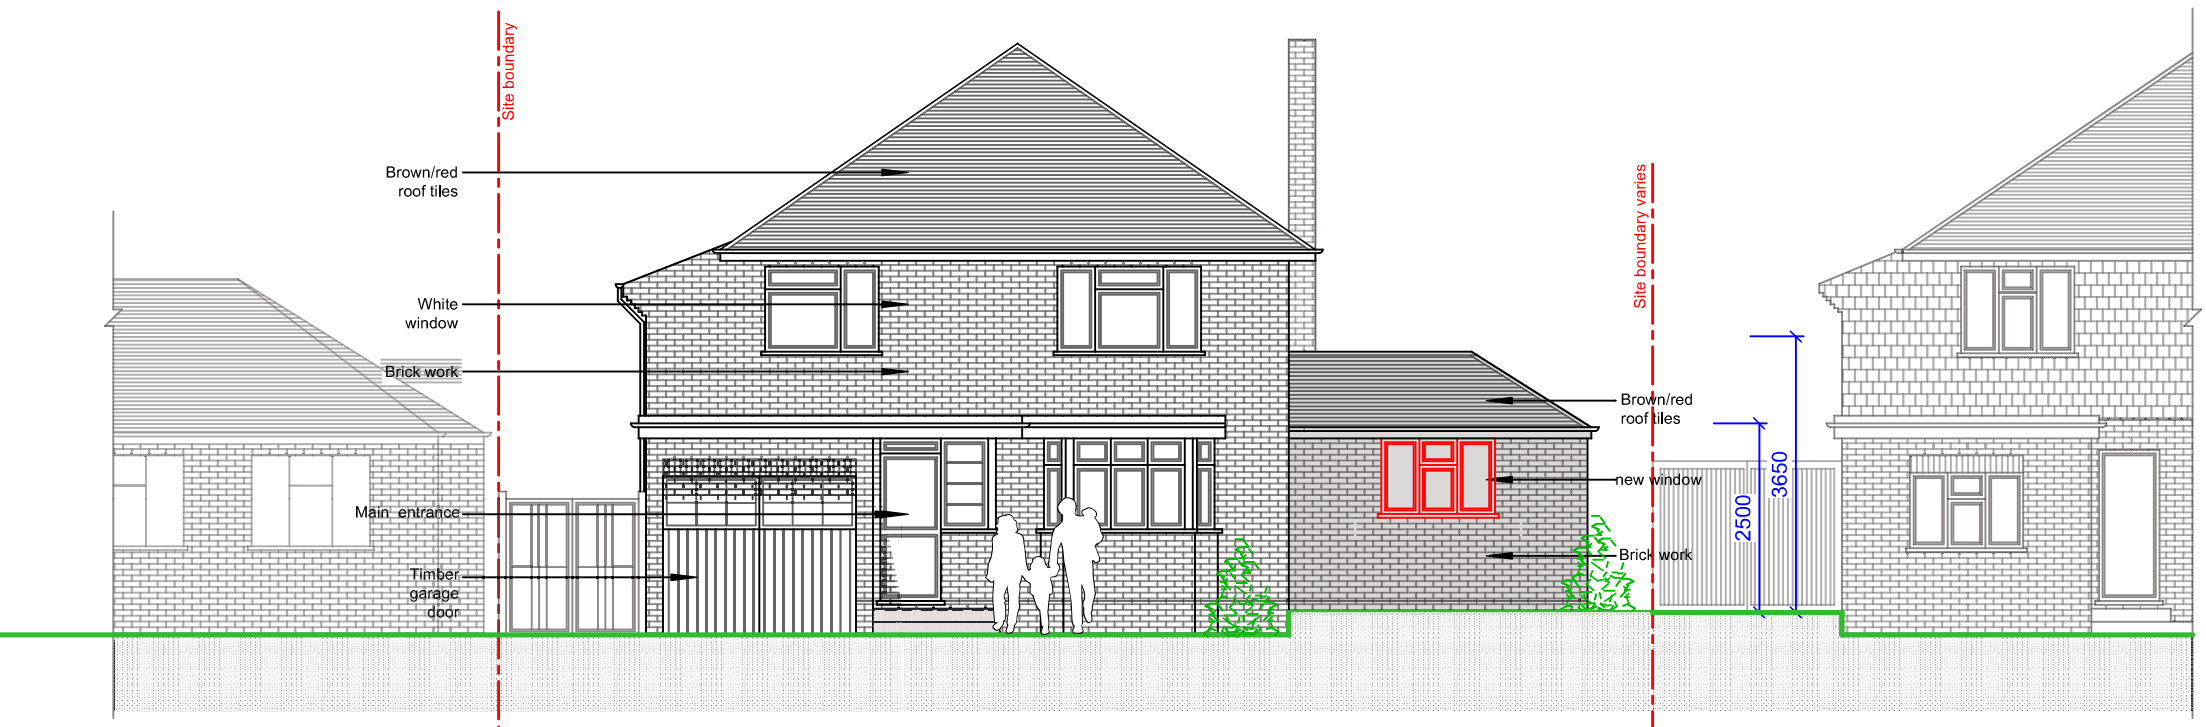

FRONT ELEVATION

GENERAL - New materials used in exterior work to match existing.

WALLS - To be facing brickwork

WINDOWS - All new windows to be double glazed, profile to match existing + set within opening to match existing.

- Side windows to be obscure glazing, top opening to be 1.7m from FFL.


DOORS - new doors to be double glazed, profile to match existing + set within opening to match existing.

RWP & GUTTERS - to be UPVc black to match existing.

ROOFLIGHTS - 'Velux' or similar. Projection to be max. 150mm beyond the plane of the roof-slope & flat roof.

EAVES - Detail to match existing, ie height of fascia & soffit width + colour of soffit and fascia

ROOF - Pitch roof - Plain red/brown roof tiles to match existing. Tile type, size & colour to match existing.

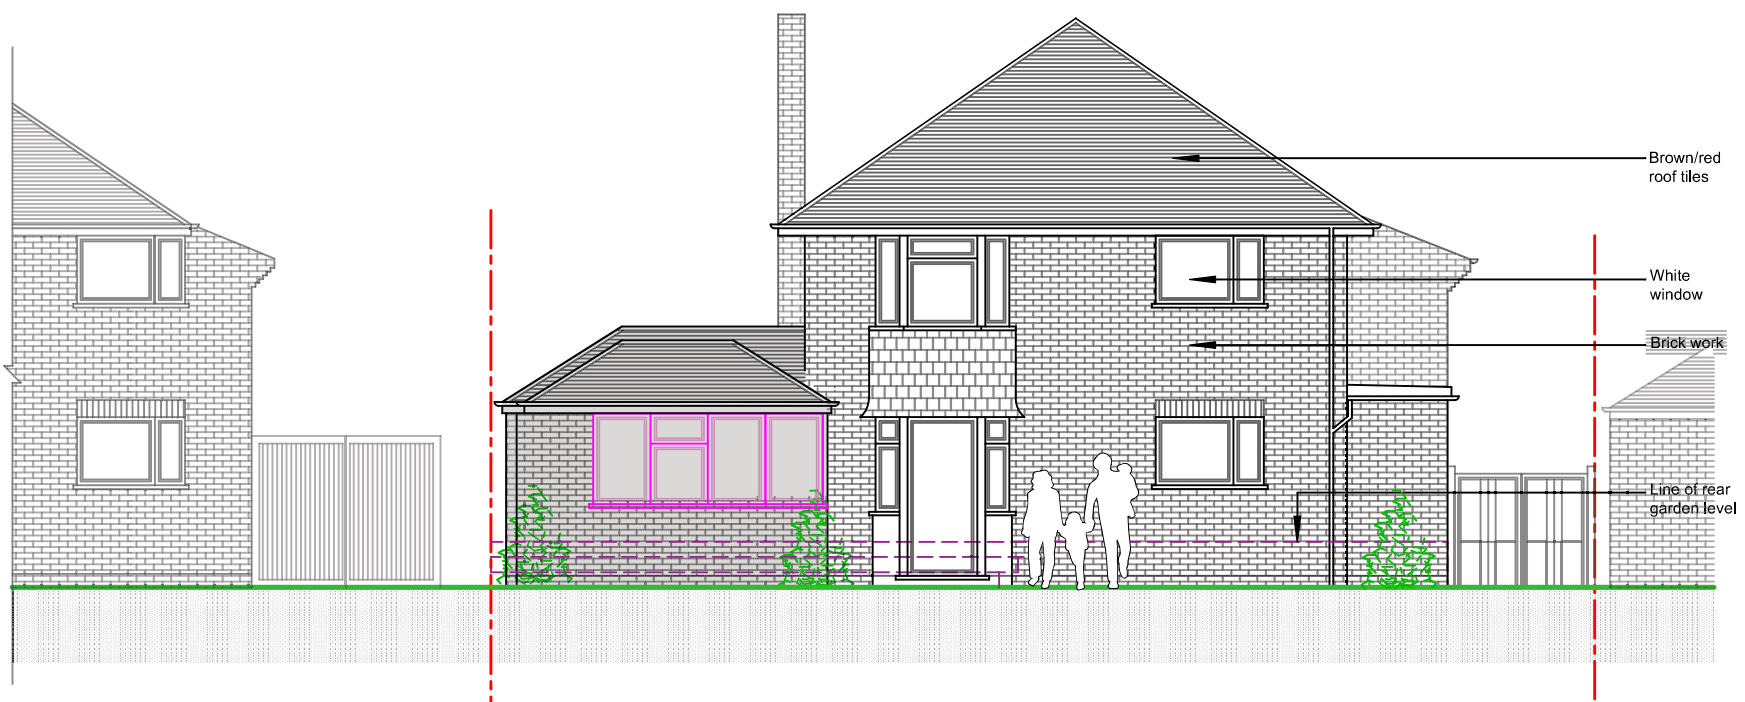

REAR ELEVATION

This application is revised in line with the pre-planning application.

- Pitch roof design revised.
- Contractor's working area indicated.
- Soakaway shown.

REV A - 24/05/2022
Original roof style used in pre planning reinstated shown in red outline.
Front elevation window matched to neighbours.
Eaves reduced to above window

PROPOSED

Purpose - Householder planning application

SSK ARCHITECTS
tel : 0796 222 3141
email : sandeep@sskarchitects.co.uk

scale - 1 : 100 @ A3
0 1m 2m 3m 4m 5m 6m

All dimensions to be checked on site. All omissions & discrepancies to be reported to the designer. SSK architects owns the copyright of this drawing which must not be reproduced in whole or part without the written permission.	PROJECT: 44 Raisins Hill, Pinner, HA5 2BS	DATE: 21/03/2022
	DWG. TITLE: ELEVATIONS	11

REVISION: A