




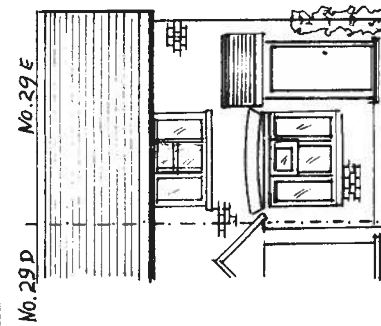


EXISTING FRONT ELEVATION (NORTH)

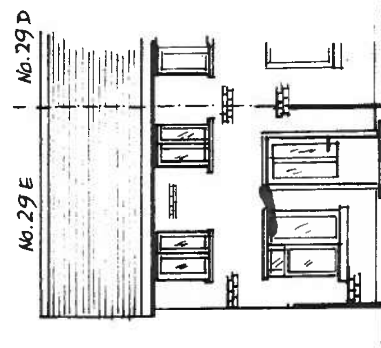


EXISTING REAR ELEVATION (SOUTH)

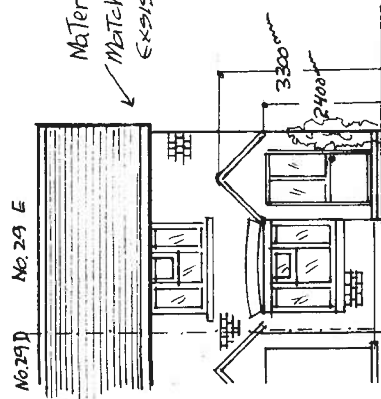


PROPOSED FRONT ELEVATION (NORTH)

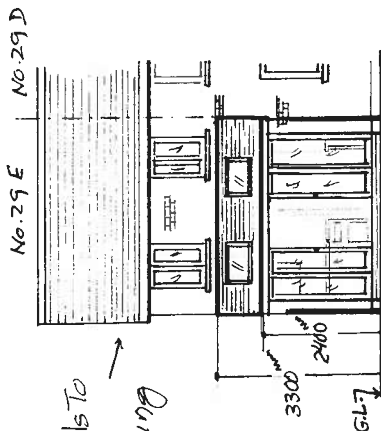


PROPOSED REAR ELEVATION (SOUTH)

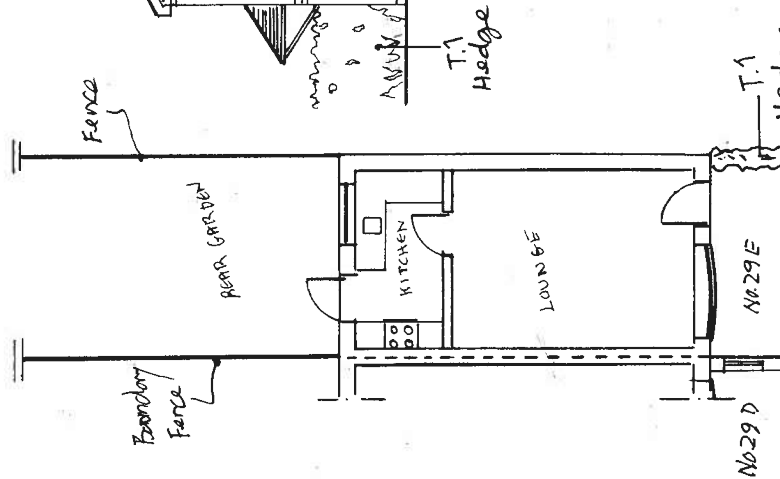


EXISTING GROUND FLOOR PLAN

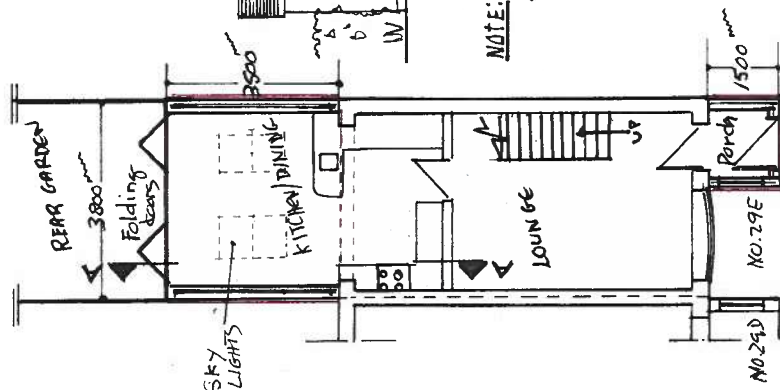

PROPOSED GROUND FLOOR PLAN

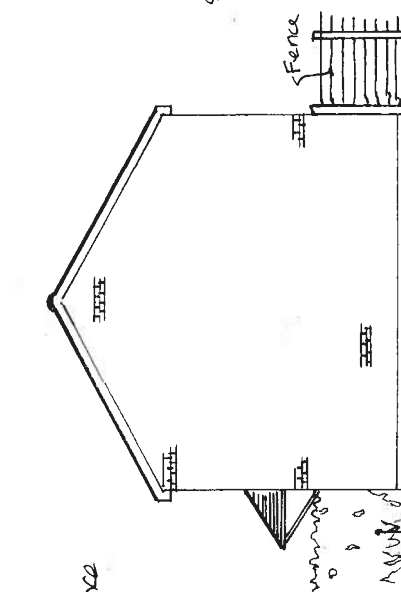

EXISTING SIDE ELEVATION (EAST)

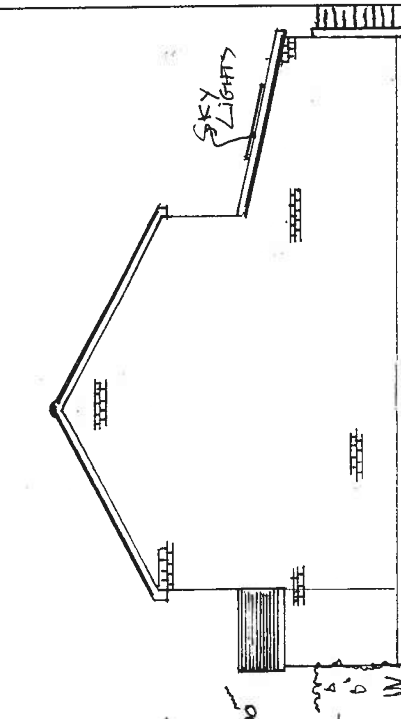

PROPOSED SIDE ELEVATION (EAST)

NOTE: ADDITIONS AND ALTERATIONS ARE SHOWN IN RED FOR CLARITY (PLAN)



SCALE 1:100

PROPOSAL : Erection of a Single Storey Rear Extension and Front Porch
ADDRESS : 29e Bosanquet Close, Uxbridge, UB8 3PE
CLIENT : Mr & Mrs Sullivan DRAWING No. BEP-01
PAPER SIZE -A3 SCALE : 1:100 DATE : 21/02/2022
Architectural Drawing Services CASN

1