

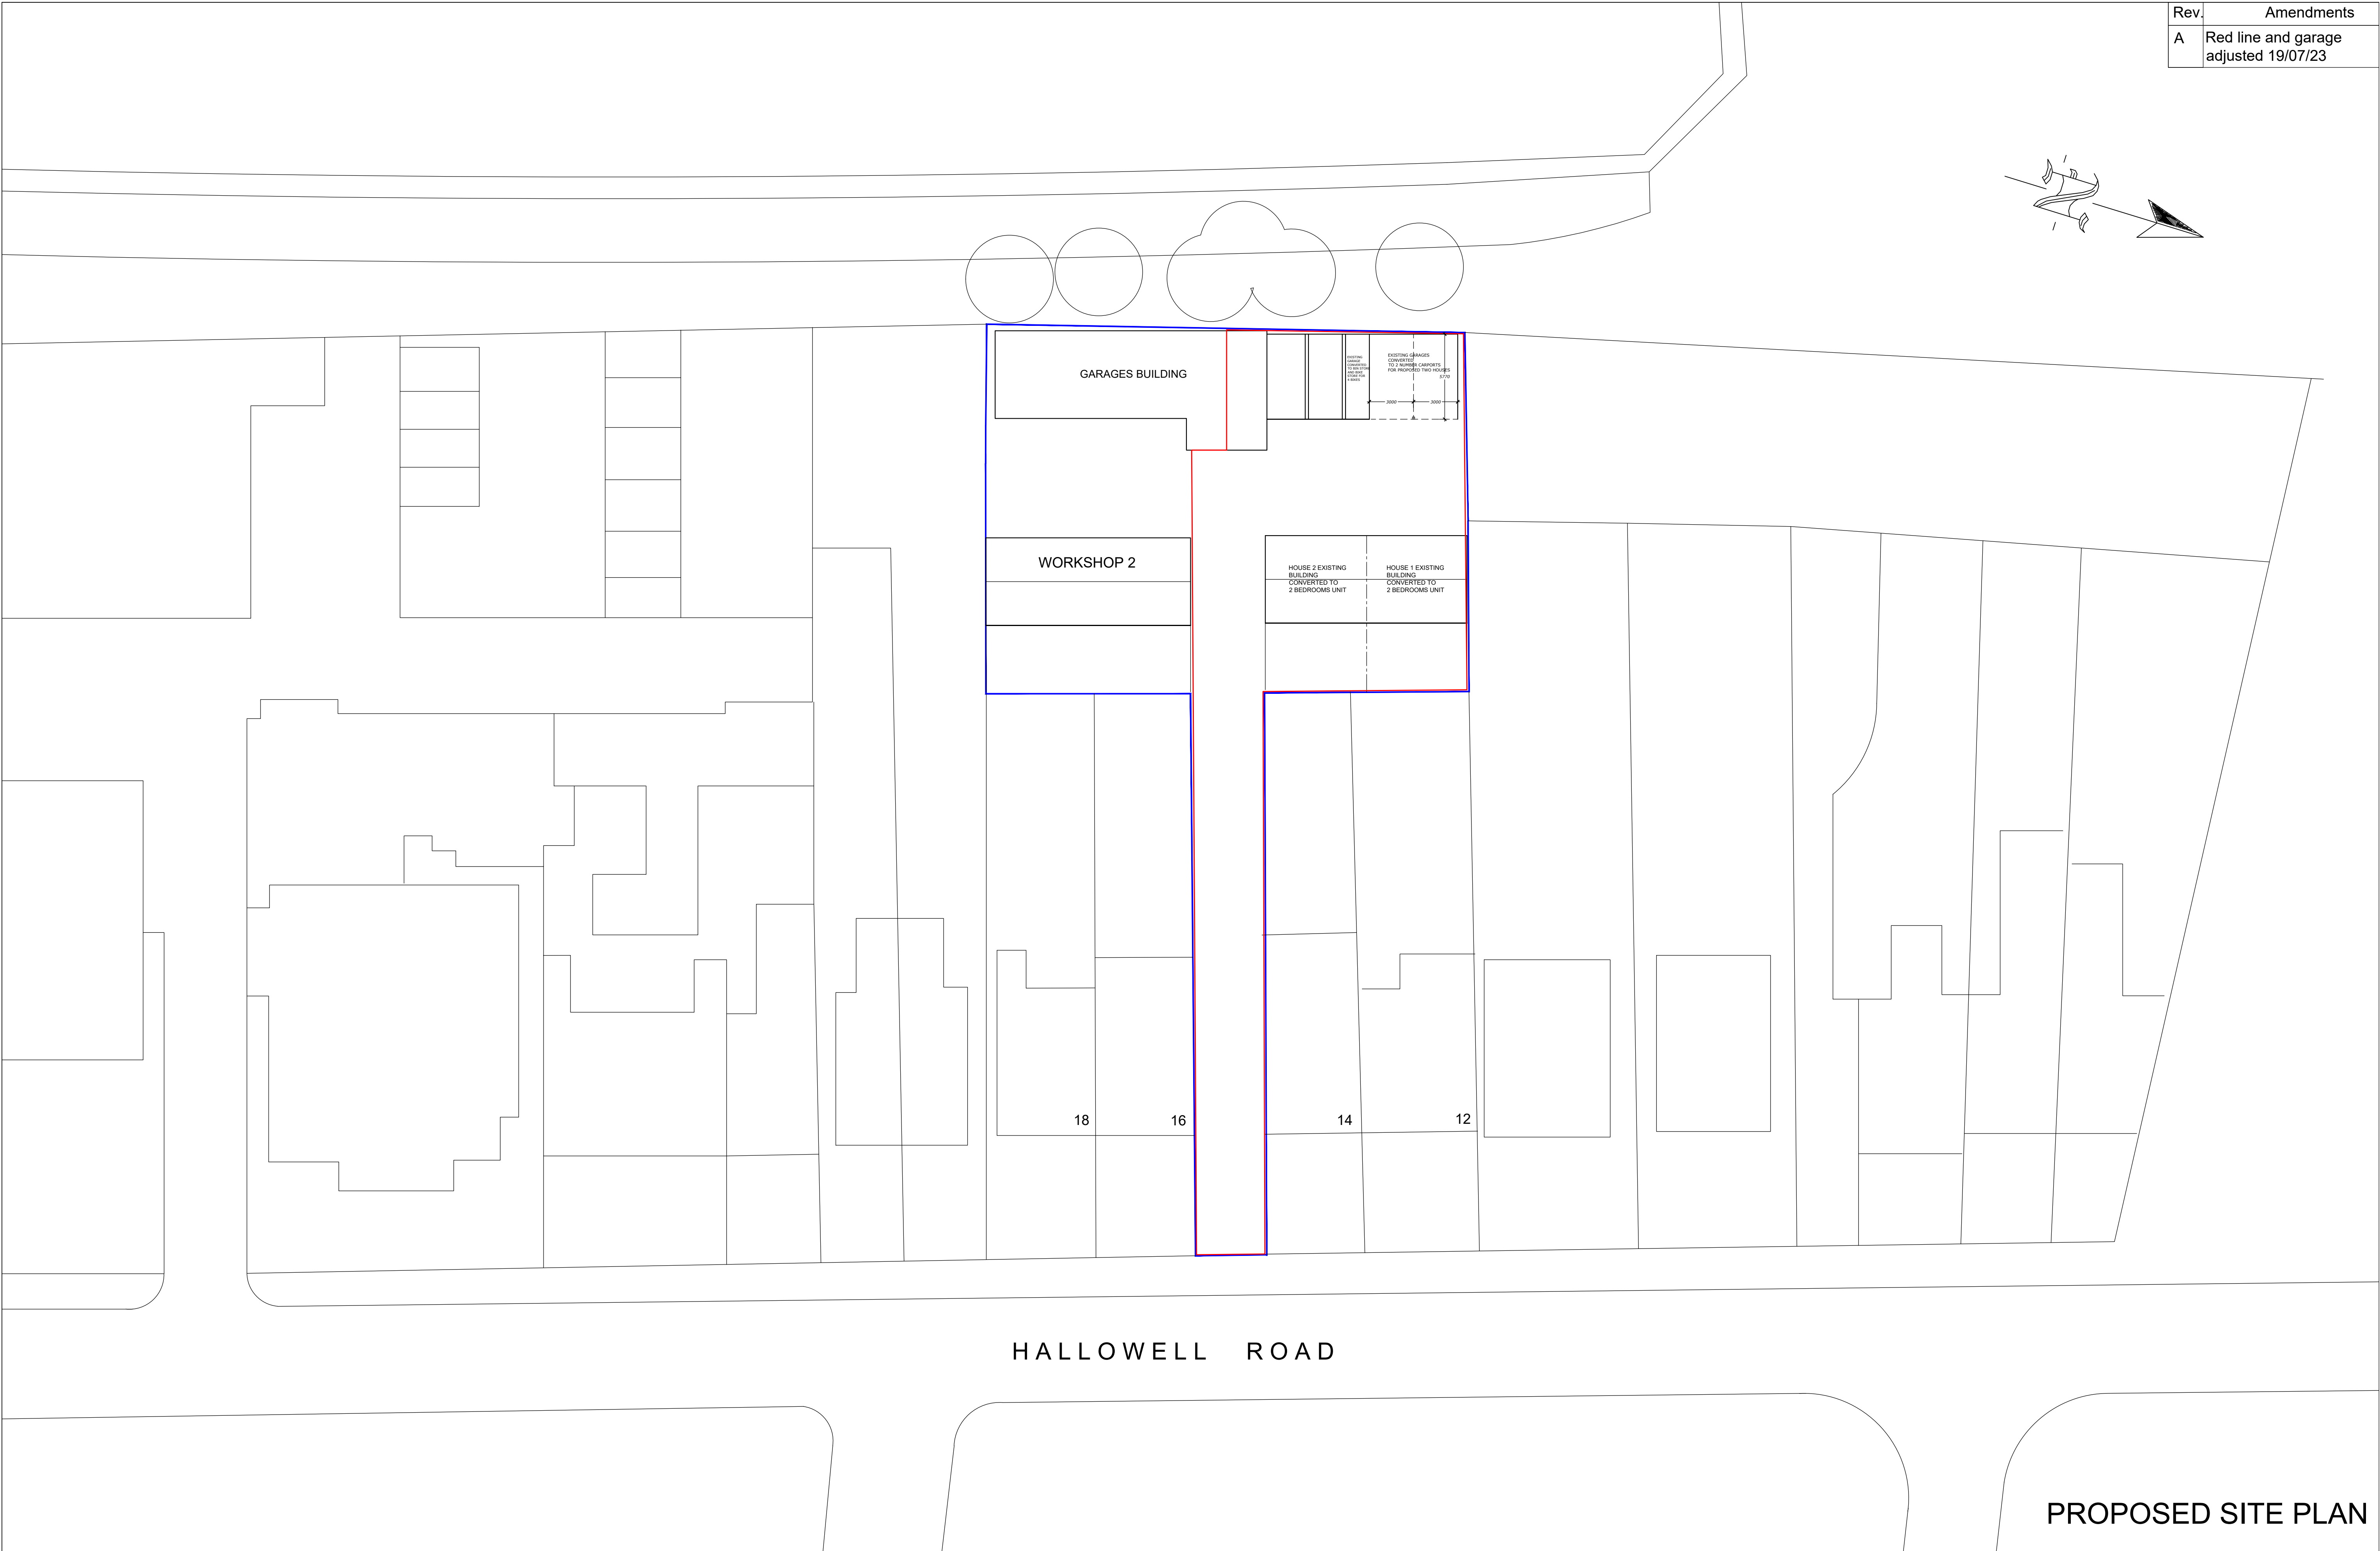
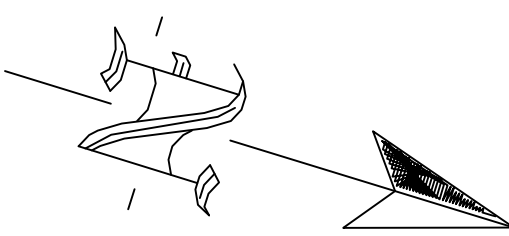


| Rev. | Amendments                            |
|------|---------------------------------------|
| A    | Red line and garage adjusted 19/07/23 |

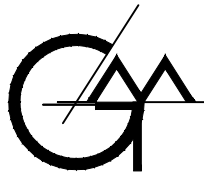

*Whittles Yard rear of, 12-14 Hollowell Road,  
Northwood, HA6 1DW*

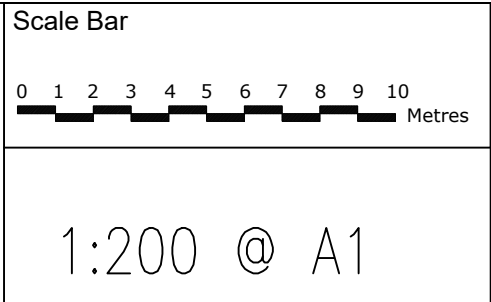

THE GILLETT MACLEOD PARTNERSHIP  
Chartered Architects & Town Planning Consultants  
1 High Road Old Eastcote Pinner Middlesex HA5 2EW tel. 0208 868 1333

Drg. No. 21/3484/401 A  
Scale 1:200  
Date 26/06/23  
Drawn by SB

| REVISION |
|----------|
| A        |
| drawer   |