





existing (as-built) front elevation

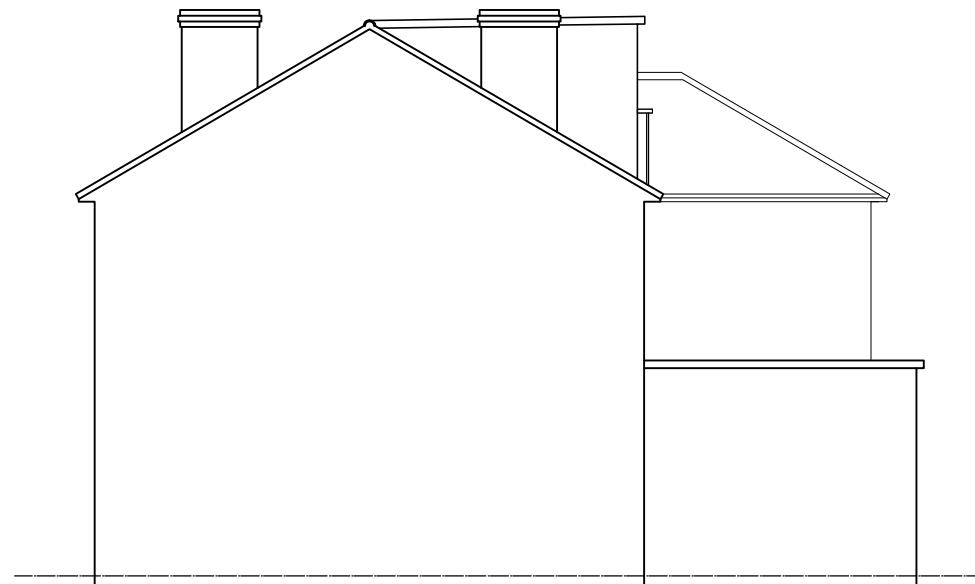


existing (as-built) left side elevation

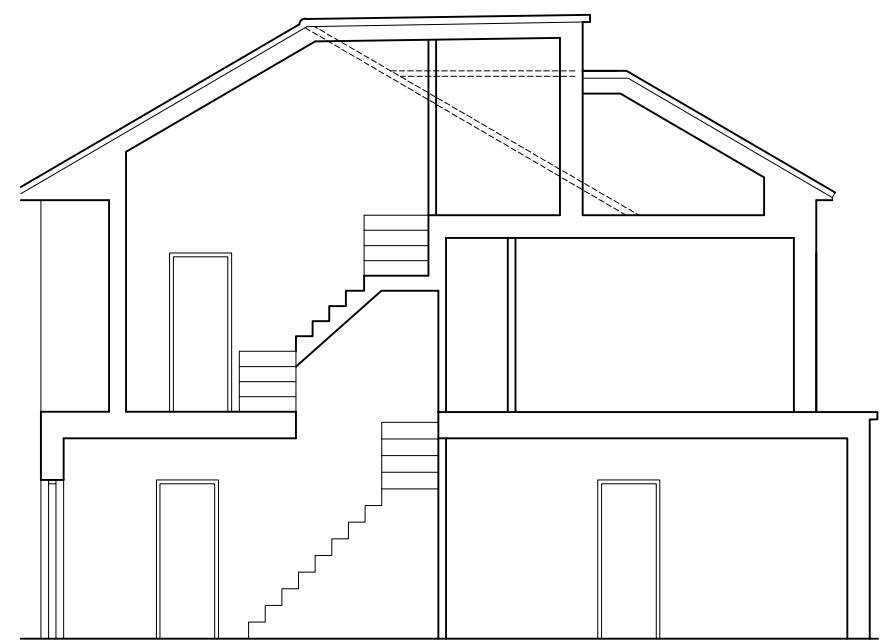

SECTION as existing



existing (as-built) rear elevation

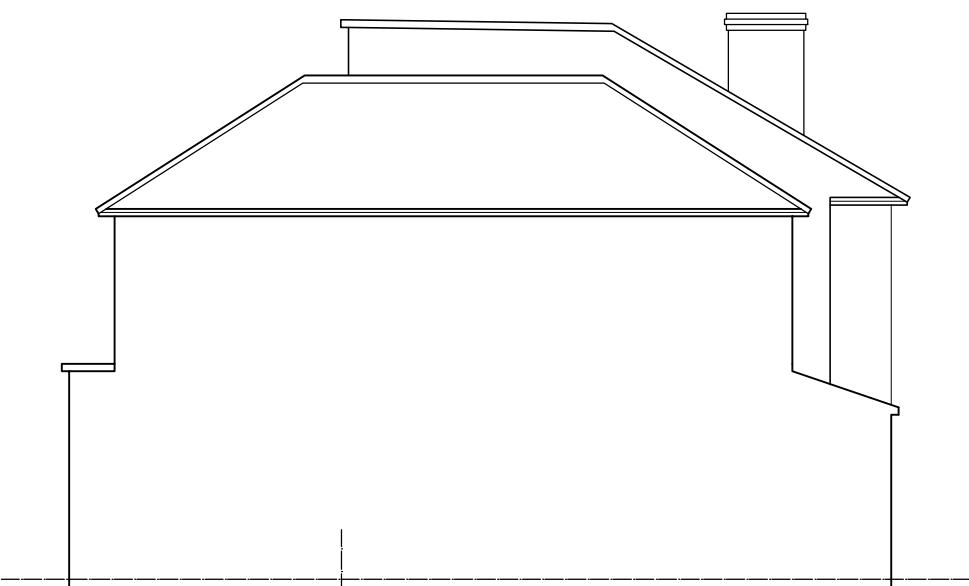

existing (as-built) right side elevation

Notes: -  
Do not scale from this drawing for any other purpose than planning. If no authorisation signature present drawing is for reference only. This drawing or part thereof is not to be copied without Agenda 21 Architects Studio written consent. Figured dimensions only are to be taken from this drawing. All dimensions to be checked on site by main contractor prior to commencement. All discrepancies to be reported to the Architect immediately. If in doubt, ask. © This drawing is the copyright of Agenda 21 Architects Studio Ltd.

key plan  
04.04.24 AS Issued for Full-Application  
11.08.23 AS Issued for Pre-Application  
rev date by note  
**PLANNING**  
60 Bempton Drive, Ruislip,  
Hillingdon, HA4 9DD  
project name  
Mr Bekim Mehmeti  
client name  
Existing Elevations (as built)  
drawing title  
883-000-L-X01  
drawing number  
883 1:100 @ A3 JL AS  
job reference scale architect drawn by  
**agenda 21**  
architects studio  
2-4 Sebastian Street, London EC1V 0HE  
t. 020 7687 6001 f. 020 7687 6002 e. info@agenda21arch.com