




SCALE DRAWINGS FOR PLANNING PURPOSES ONLY
ALL DIMENSIONS TO BE CHECKED ON SITE PRIOR
TO COMMENCEMENT AND ANY DISCREPANCY REPORTED
TO RCCA
THIS DRAWING IS COPYRIGHT AND CANNOT BE REPRODUCED
IN PART OR WHOLE WITHOUT WRITTEN CONSENT OF RCCA



EXISTING SIDE ELEVATION TO WEST
SCALE 1:100

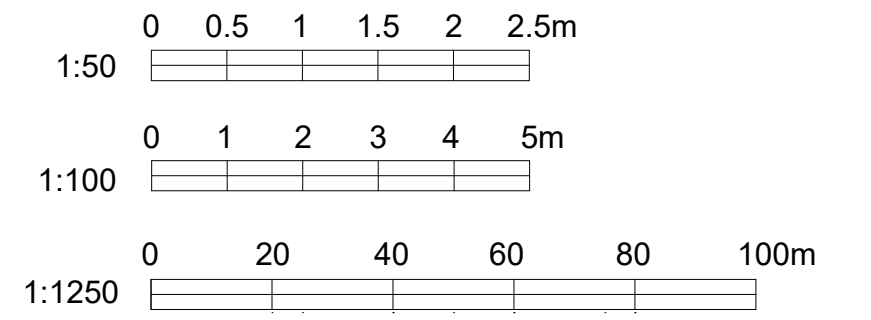


EXISTING REAR ELEVATION
SCALE 1:100





EXISTING SIDE ELEVATION TO EAST
SCALE 1:100



Distance Survey Ltd. Copyright 2020. All rights reserved. Licence number: 180020432

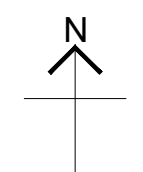

SITE LOCATION PLAN
SCALE 1:1250

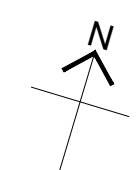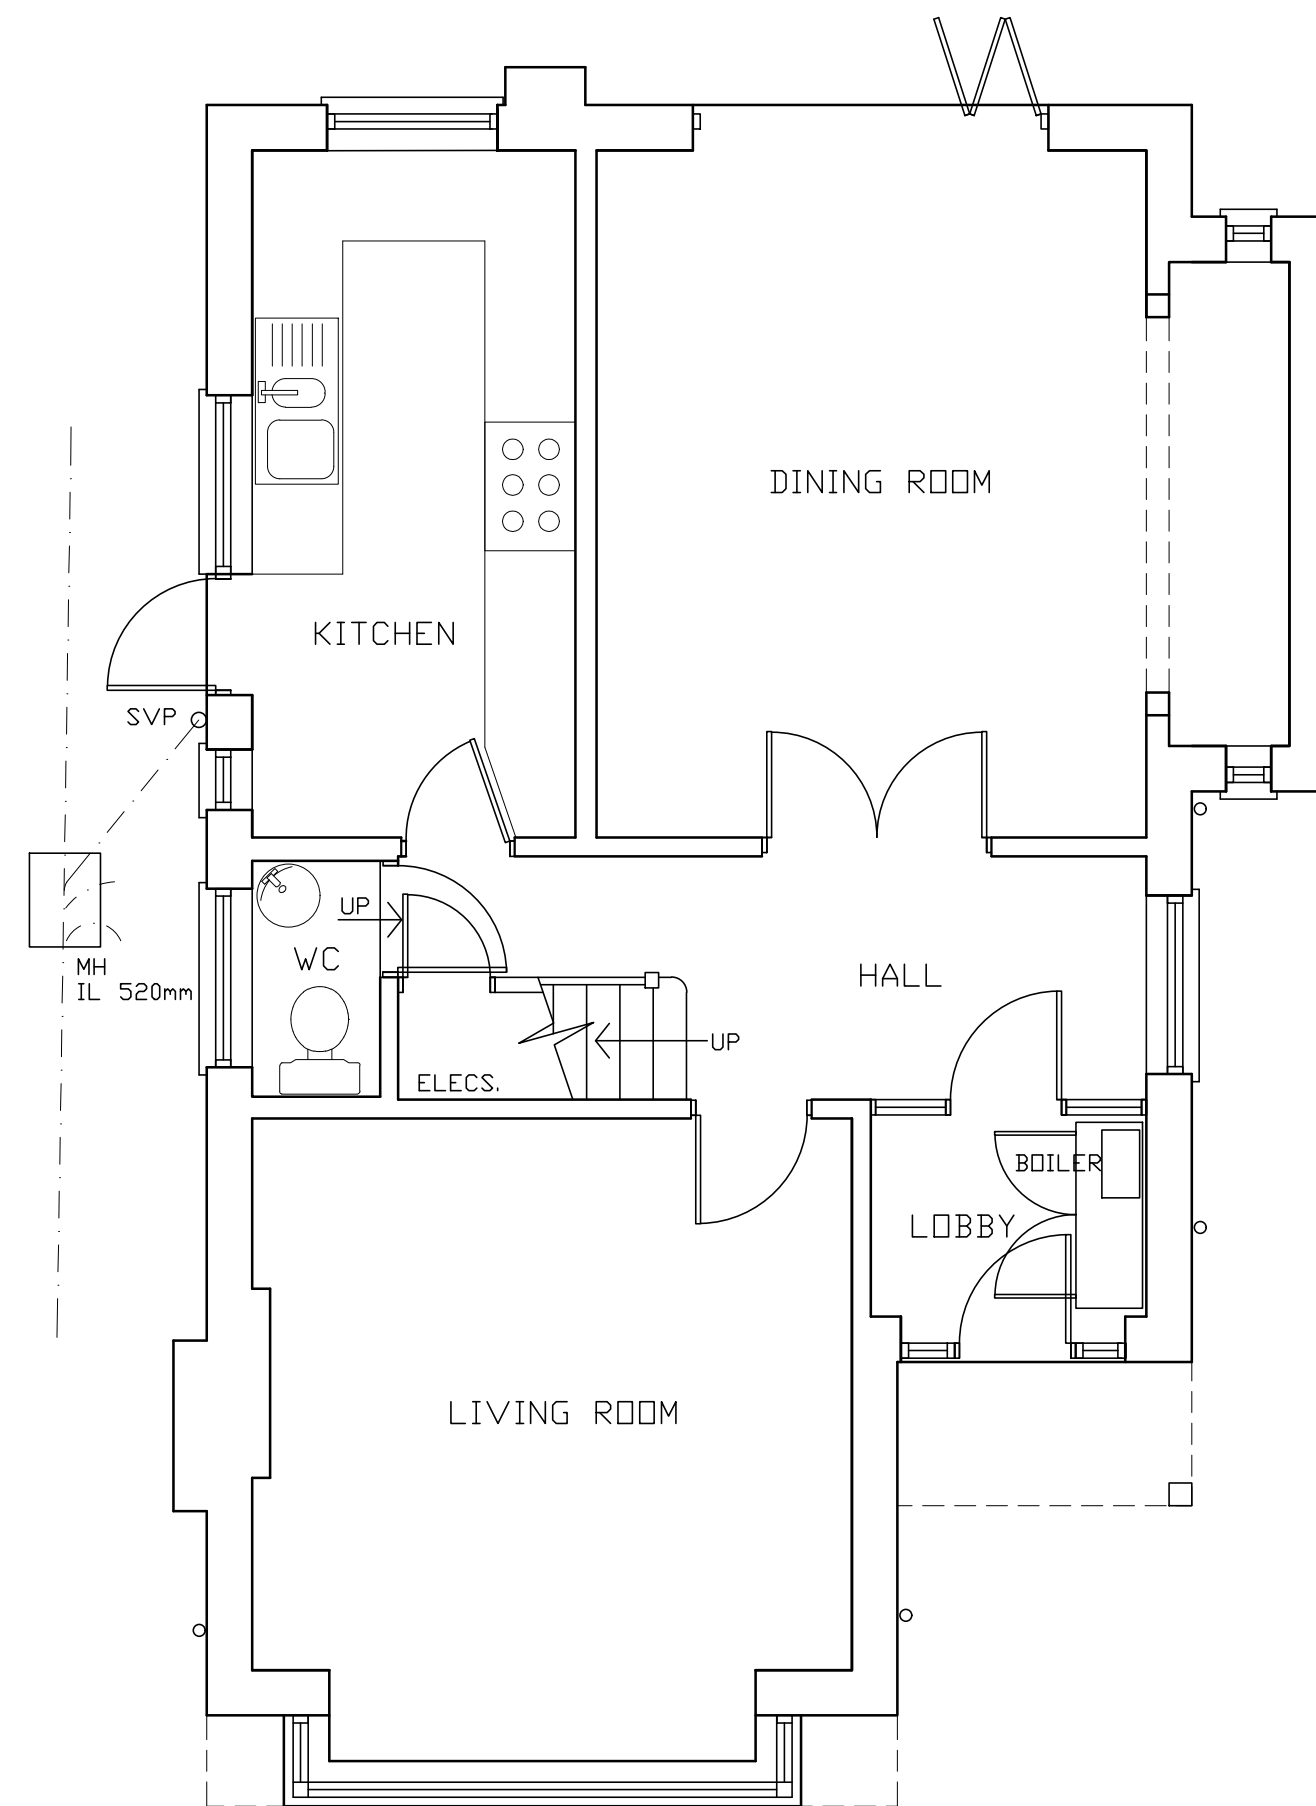

EXISTING GROUND FLOOR PLAN
SCALE 1:50

REVISIONS



Clarks Barn, Bassetsbury Lane, High Wycombe, Bucks HP11 1QX
T 01494 888000 F 01494 888008 E RICClark@richardclarkarchitects.co.uk

CONTRACT

66 SHARPS LANE
RUISLIP
HA4 7JQ

CLIENT

MR AND MRS D CARTER

DRAWING

RECORD SURVEY

DRAWN

JP

SCALE

as shown @ A1 1985/SUR

DATE

SEPT 22

JOB / DRWG No

