

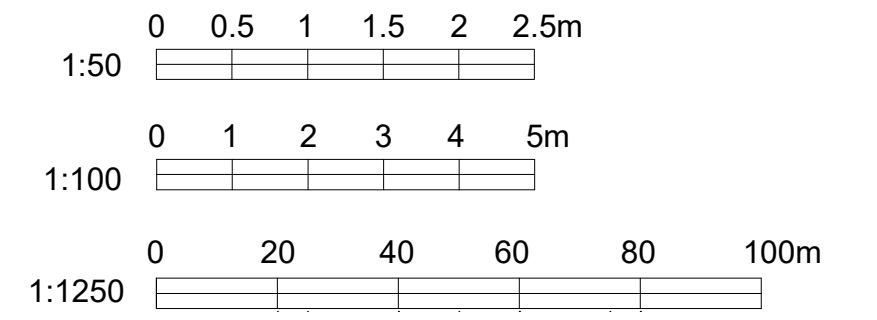


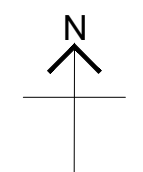

SCALE DRAWINGS FOR PLANNING PURPOSES ONLY
ALL DIMENSIONS TO BE CHECKED ON SITE PRIOR
TO COMMENCEMENT AND ANY DISCREPANCY REPORTED
TO RCCA
THIS DRAWING IS COPYRIGHT AND CANNOT BE REPRODUCED
IN PART OR WHOLE WITHOUT WRITTEN CONSENT OF RCCA

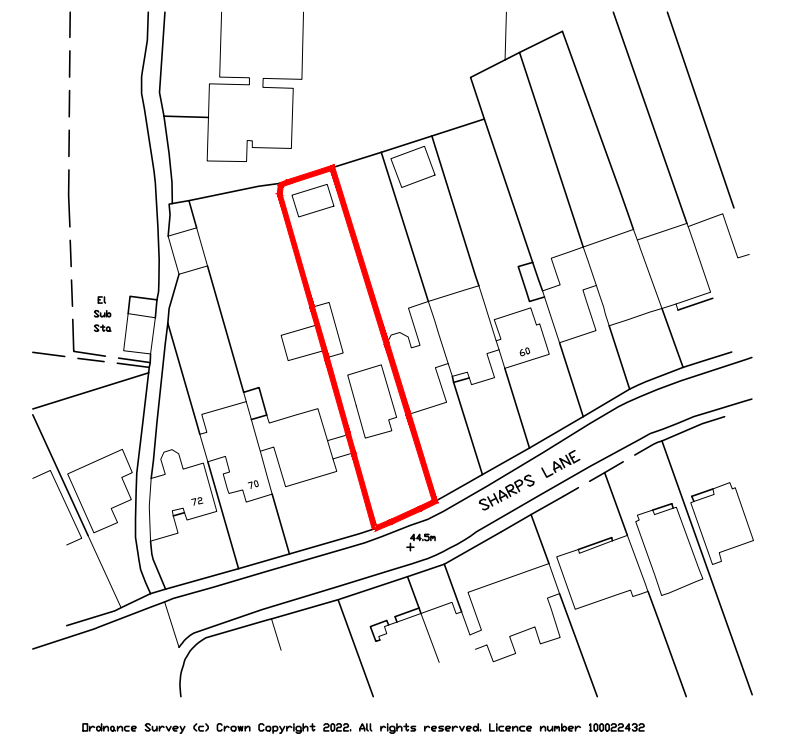

SITE LOCATION PLAN
SCALE 1:1250

REVISIONS
REV A DEC 22 EXISTING FRONT ELEVATION ADDED




Clarks Barn, Bassetsbury Lane, High Wycombe, Bucks HP11 1QX
T 01494 888000 F 01494 888008 E RICClark@richardclarkarchitects.co.uk

CONTRACT
66 SHARPS LANE
RUISLIP
HA4 7JQ

CLIENT
MR AND MRS D CARTER

DRAWING
RECORD SURVEY

DRAWN DATE
JP SEPT 22
SCALE JOB / DRWG No
as shown @ A1 1985/SUR A

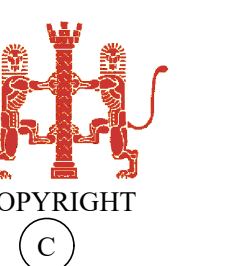

EXISTING FRONT ELEVATION
SCALE 1:100





EXISTING SIDE ELEVATION TO WEST
SCALE 1:100



EXISTING SIDE ELEVATION TO EAST
SCALE 1:100



EXISTING REAR ELEVATION
SCALE 1:100

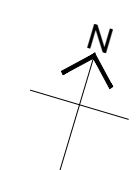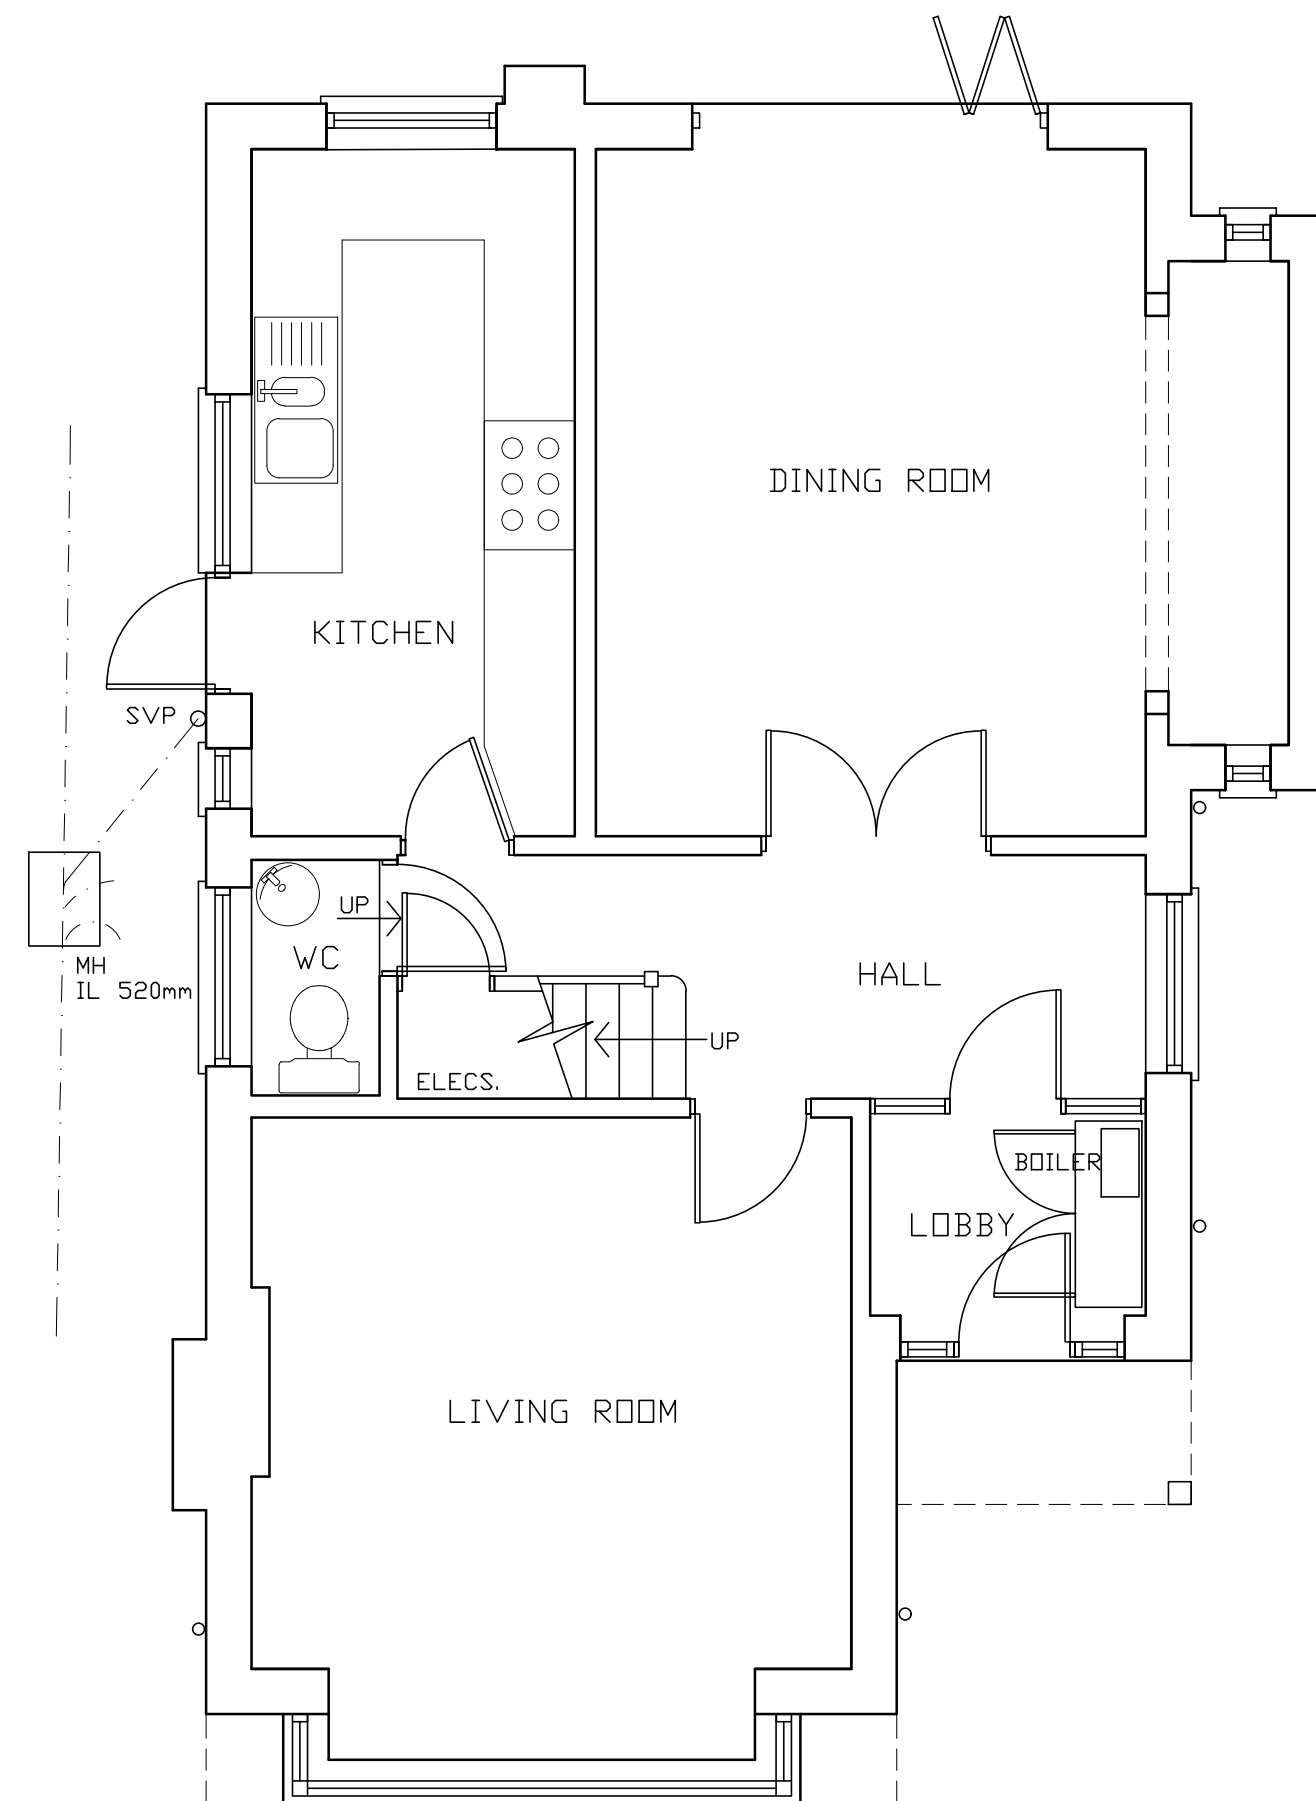

EXISTING GROUND FLOOR PLAN
SCALE 1:50