






FRONT (NORTH EAST) ELEVATION

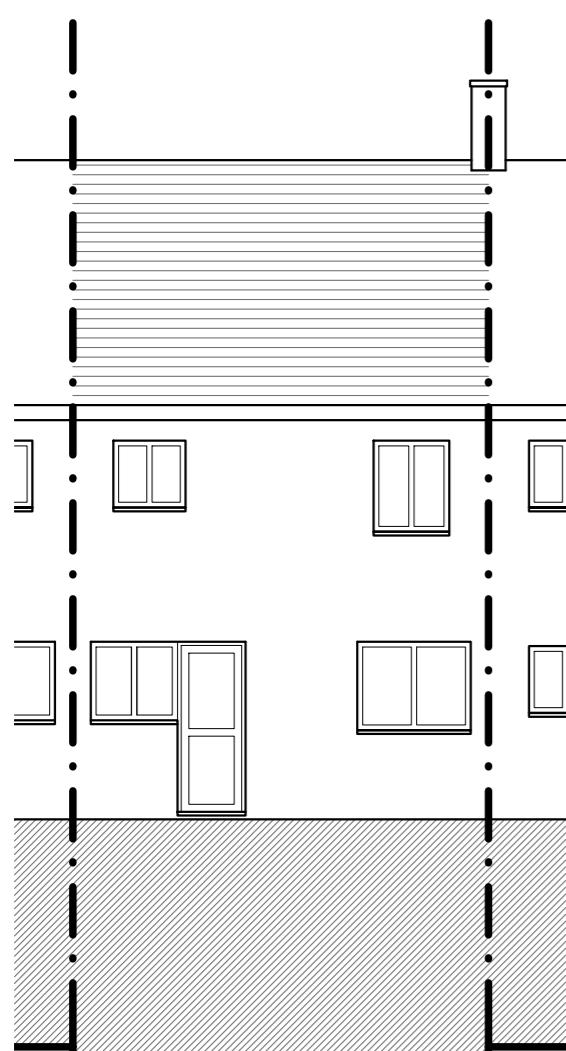

REAR (SOUTH WEST) ELEVATION

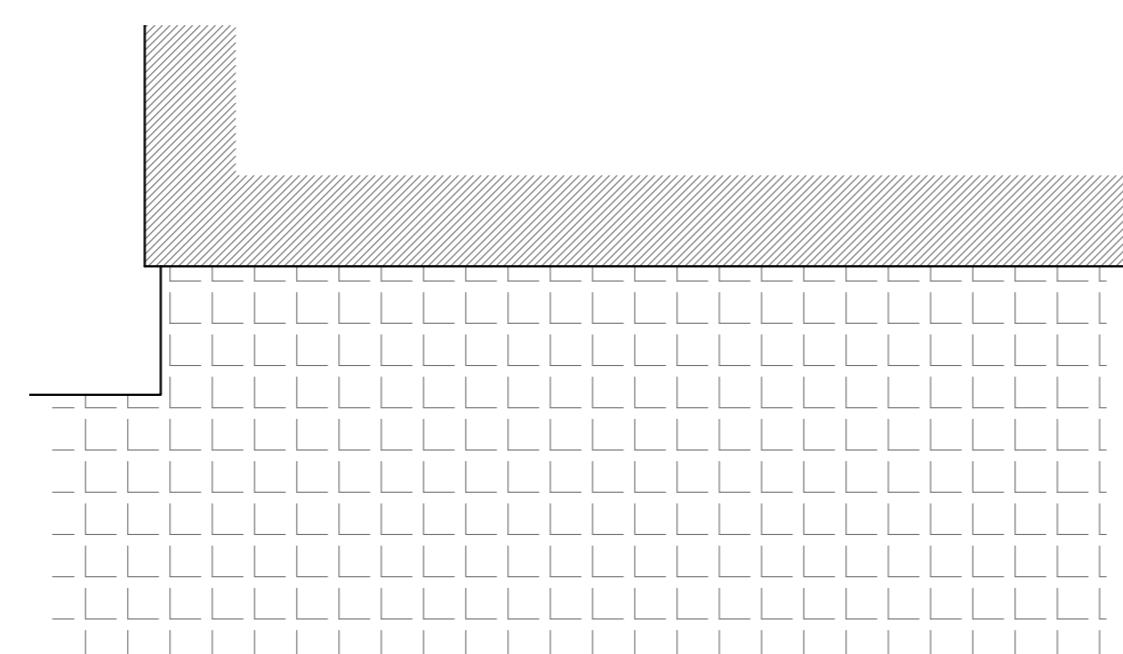


DECK ACCESS

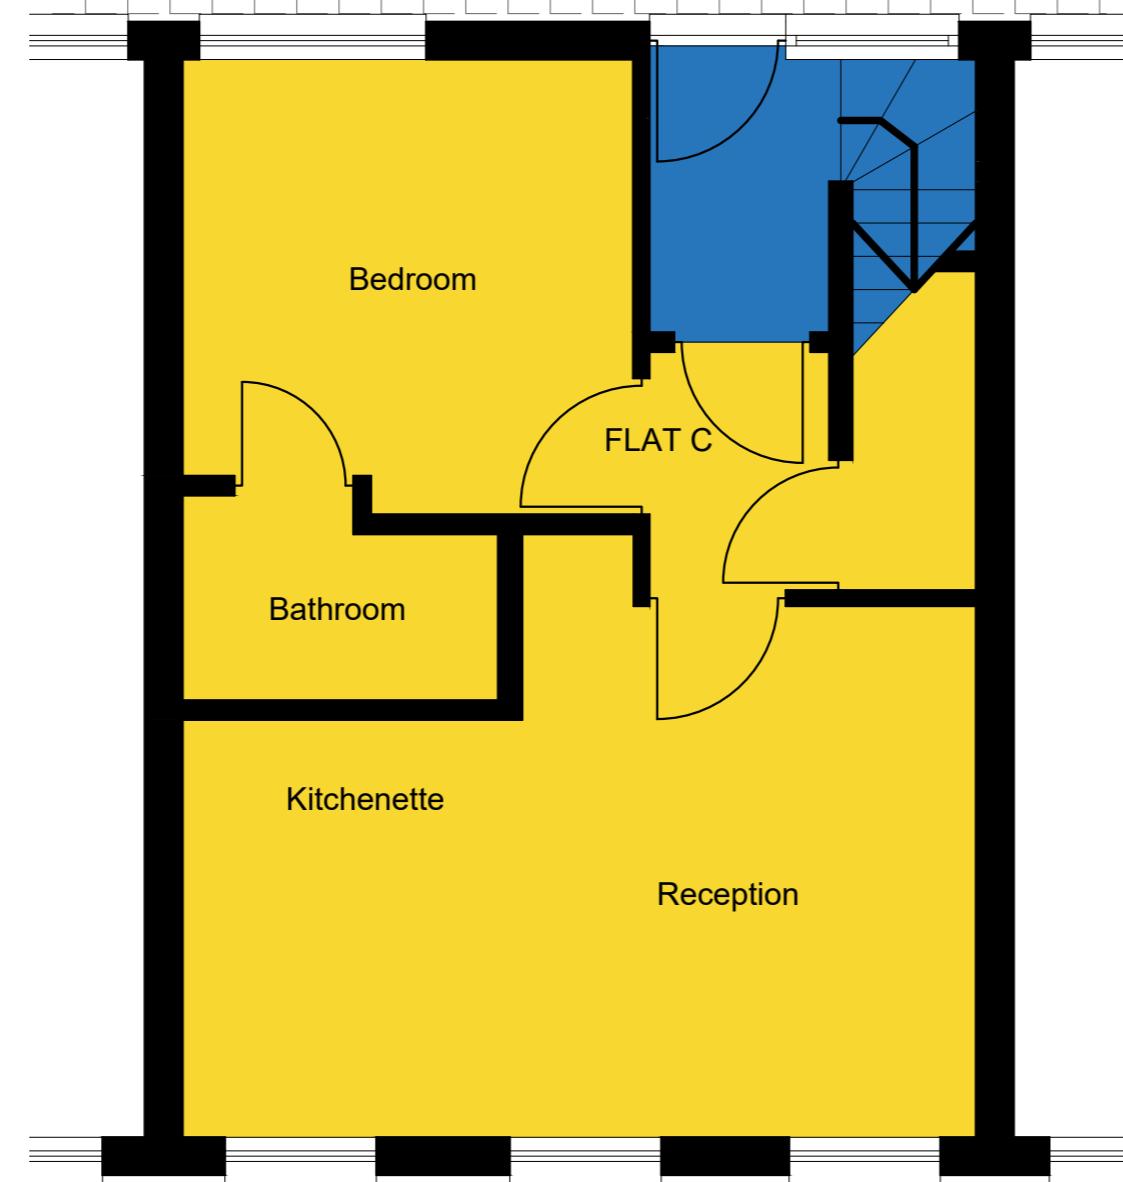

FIRST FLOOR PLAN

0 5 10
SCALE BAR 1:100


SCALE BAR 1:100

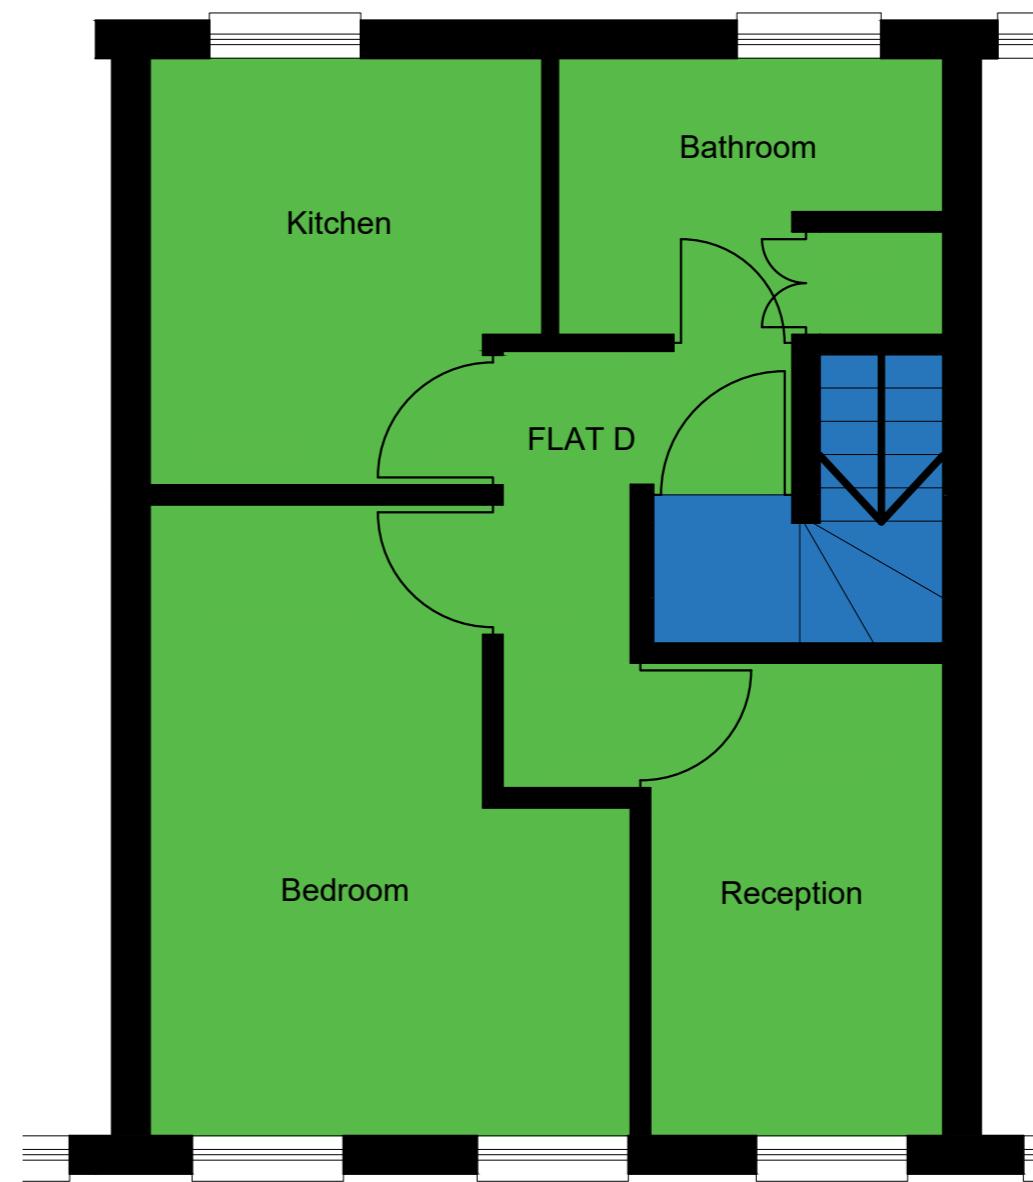


SECOND FLOOR PLAN

0 5 10
SCALE BAR 1:50

SCALE BAR 1:50

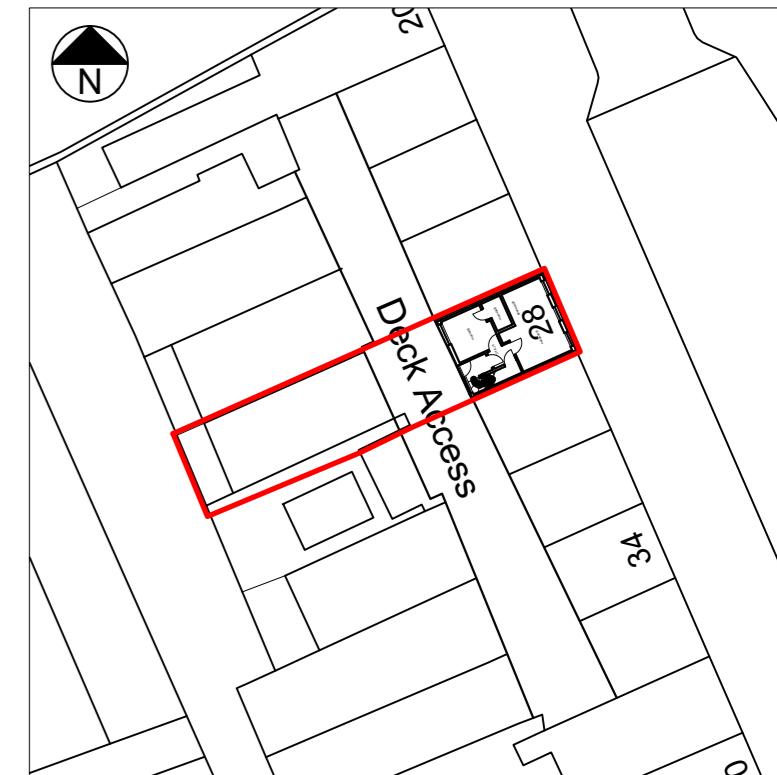

BLOCK PLAN (1:500)

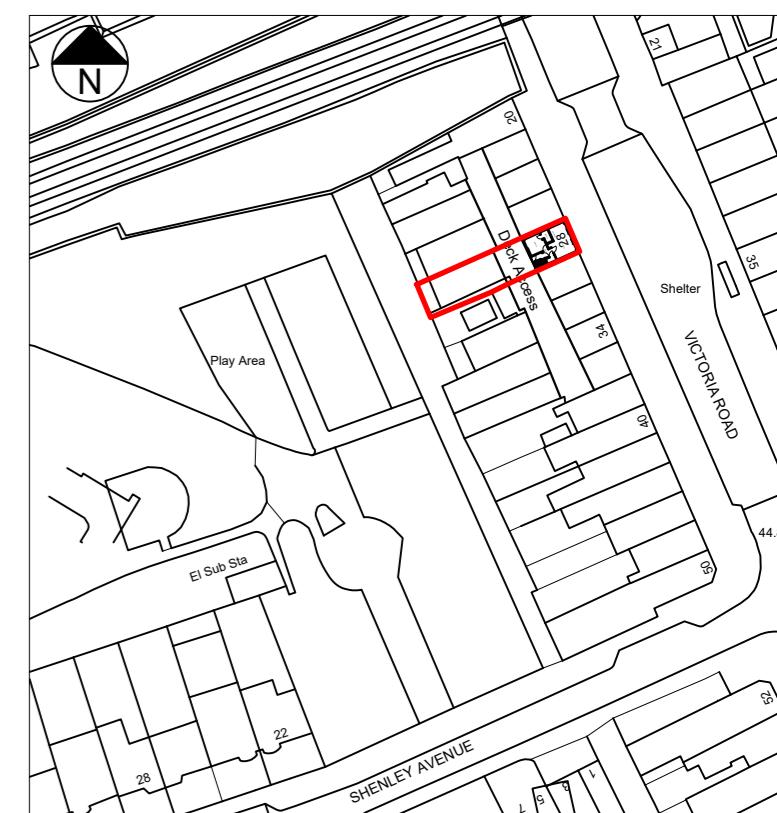

LOCATION PLAN (1:1250)

T R Harris Design & Surveying Services
559 Rayners lane, Pinner, Middlesex HA5 5HP
www.trharrisdesign.co.uk Tel: 07957 619812

PROJECT

Flats C & D
28B Victoria Road
RUISLIP
HA4 0AB

TITLE

As Built Plans & Elevations

SCALE	1:50 & 1:100 @ A2	DRAWING NO.
DATE	September 2022	22/28VR/01