


NOTES:
 This drawing is prepared solely for design and planning submission purposes. It is not intended or suitable for either Building Regulations or Construction purposes and should not be used for such.
 Any discrepancies to be brought to the attention of the architect.
 This drawing to be read in conjunction with other relevant drawings and the specification.
 Copyright in this drawing remains the property of Studio Jayga Ltd. This drawing may not be copied or used without the permission of Studio Jayga.

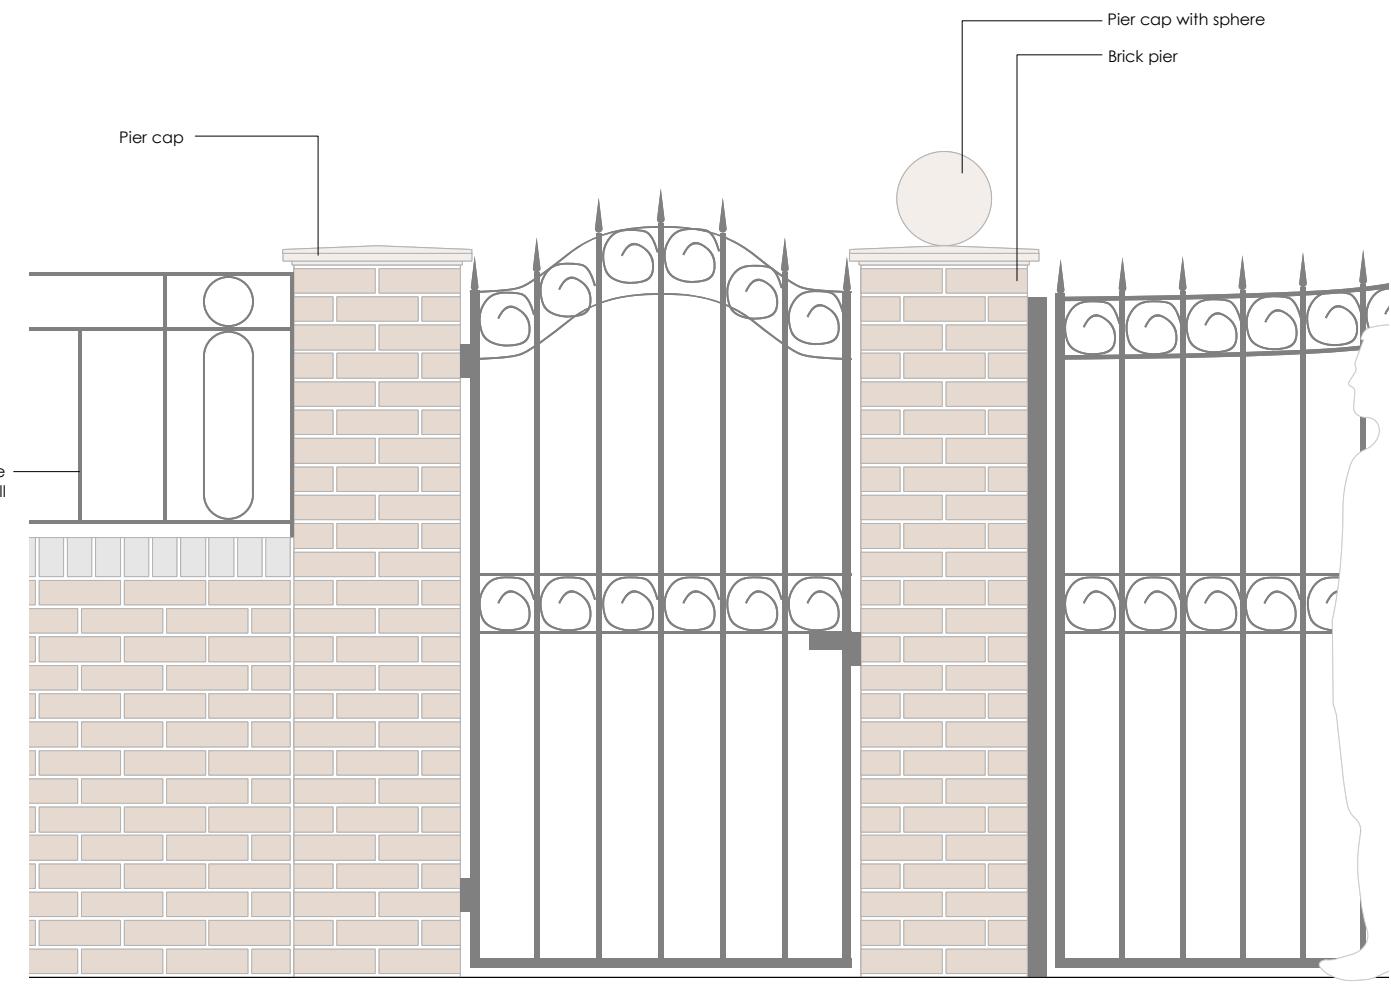

2 Wall & Gate Detail
 1:20 @ A3



PLANNING

project 27 & 29 Woodstock Drive, Ickenham
 stage Planning
 client Mr R Saroya
 drawing Boundary wall and gate plan and details
 scale 1:200/20 @ A3
 date Oct 2022
 dwg no 644-202