


2 As-Built Gates
1:25 @ A3

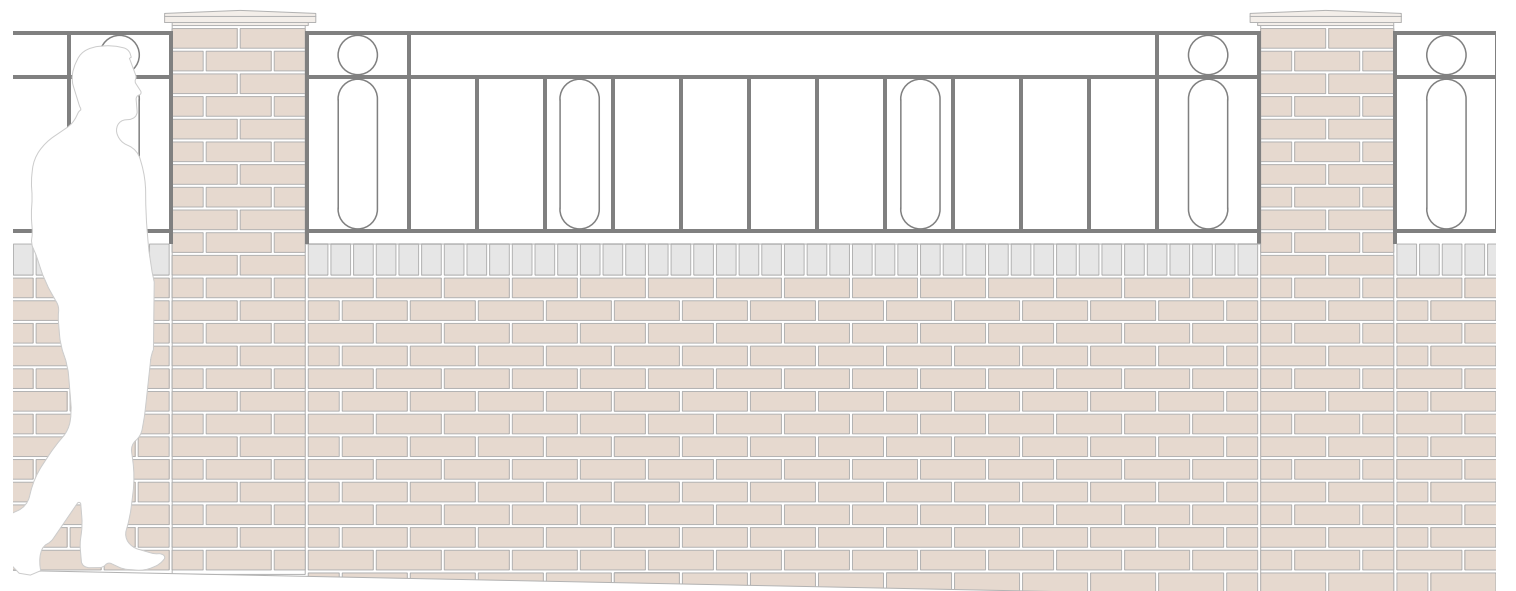

3 As-Built Typical Wall & Brick Pier
1:25 @ A3

NOTES:

This drawing is prepared solely for design and planning submission purposes. It is not intended or suitable for either Building Regulations or Construction purposes and should not be used for such.

Any discrepancies to be brought to the attention of the architect.

This drawing to be read in conjunction with other relevant drawings and the specification.

Copyright in this drawing remains the property of Studio Jayga Ltd. This drawing may not be copied or used without the permission of Studio Jayga.

PLANNING

project **27 & 29 Woodstock Drive, Ickenham**

stage **Planning**

client **Mr R Saroya**

drawing **Existing Boundary wall & gate plan & details**

scale **1:200/25 @ A3**

date **May 2024**

dwg no **644-202**

Studio Jayga Architects
www.studiojayga.com