


AS BUILT GROUND FLOOR PLAN

0 0.5 1M 2 3 4 5M



AS BUILT FRONT ELEVATION

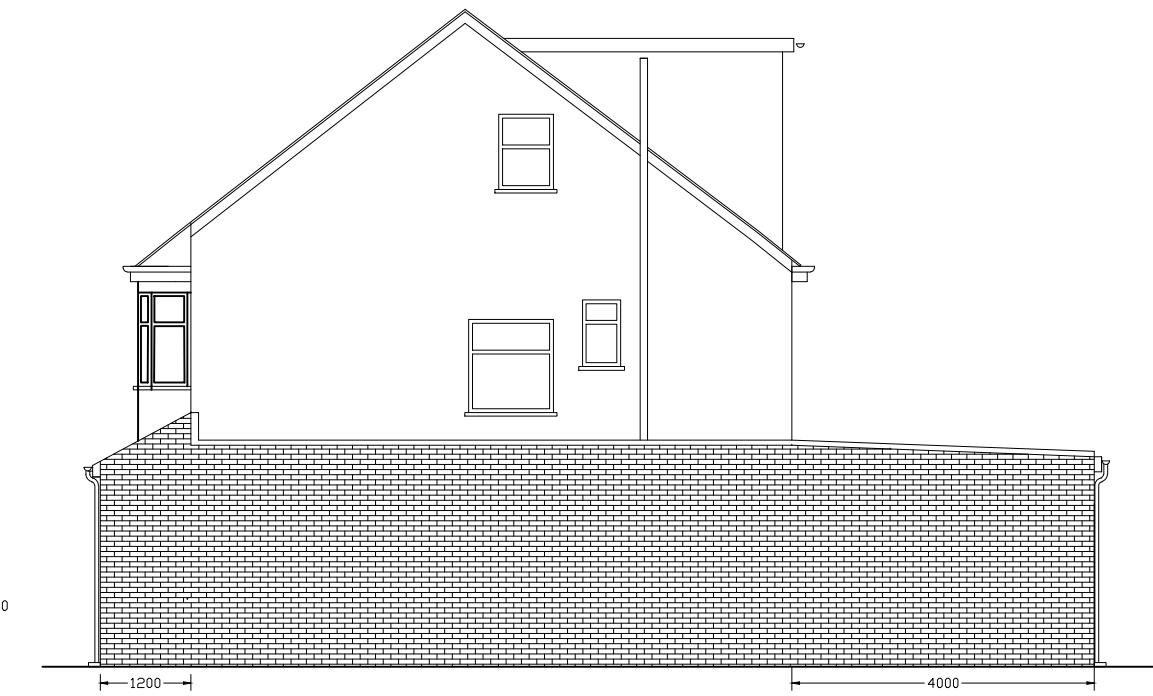


AS BUILT SIDE ELEVATION

- ALL FINISHES TO MATCH EXISTING.
- WALLS TO BE BUILT UP TO MATCH EXISTING.
- ALL NEW DOORS/ WINDOWS TO MATCH EXISTING.
- ROOF TILES TO MATCH EXISTING.
- RENDER & PAINTED FINISH TO MATCH EXISTING.
- ALL UNDERGROUND PIPE TO BE IN CLAY PIPES.



AS BUILT REAR ELEVATION

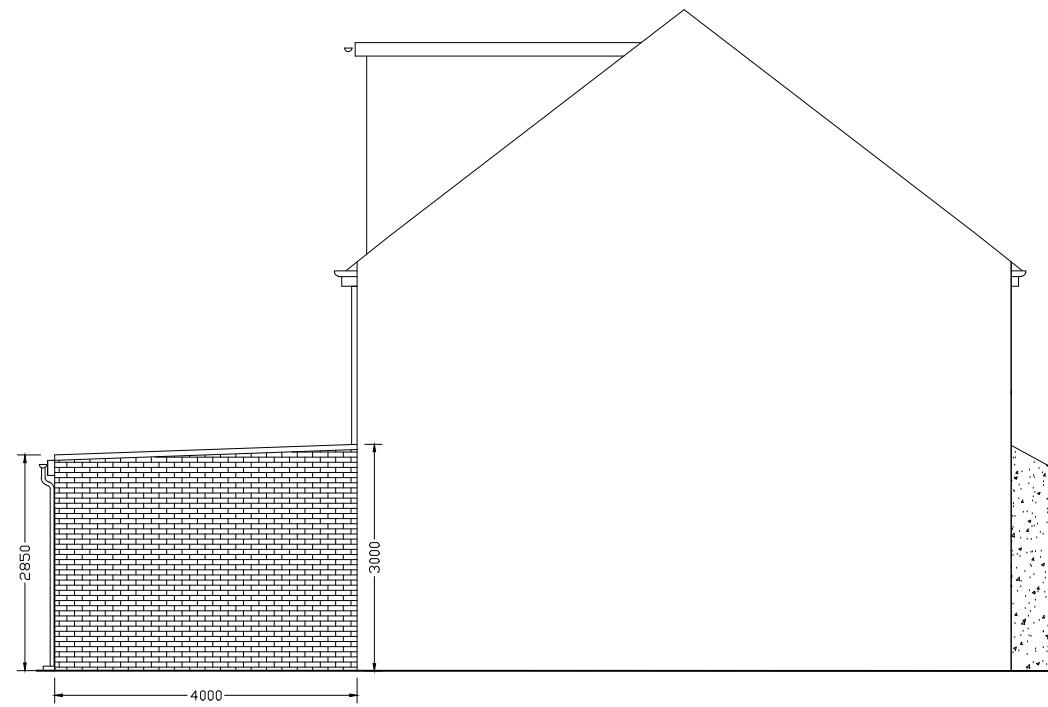

AS BUILT SIDE ELEVATION

REVISION:B	COUNCIL COMMENTS
REVISION:A	RETROSPECTIVE APPLICATION
PROJECT:	10 Barnhill Lane, Hayes, UB4 9HD
DRAWING:	Proposed Ground Floor Plan
SCALE:	1: 50. @A3
DATE:	DEC 2022
PAGE NO:	10 / P / 2022 - 03
STATUS:	PLANNING DRAWINGS

Ref: 77771/APP/2023/27

All dimensions to be checked on site prior to CONSTRUCTION.